

Mr. 03
H. 8

No. 1420 Multitubular Boiler for
Messrs A. Suijk (Holland) No. 257.

W. Pressure 175 lbs per sq inch

Scale 1" = 1 foot

Tested to Lloyd's Requirements


Shell Riveting

1 1/2" holes 6 3/4" apart.

Heating Surface

Tubes	1306 sqft
Furnaces	146
6 Chambers	189
Tube Plates	57
Total	1698 sqft.

Material
all plates, rivets & stays
of steel. Tubes, uptake of iron.

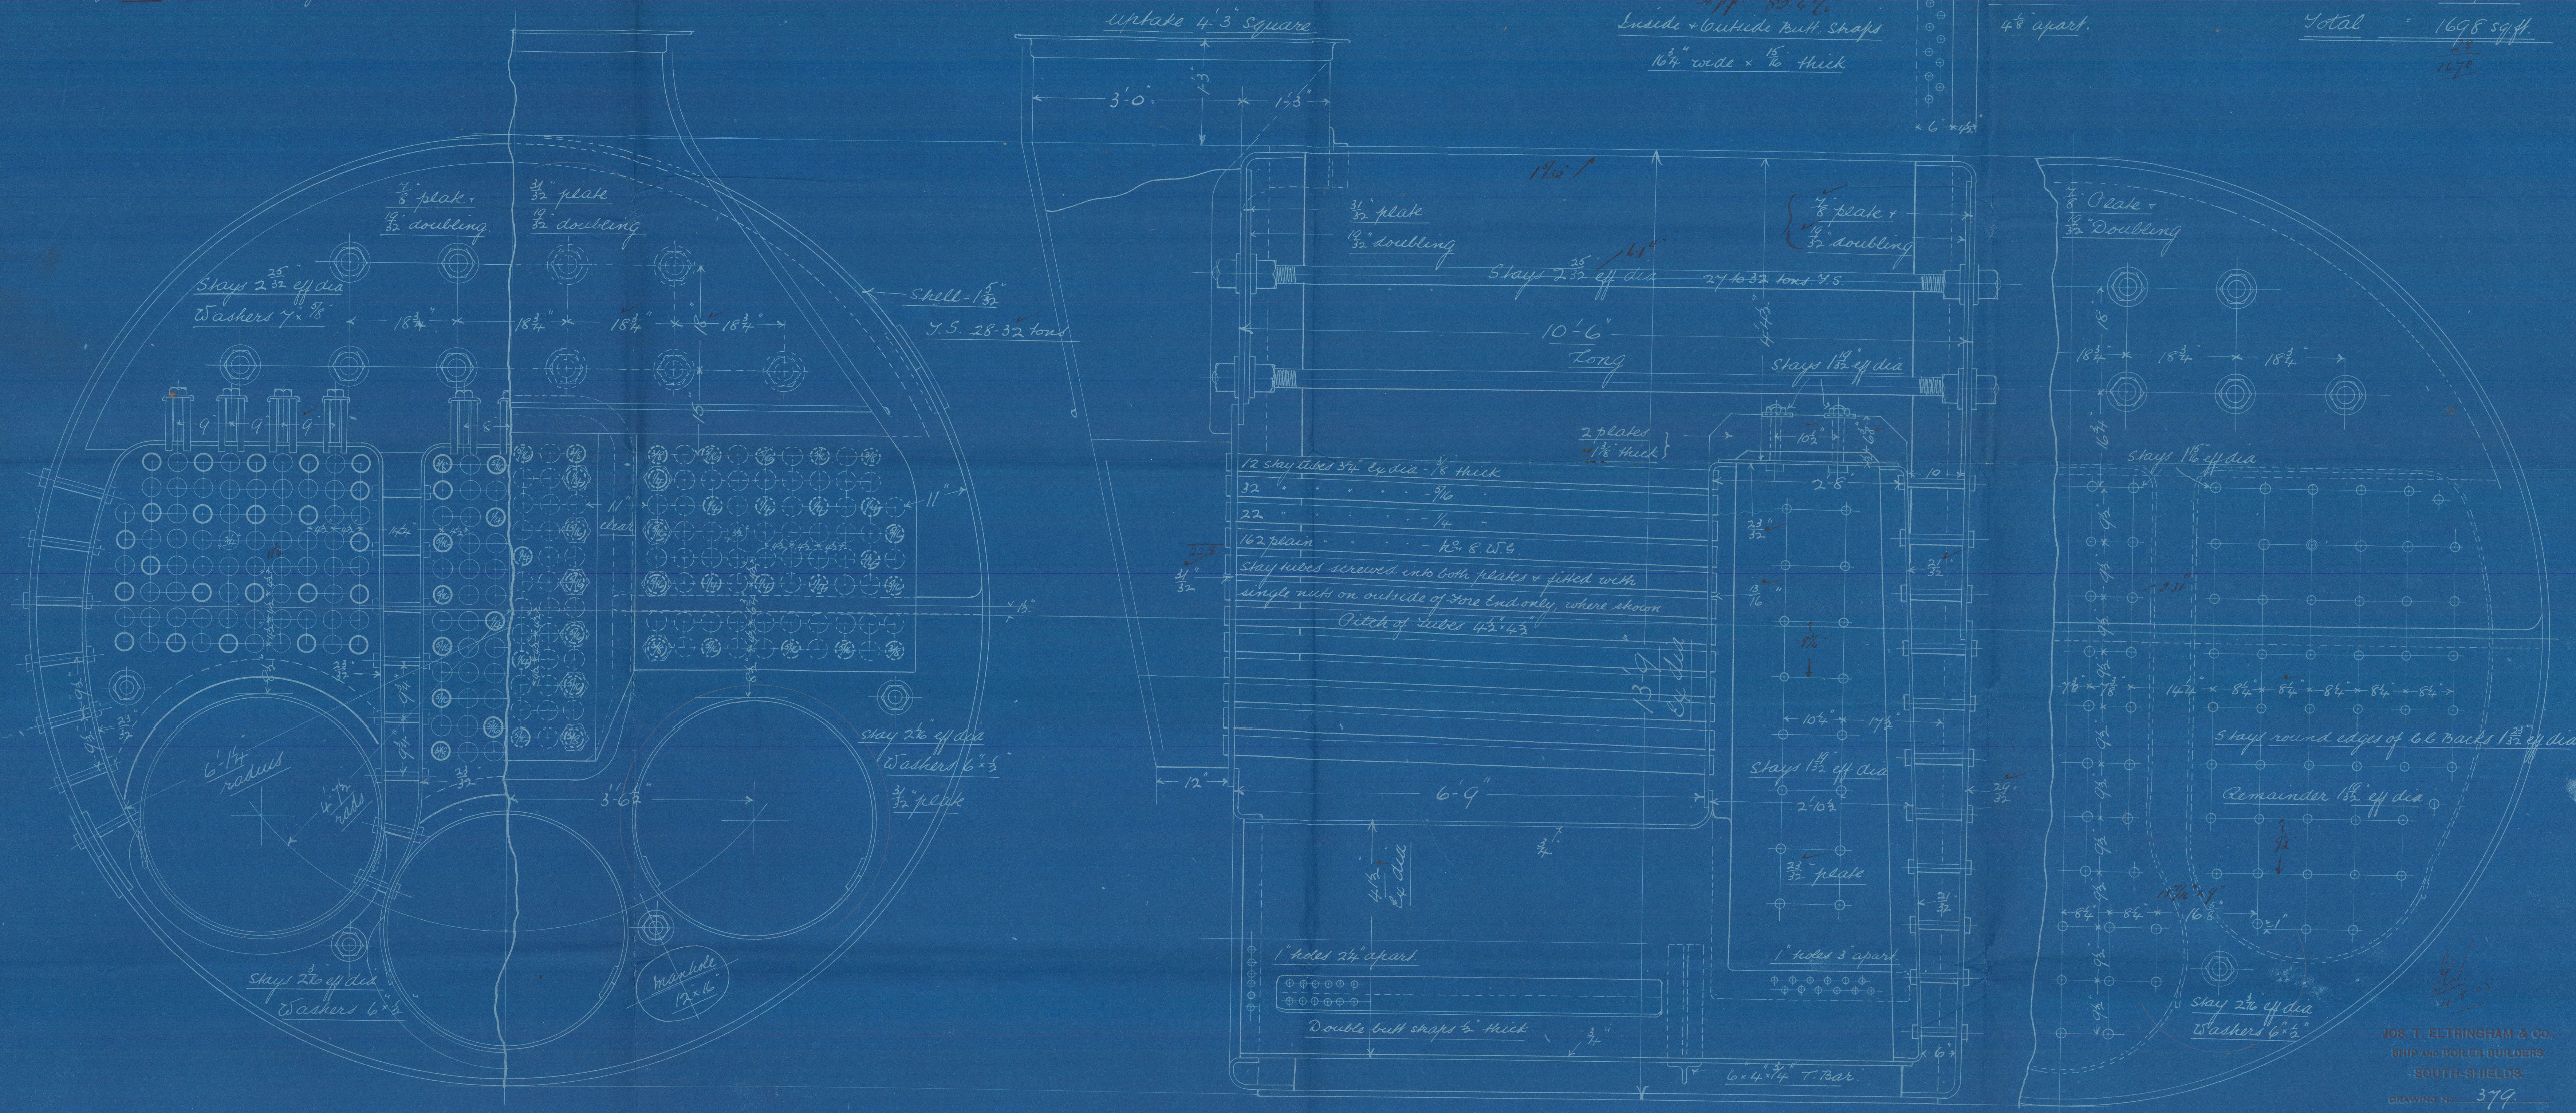

JOS. T. ELTRINGHAM & CO.,
SHIP AND BOILER BUILDERS,
SOUTH-SHIELDS.

DRAWING NO. 379
DATE 29-7-03

Newcastle

Messrs J. T. P. & Co. Ltd.

Order No. 1420


W. P. 175 u.

For.

Messrs A. V. & Co.
No. 257.

Mark.

no. 6725.
Lloyd's T. & Co.
1350 u.
26.1.04. W.L.

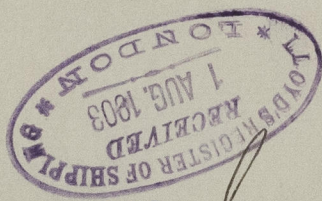

J. T. P. & Co.

(5) Newcastle Report

T. 28/32 No. 46-880

2021
3927

RETAIN



Lloyd's Register
Foundation
W1471 0045