
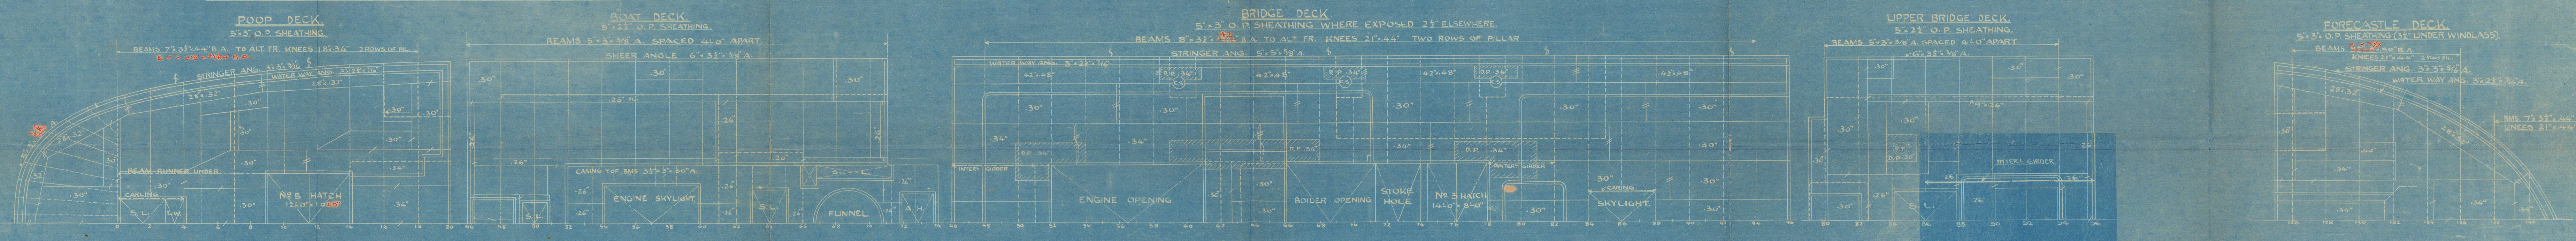


S.S. DUSHO MARU.



STRUCTURAL ARRANGEMENT

SCALE 1/8 IN. TO ONE FT.

SKETCH OF GIRDER BKT.
IN ALL GIRDERS BKT. ARE TO BE FITTED TO ALTERNATE
FRAME EXCEPT THOSE ALIGNED AS HATCH SIDE COAMING.

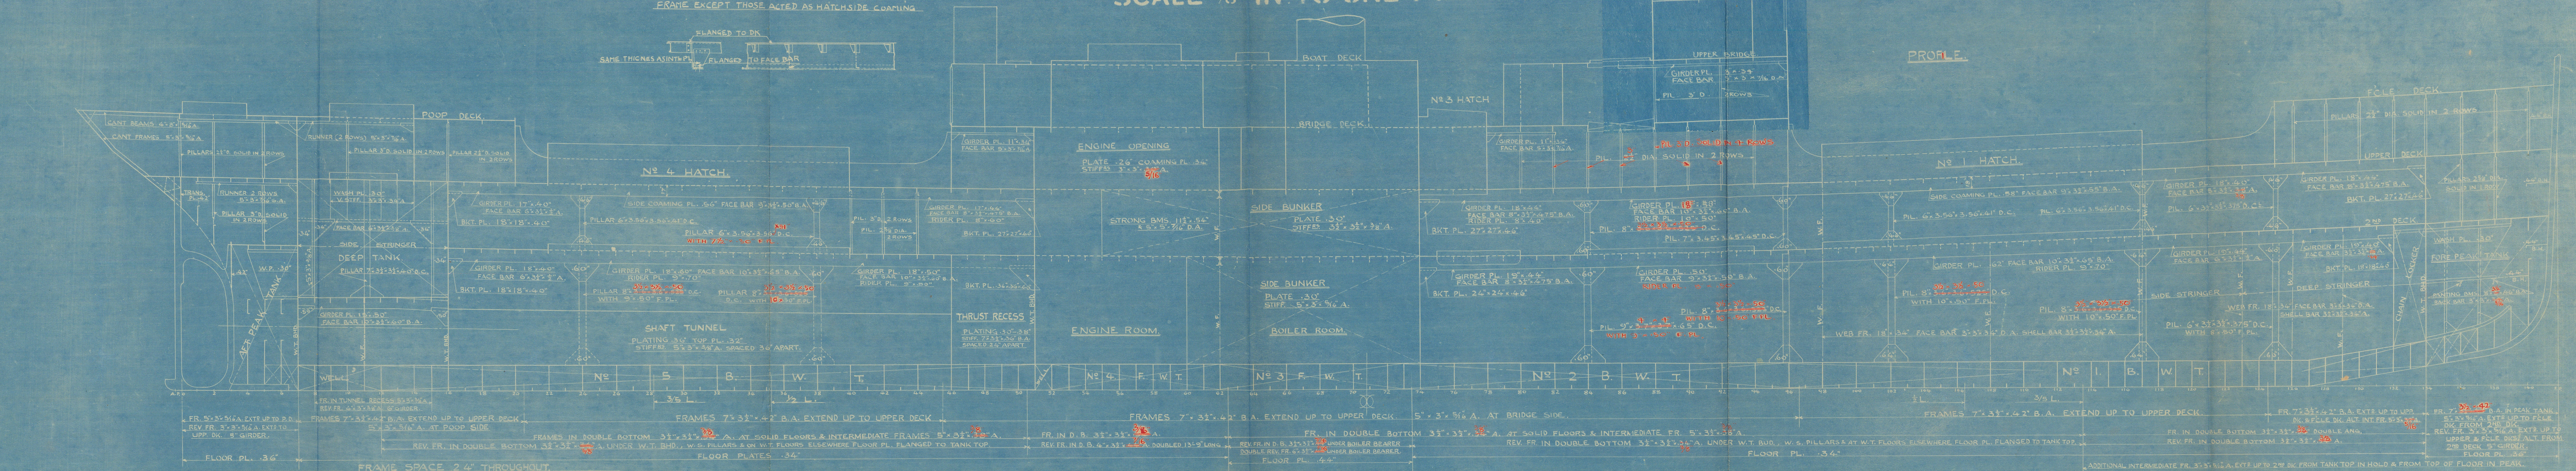

DECK BELOW VENTILATORS STIFFENED AS PER RULE.

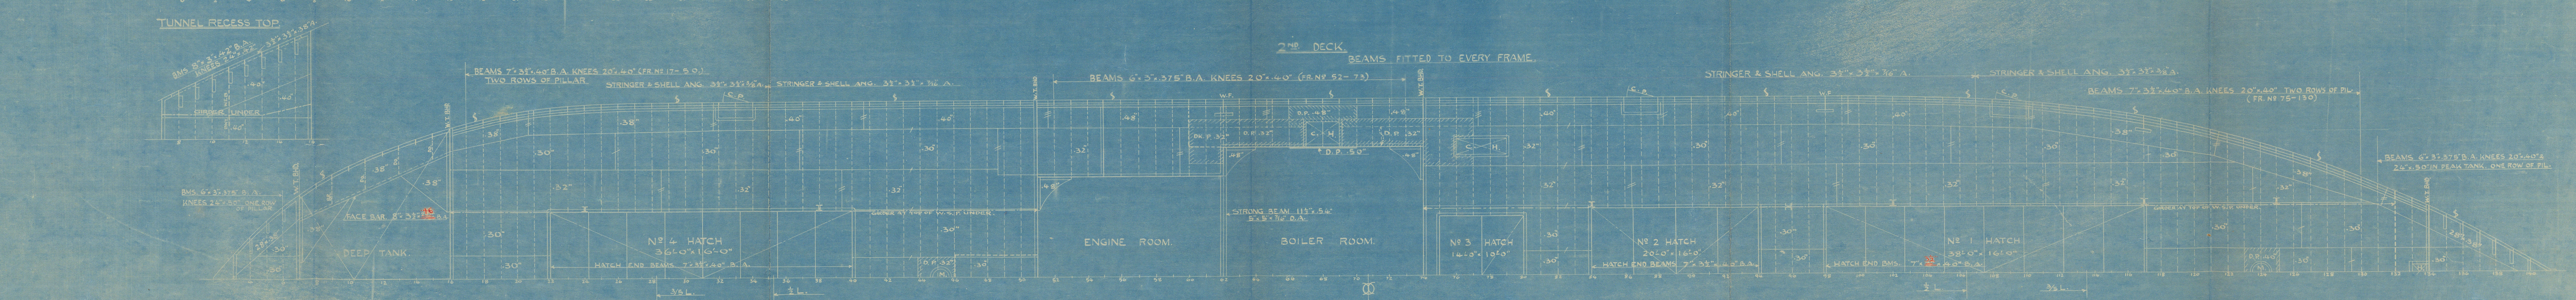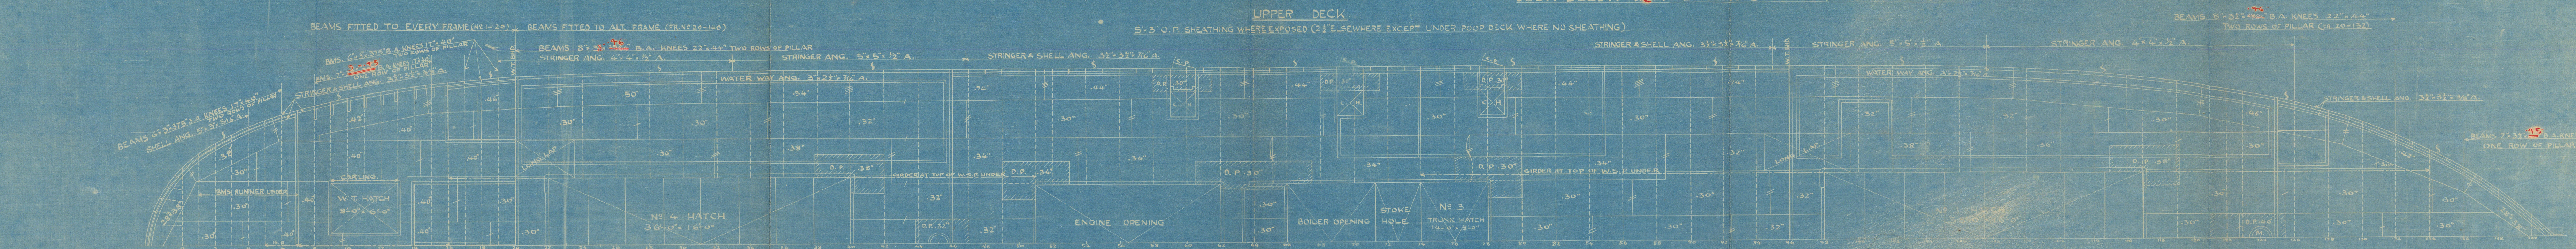

S S BUSHO MARU

STRUCTURAL ARRANGEMENT

Kob. 3183.



RETAINR

© 2021

Lloyd's Register
Foundation

W1471-0203