


DIMENSIONS.
LENGTH B.P. 345'-0"
BREADTH MLD. 50'-11 1/2"
DEPTH MLD TO MAIN DECK 27'-9 1/2"

S.S. "Benwood" (137 1/2%)
S.S. No. 137-8-9
LONGITUDINAL SECTION
SCALE 1/8" = 1 FOOT

For Quarter Tiders & Wide spaced
pillars see special approved plan

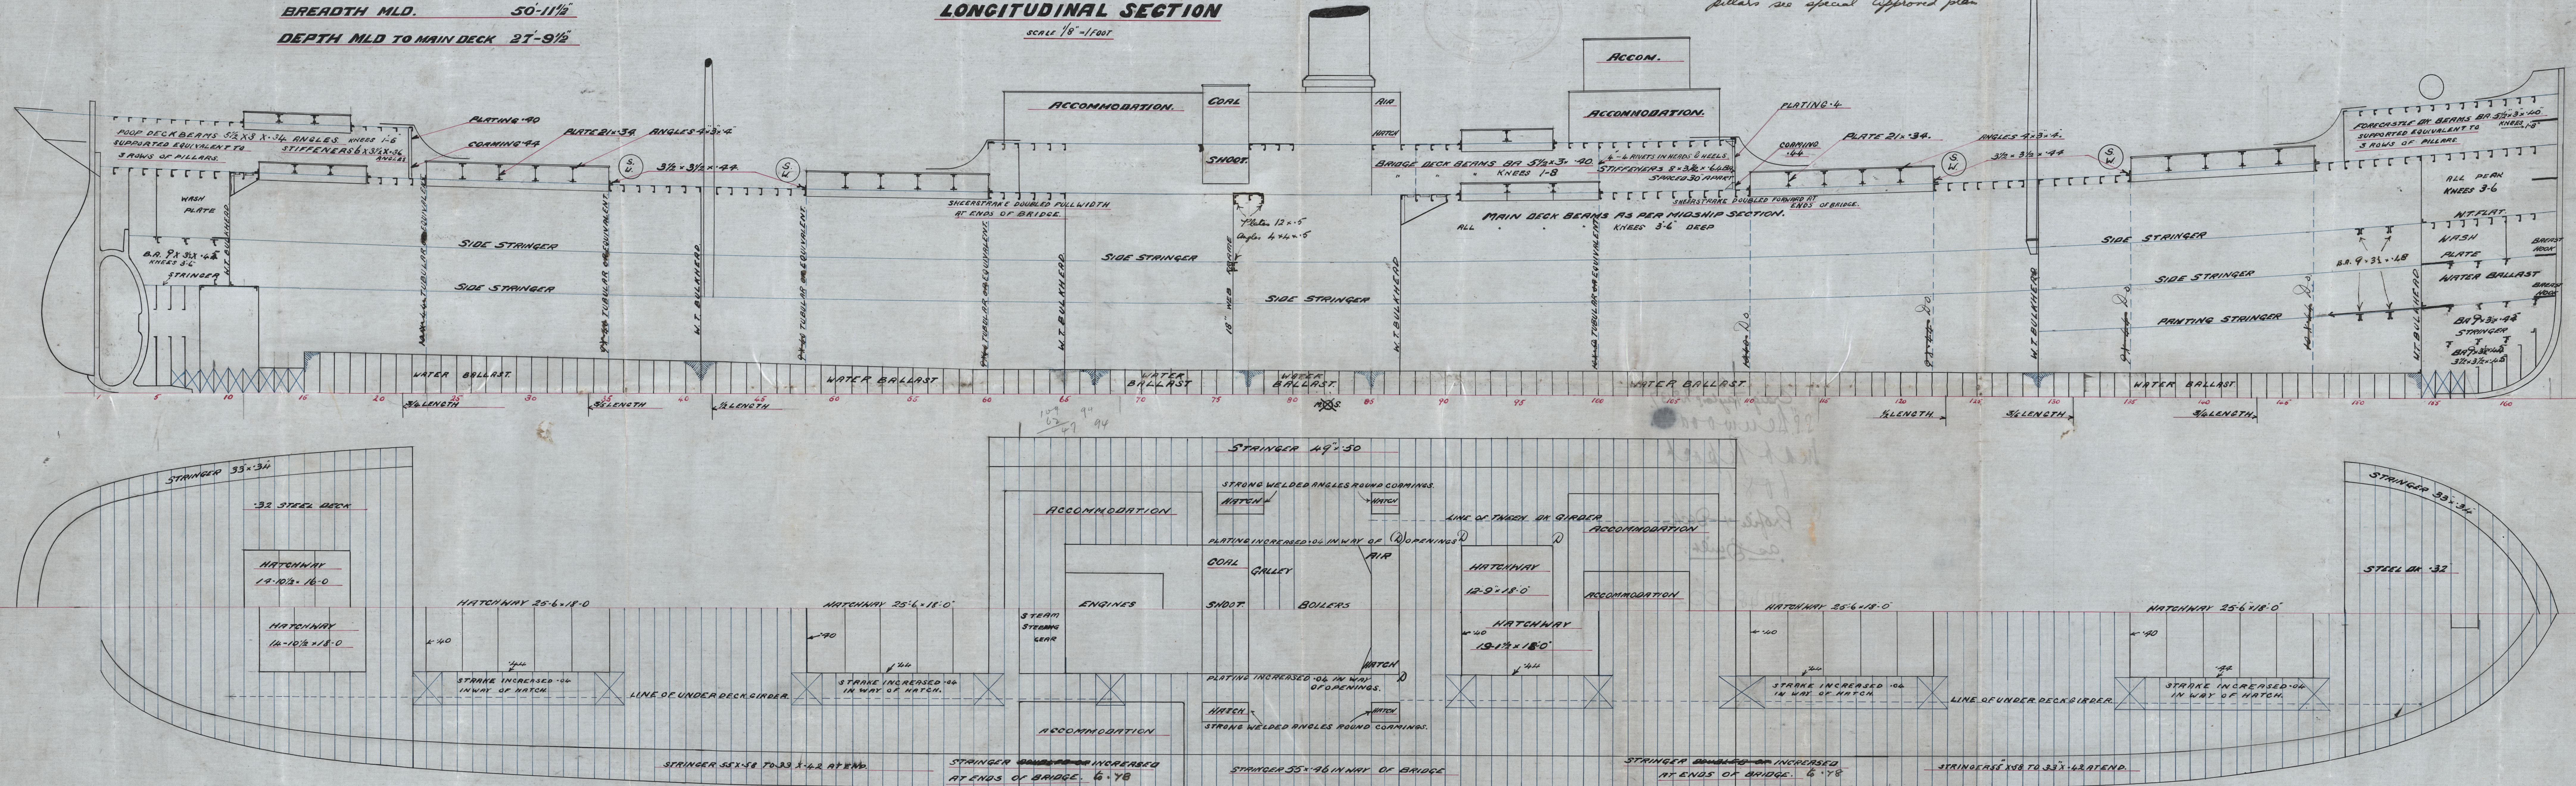

Craig Taylor? No. 137.
S.S. Benwood
Inst. Report
6081

Profile + Decks
as Built.

W1148-0021



© 2021

Lloyd's Register
Foundation