


SCALE $\frac{1}{8}" = 1 \text{ FOOT.}$

For Quarter Girders & Wide spaced Pillars
See Special Approved Plan.

DIMENSIONS

LENGTH B.P.	345' 0"
BREADTH MLD	50' 11 1/2"
DEPTH MLD TO MAIN DECK	27' 8 1/2"

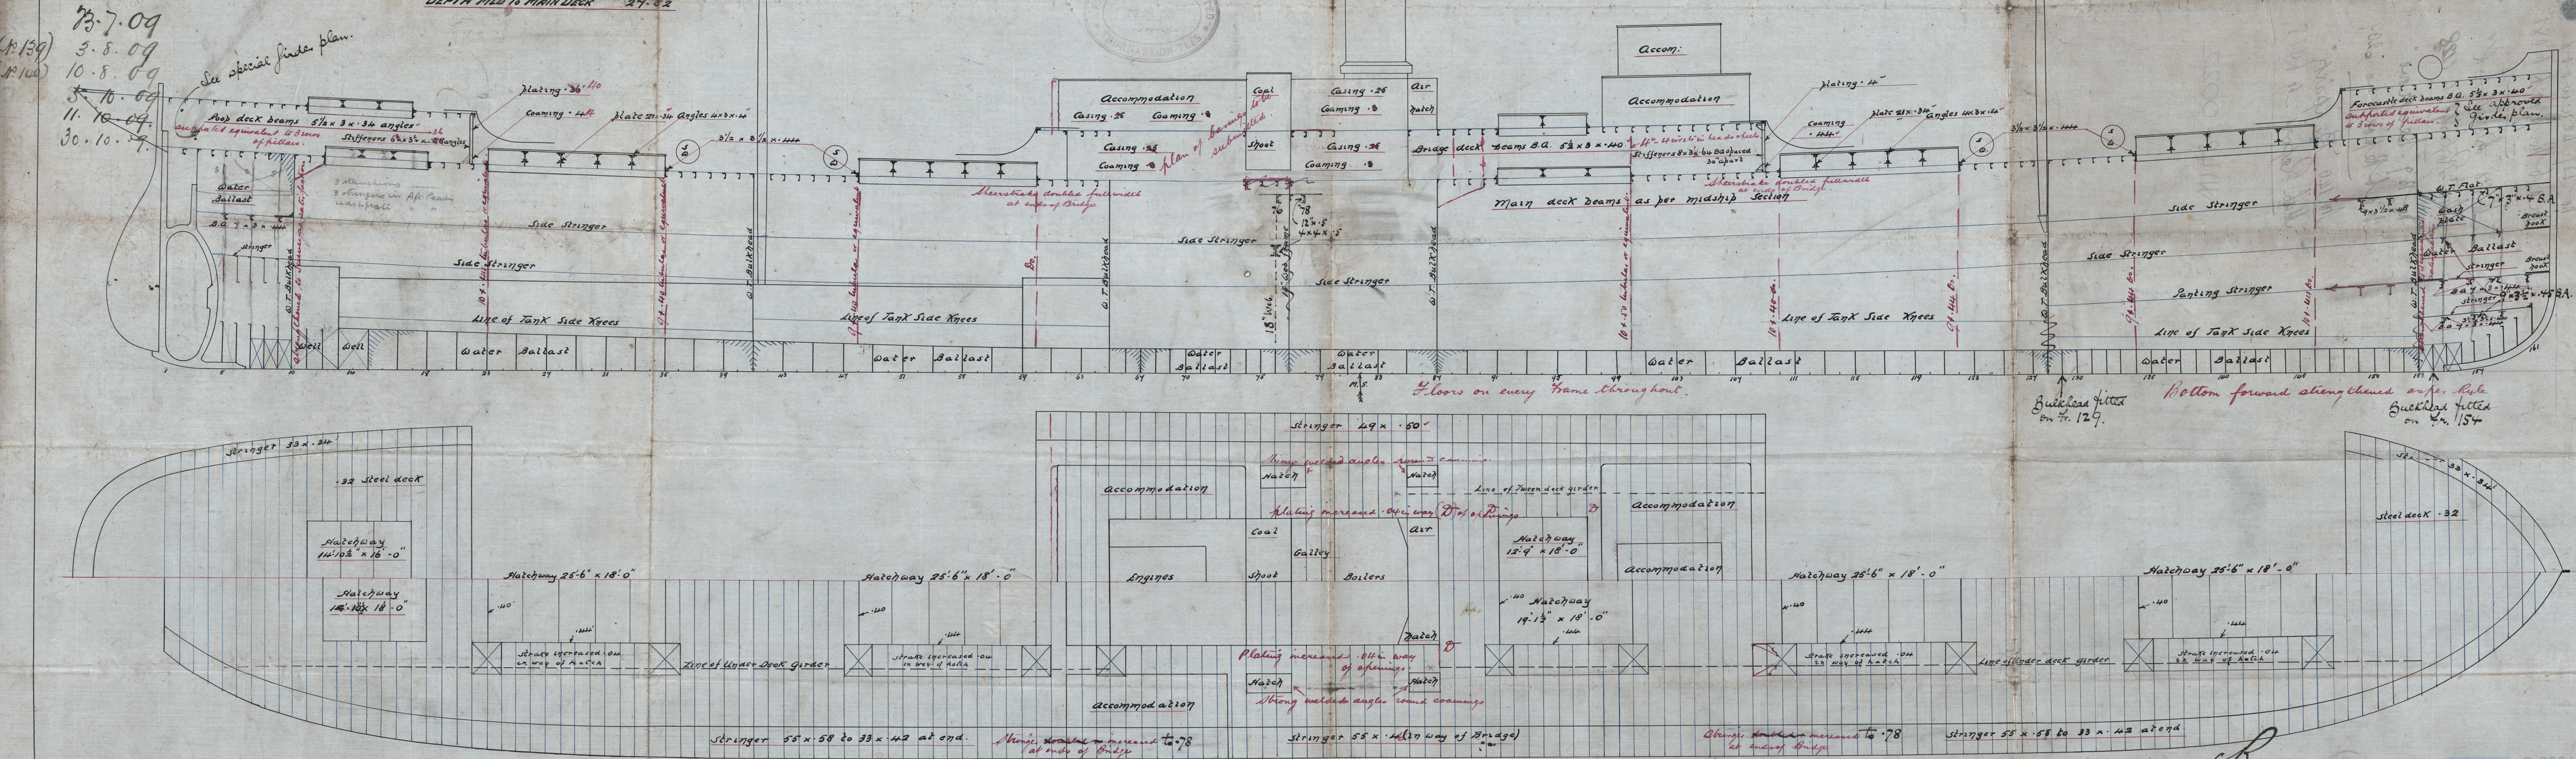

C.B.
23.7.09.

Craig, Taylor & Co

No 137-8-9-40

Profile & Deck Plan

No 137: Benwood
Mar. Report No. 6081

No. 138 Benbrook
Mar. Report No. 6128

No 139 Benstone
Mar. Report No. 6209

No. 140 Benpart
Mar. Report No. 6418

W1148-0022



© 2021

Lloyd's Register
Foundation