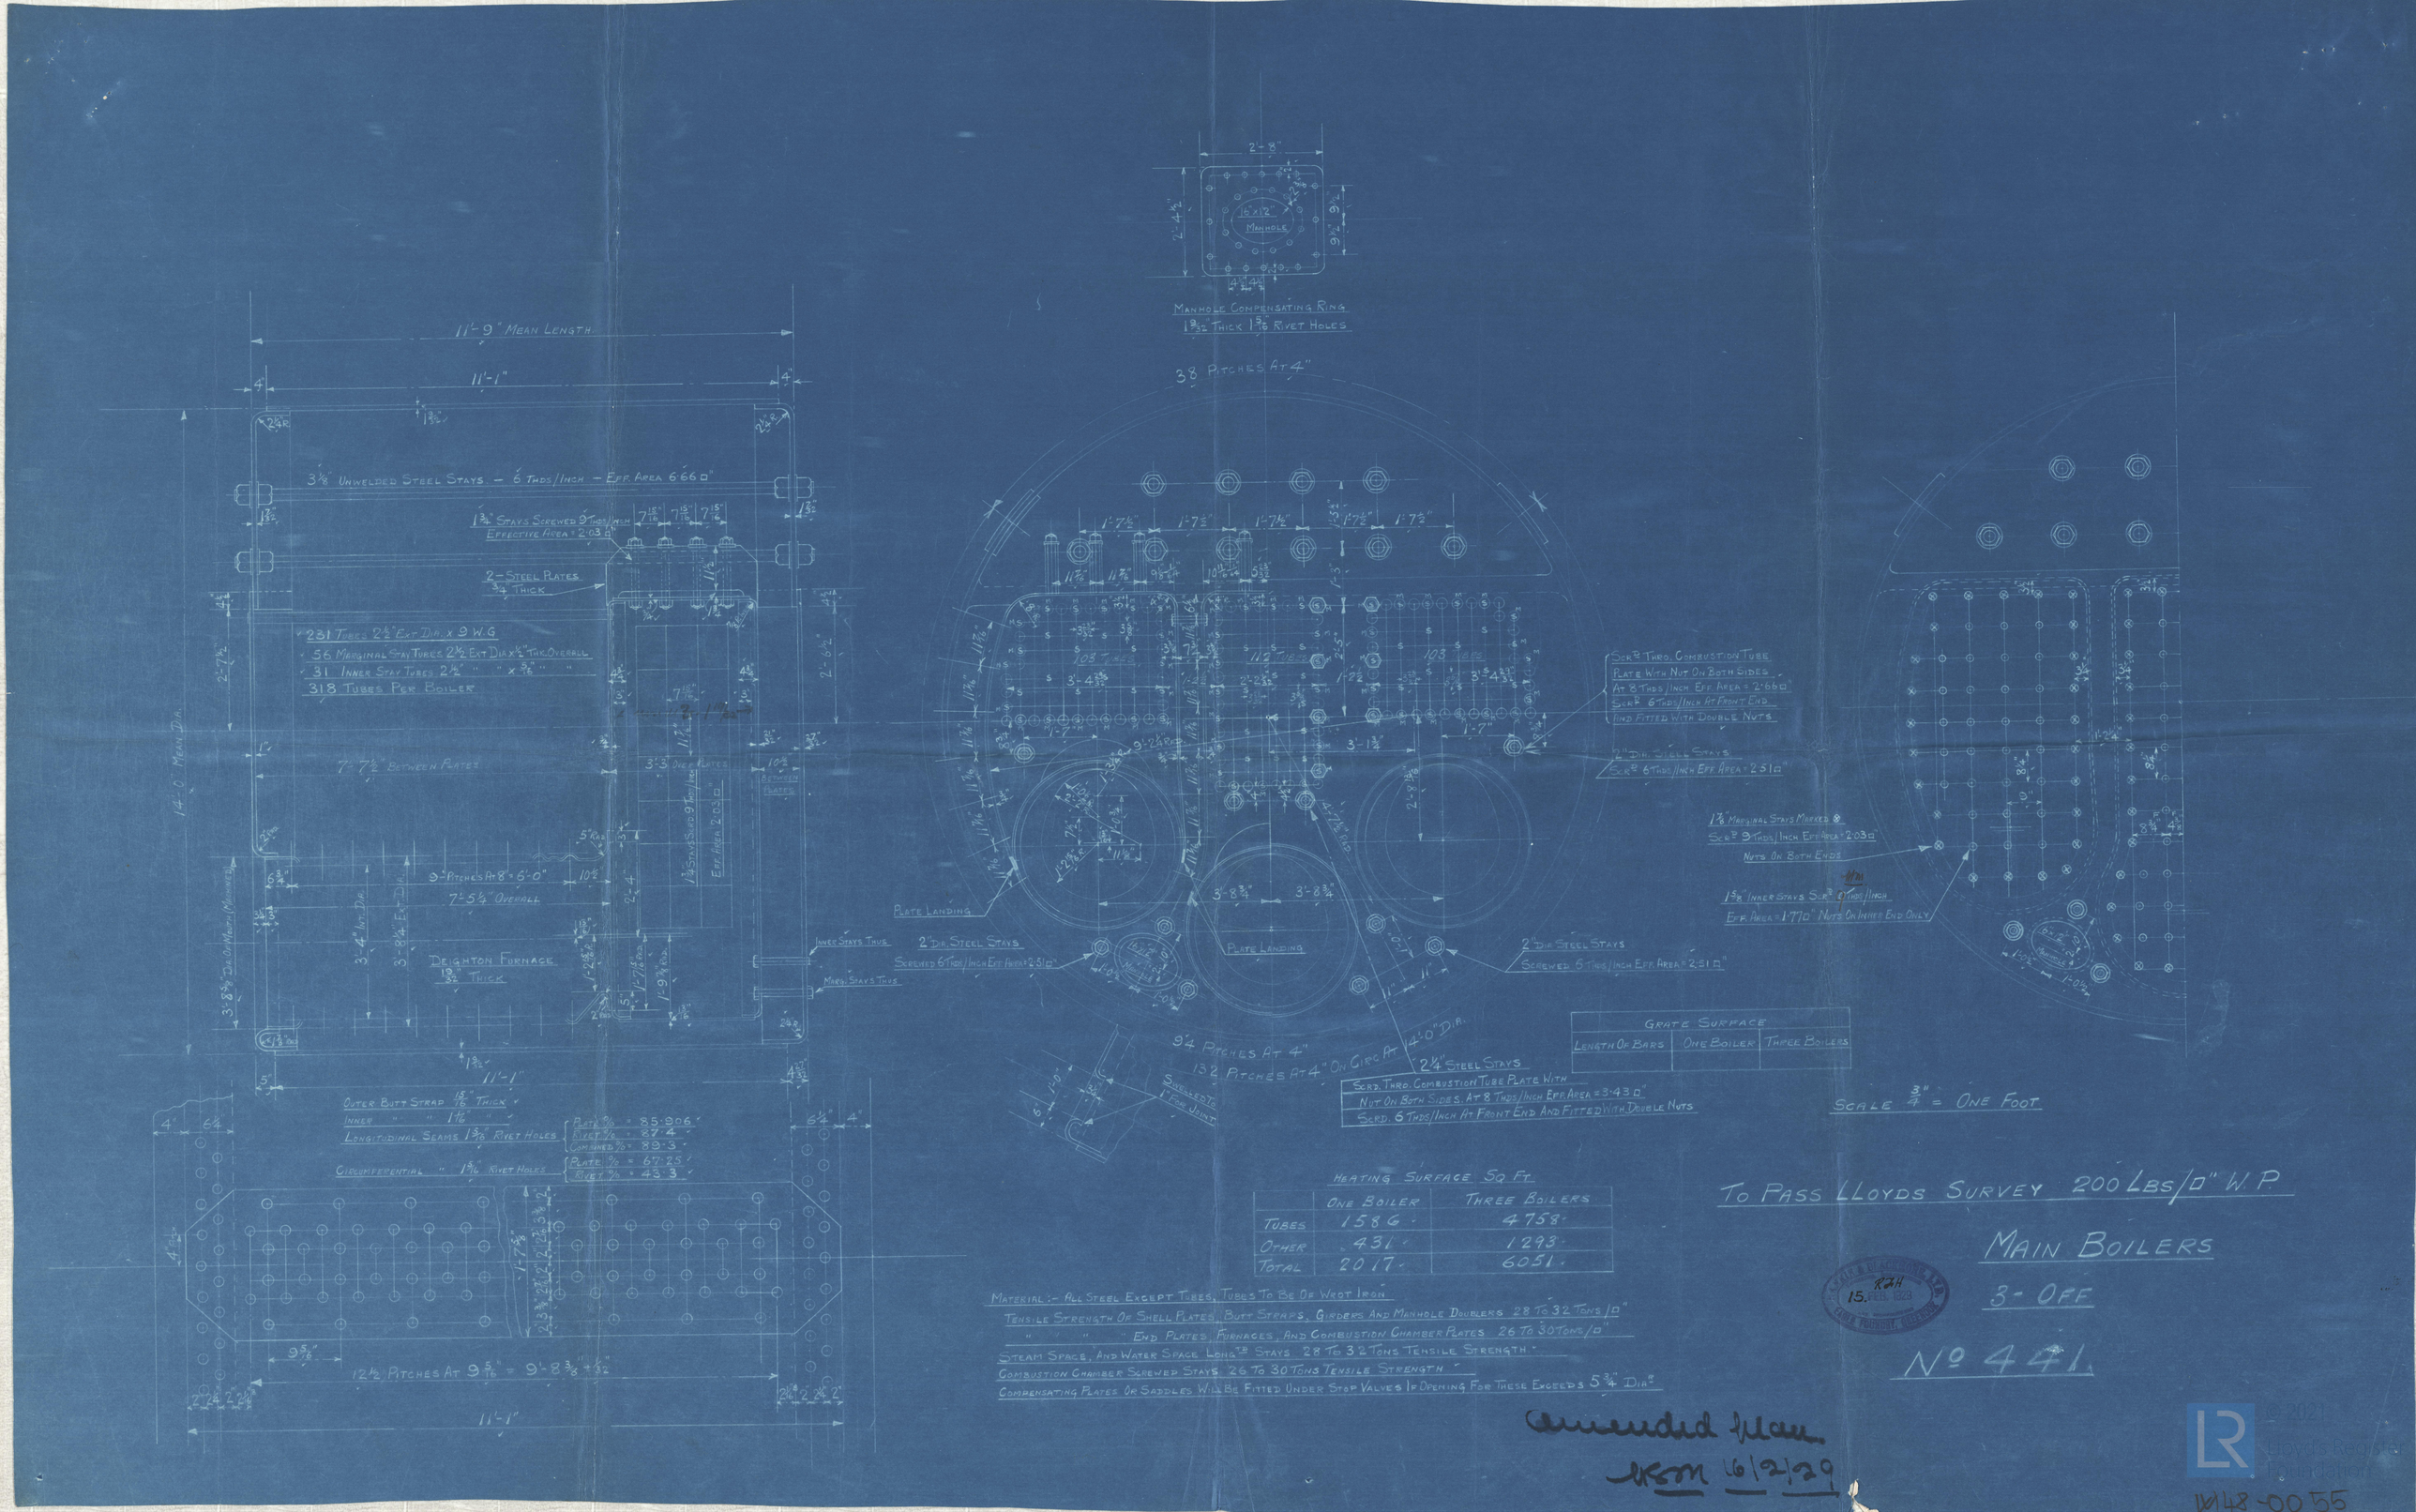

Grate Surface		
Length Of Bars	One Boiler	Three Boilers

Heating Surface Sq Ft

	One Boiler	Three Boilers
Tubes	1586	4758
Other	431	1293
Total	2017	6051

Material:- All Steel Except Tubes, Tubes To Be Of Wrot Iron
Tensile Strength Of Shell Plates, Butt Straps, Girders And Manhole Doublers 28 To 32 Tons/□"
" " " End Plates, Furnaces, And Combustion Chamber Plates 26 To 30 Tons/□"
Steam Space, And Water Space Long^th Stays 28 To 32 Tons Tensile Strength
Combustion Chamber Screwed Stays 26 To 30 Tons Tensile Strength
Compensating Plates Or Saddles Will Be Fitted Under Stop Valves If Opening For These Exceeds 5 3/4" Dia^r

To Pass Lloyds Survey 200 Lbs/□" W.P.

Main Boilers

3 - Off

No 441

Amended Plan
KSM 16/2/29

© 2021 Lloyd's Register Foundation
1048-0055