
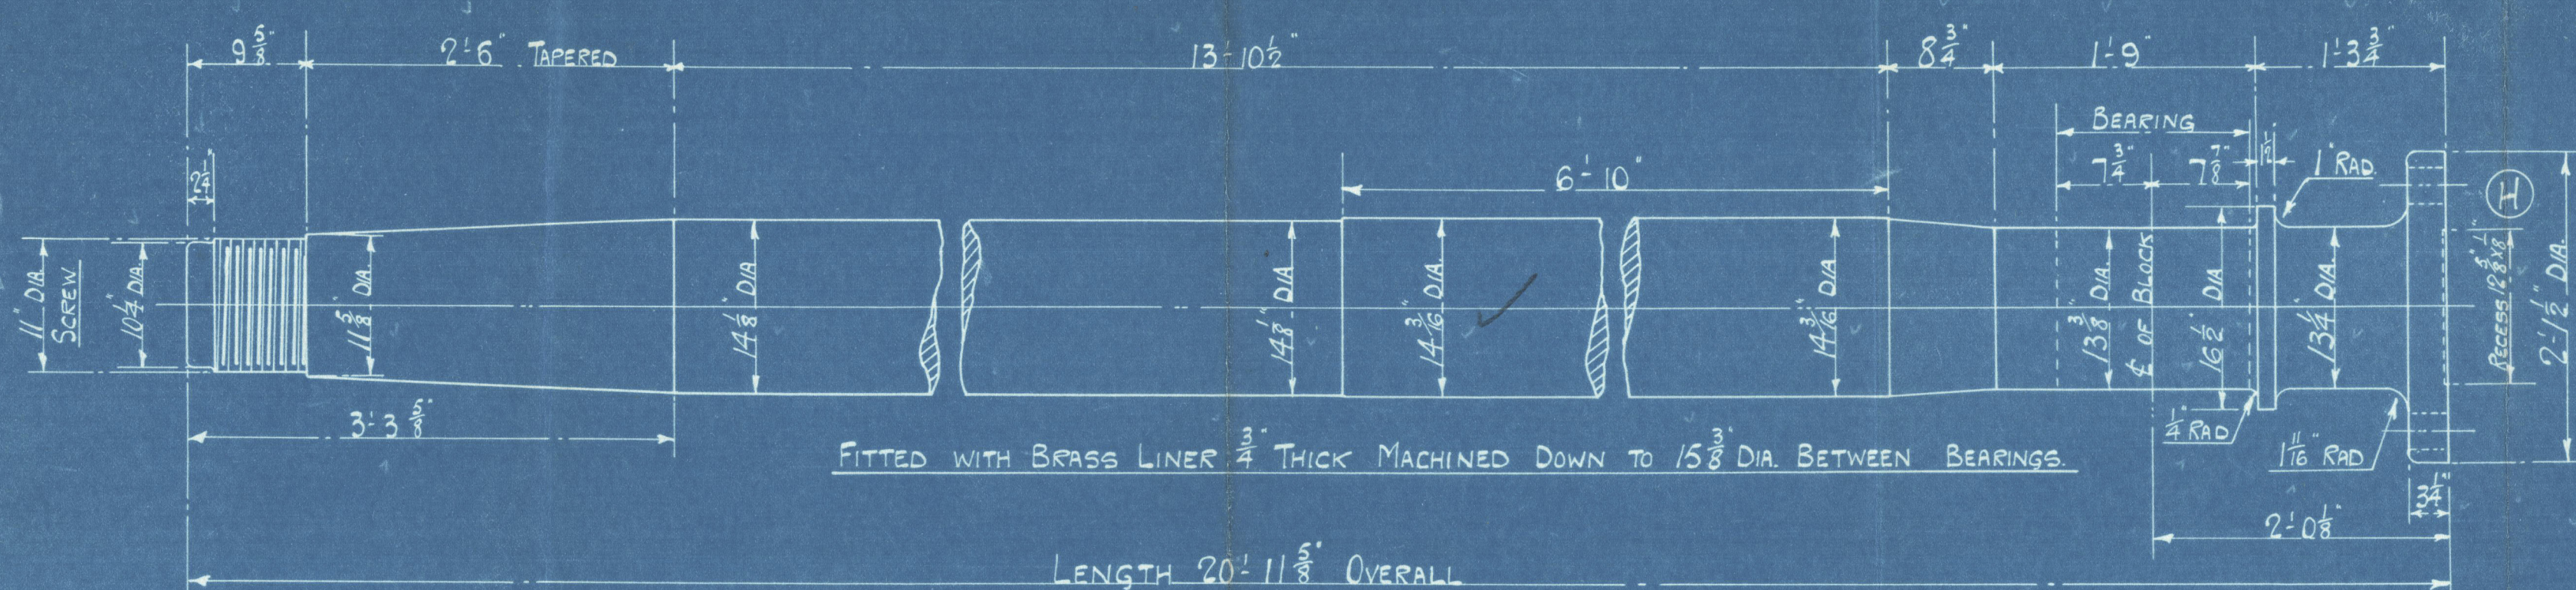
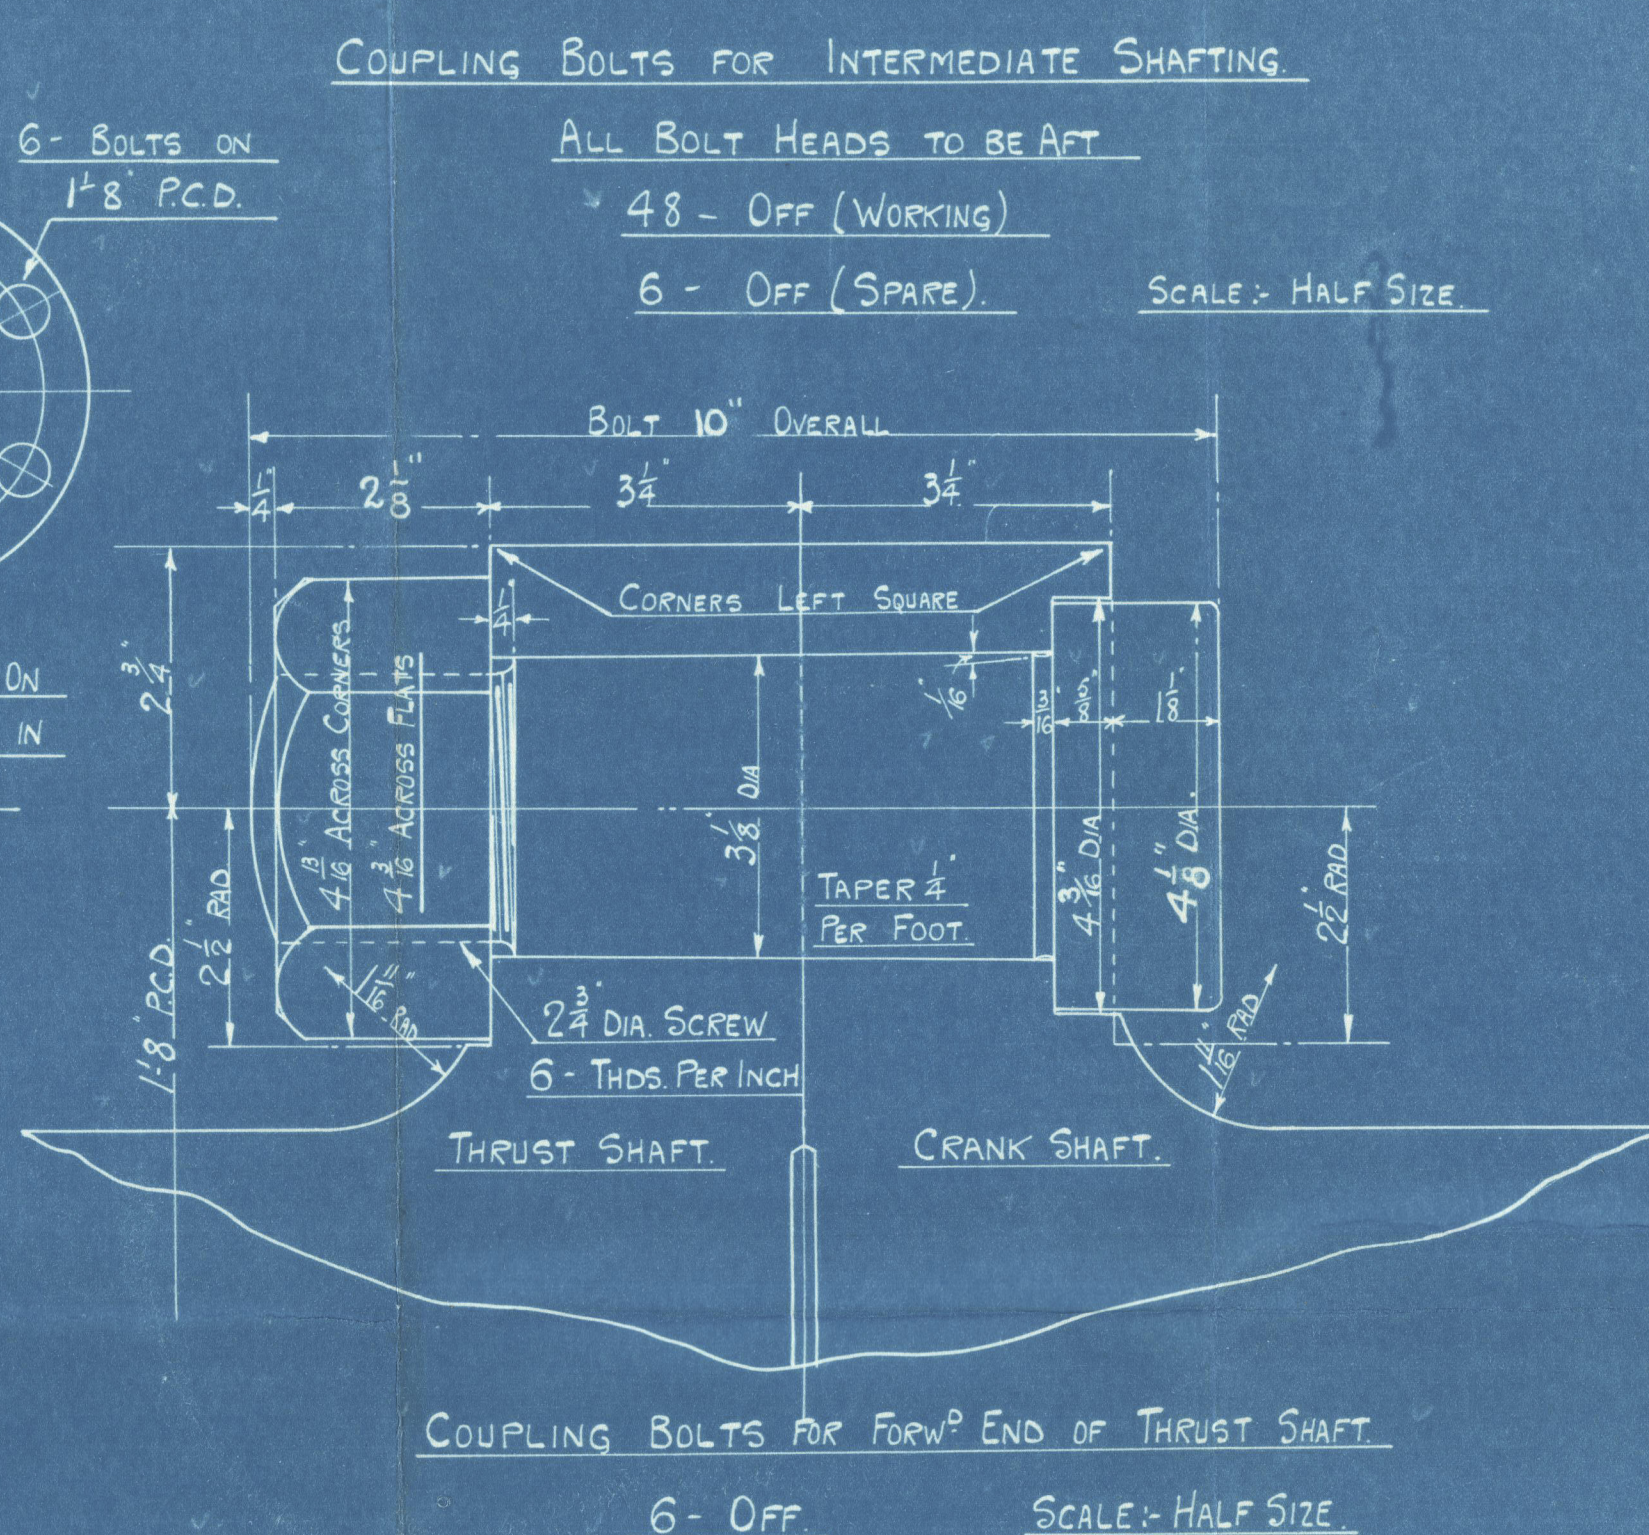
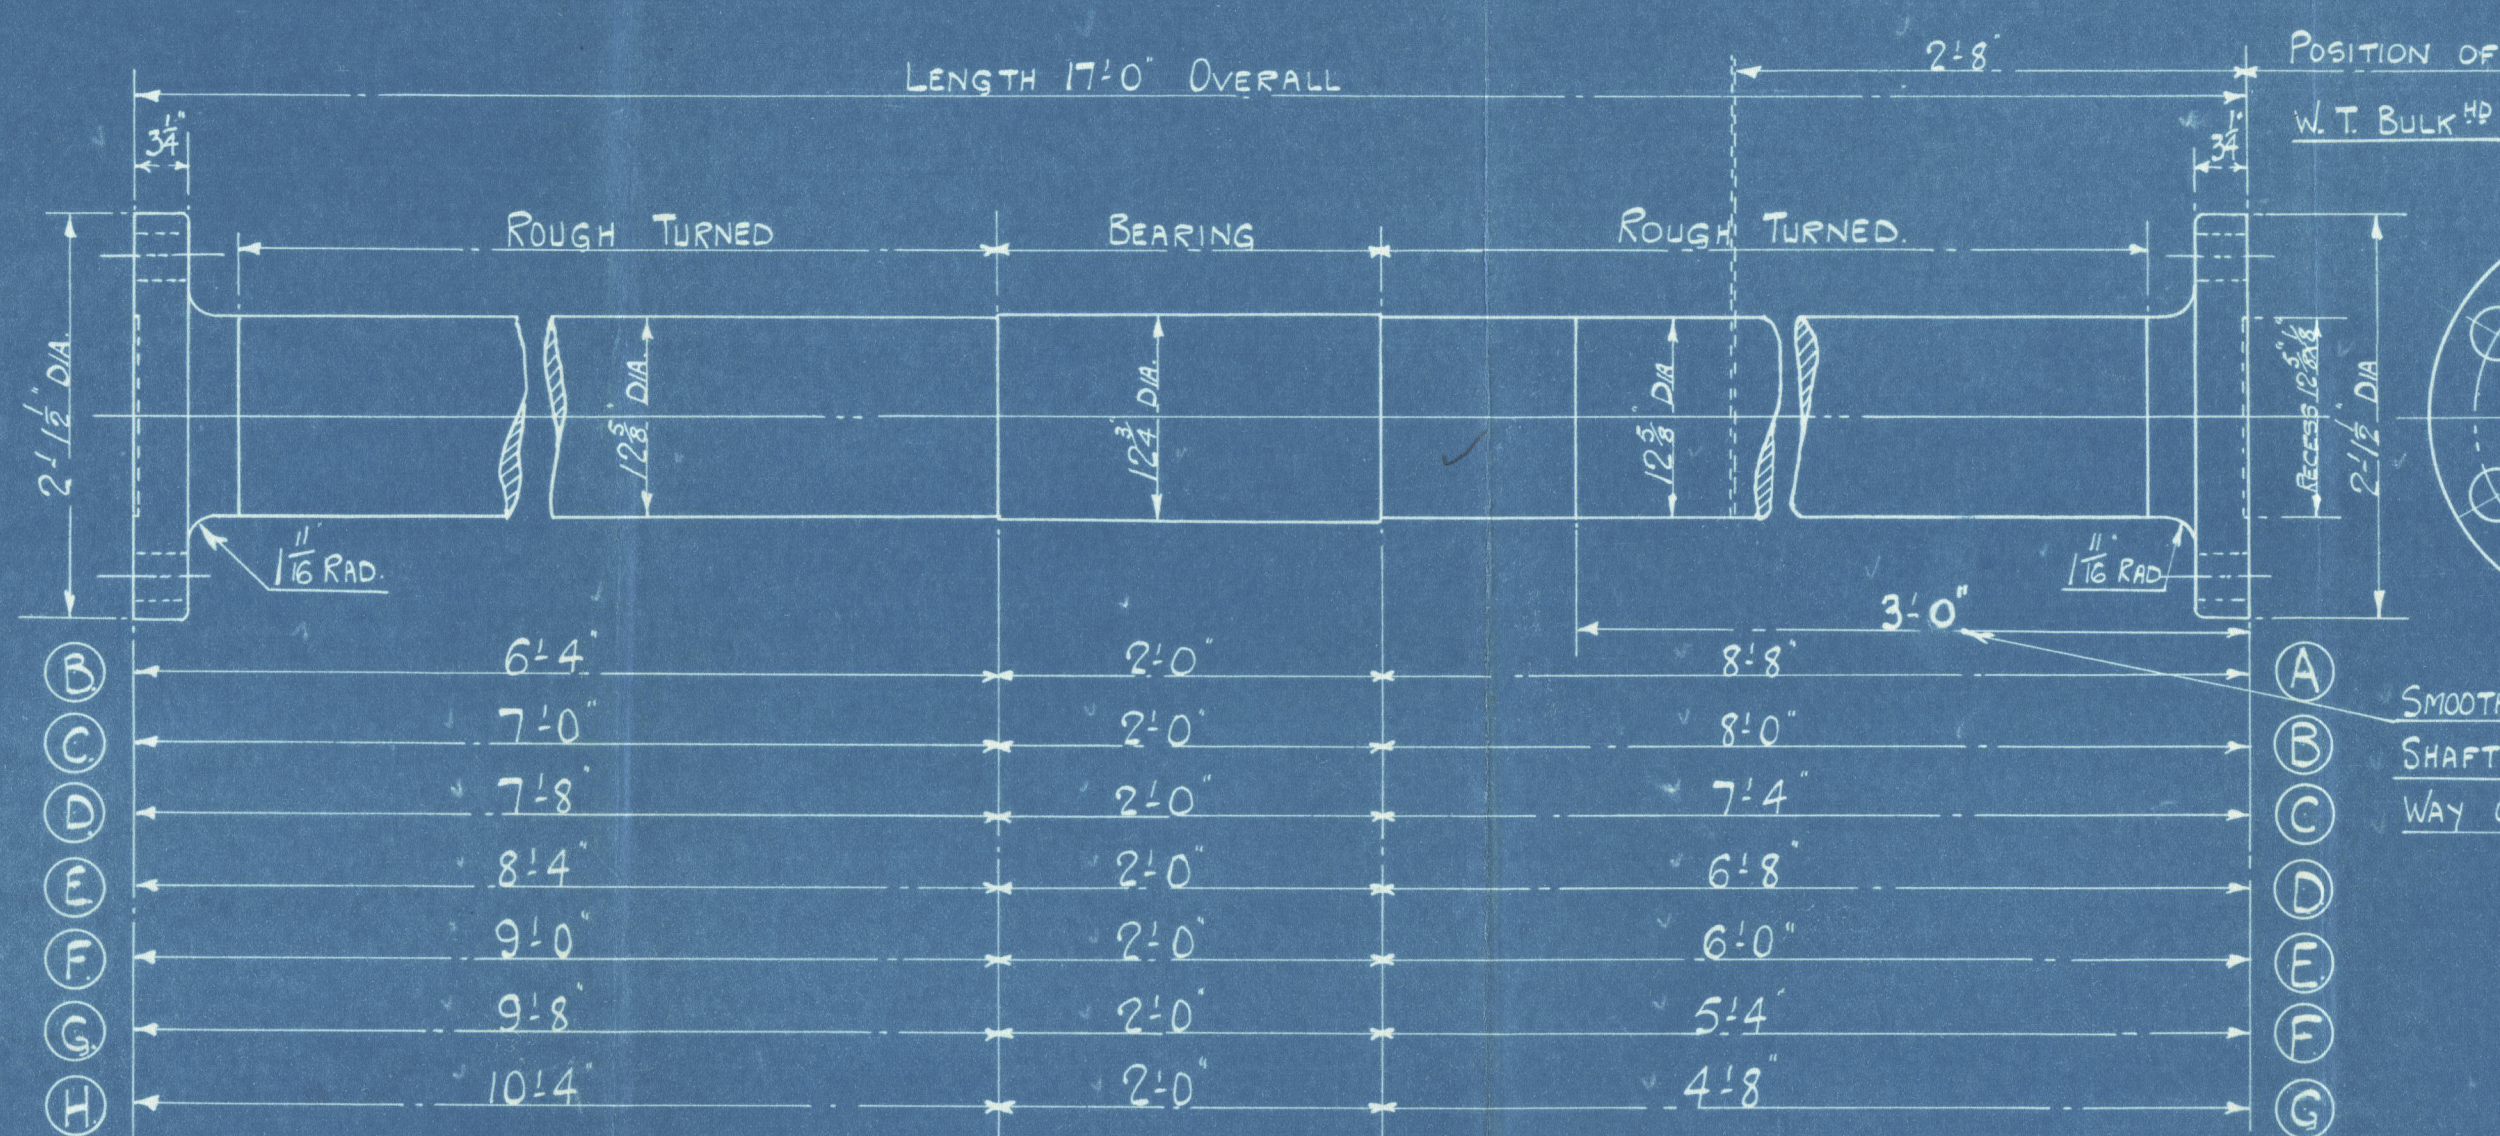
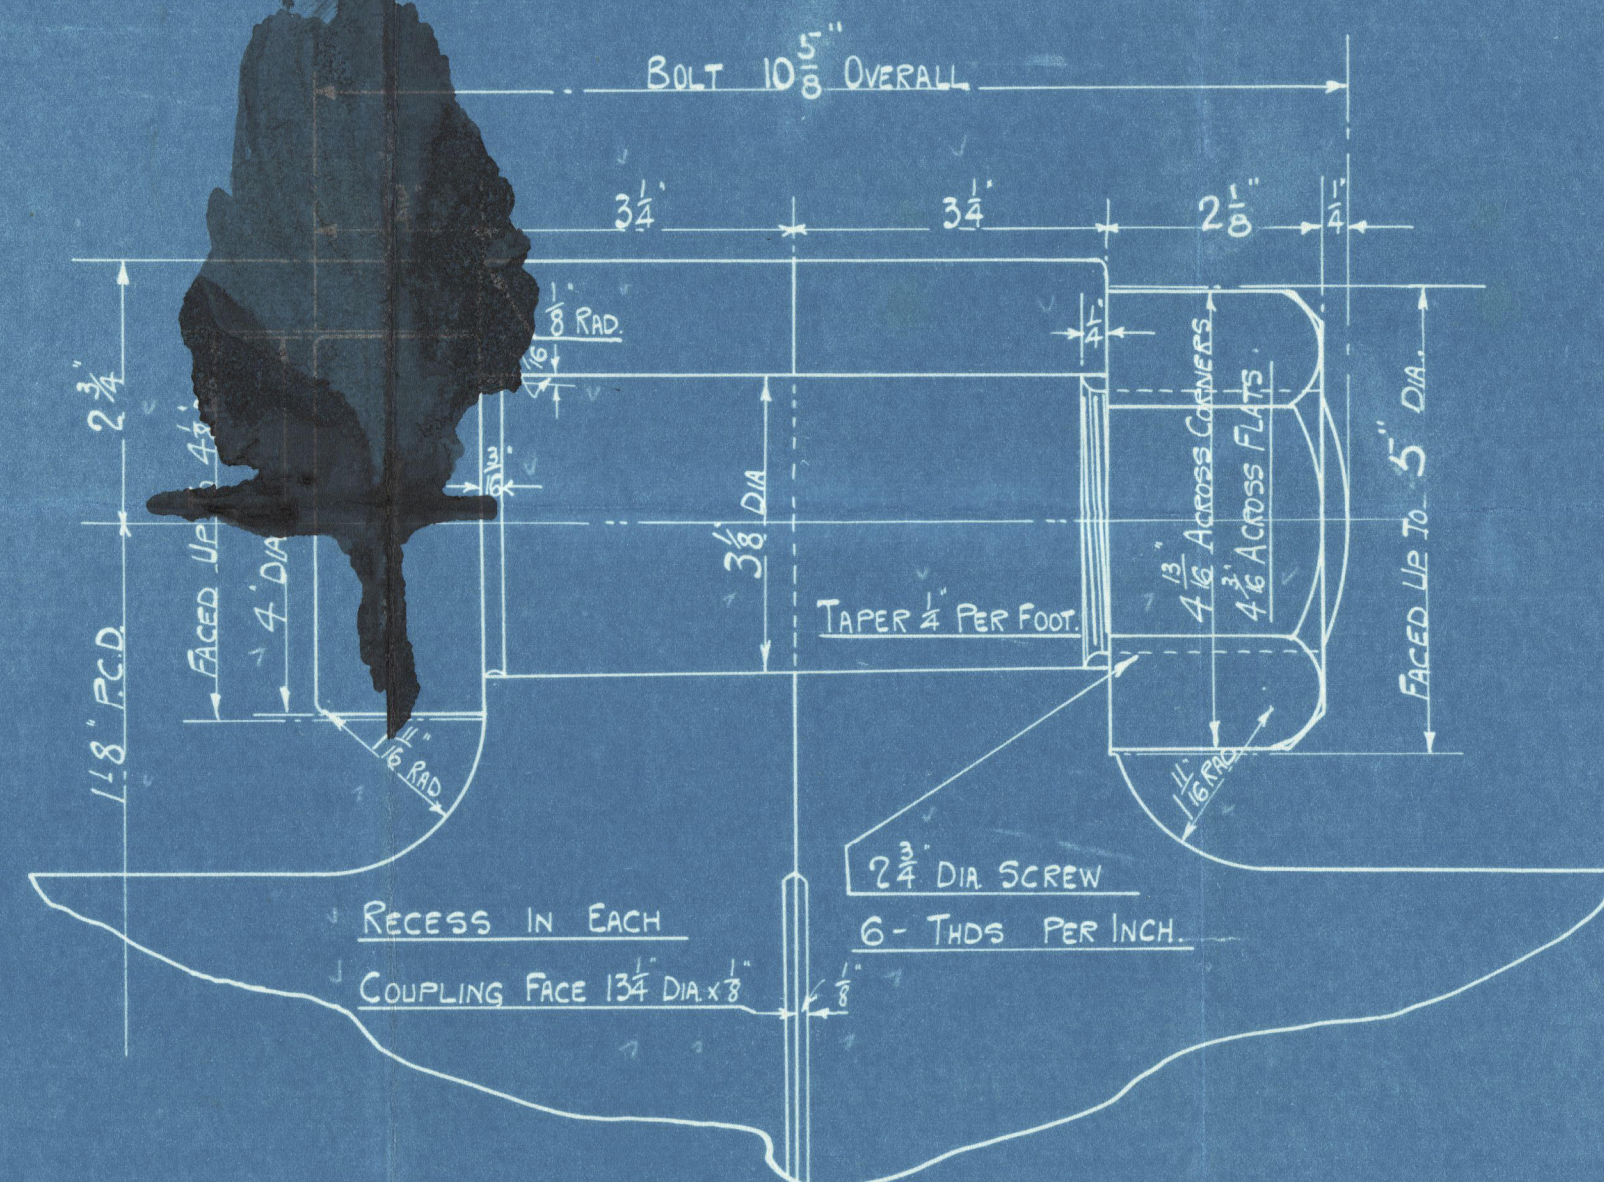


JOHN G. KINCAID & CO.
LIMITED
ENGINEERS
GREENOCK.

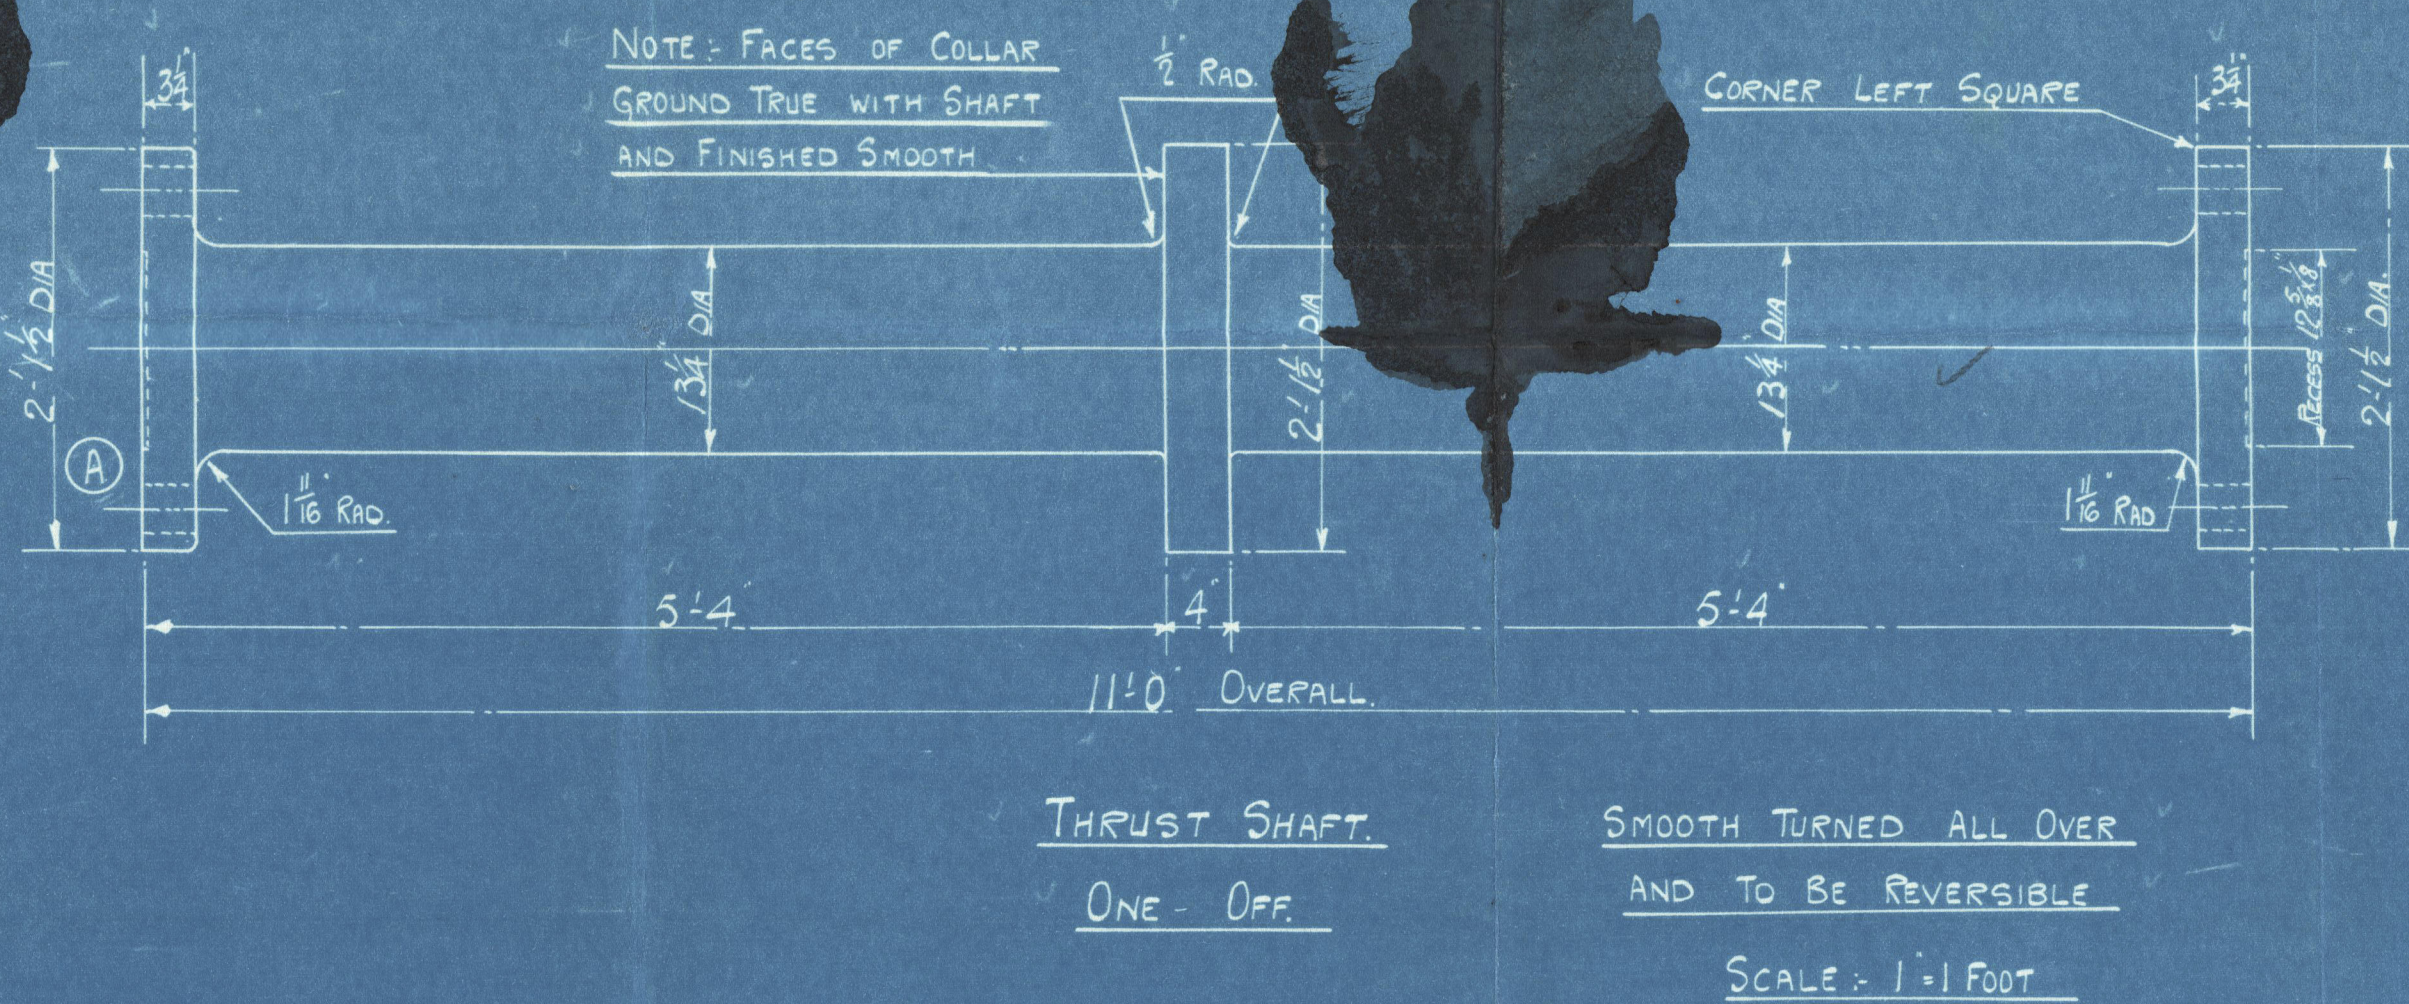

NOTE:-

COUPLING BOLT HEADS TO BE AFT FOR ALL
COUPLINGS, EXCEPT FORWARD END OF THRUST
SHAFT. COUPLINGS OF ALL SHAFTS ARE TO BE
LETTERED FROM FORWARD TO AFT AND FITTED
AS SHOWN ON SHIP ARRANGEMENT PLAN.

SHAFTS TO PASS LLOYD'S REQUIREMENTS AND TESTS.

SHAFTING.

ENGINE No 623.

John G. Kincaid & Co. Ltd.
(Incorporated in U.K.)
2, 3, 4,1000.


SCALES: AS SHOWN.

28TH FEBRUARY 1923.

D.R.C. No 3813

W 148-0080

Kincaid 623
Shafting

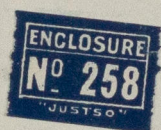

S.A. Barrdale.

Ask. Report No. 18479.

JOHN G. KINCAID & CO. LTD.
(DRAWING OFFICE)

2 MAR 1925

ENGINEERS & BOILERMAKERS,
GREENOCK.

W148 0080



© 2021

Lloyd's Register
Foundation