

SCALE $\frac{1}{2}'' = 1$ FOOT.

Workman Clark & Co.

SS 234.



REVISED

MIDSHIP

SECTION.

JAPAN

BEL 6184

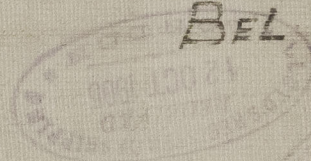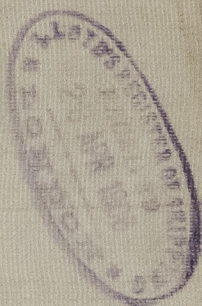

W1480 — 0017



© 2021

Lloyd's Register
Foundation