

14.11.05

MIDSHIP SECTION

STEEL SCREW TRAWLER.

N^o 360.

LENGTH B.P. 128'-4" x 22'-0" EX x 12'-0" DEPTH OF HOLD.

SCALE 1/2" = 1 FOOT.

TO BE CLASSED 100.A.1 AT LLOYD'S FOR FISHING PURPOSES.
E & B CASING AS PREVIOUSLY APPROVED. DECK PLATED IN WAY OF
E & B CASING.

LLOYD'S NUMERALS.

1/2 GIRTH	19.75
1/2 BREADTH	10.95
DEPTH	13.20
1ST NO	43.90
RULE LENGTH	127.08
2ND NO	5578.81


EQUIPMENT.

1ST BOWER ANCHOR	5 1/2 CWTs	EX STOCK.
2ND "	5 "	" "
3RD "	2 3/4 "	" "
105 FATHOMS	1 1/16 "	SHORT LINK CABLE.
60 "	6 "	HAWSER
60 "	5 "	WARP.

PROPORTIONS.

B TO L	5.8
D TO L	9.6

LENGTH OF RAISED FORECASTLE DK. -----
" " " QUARTER DK. 77 FEET

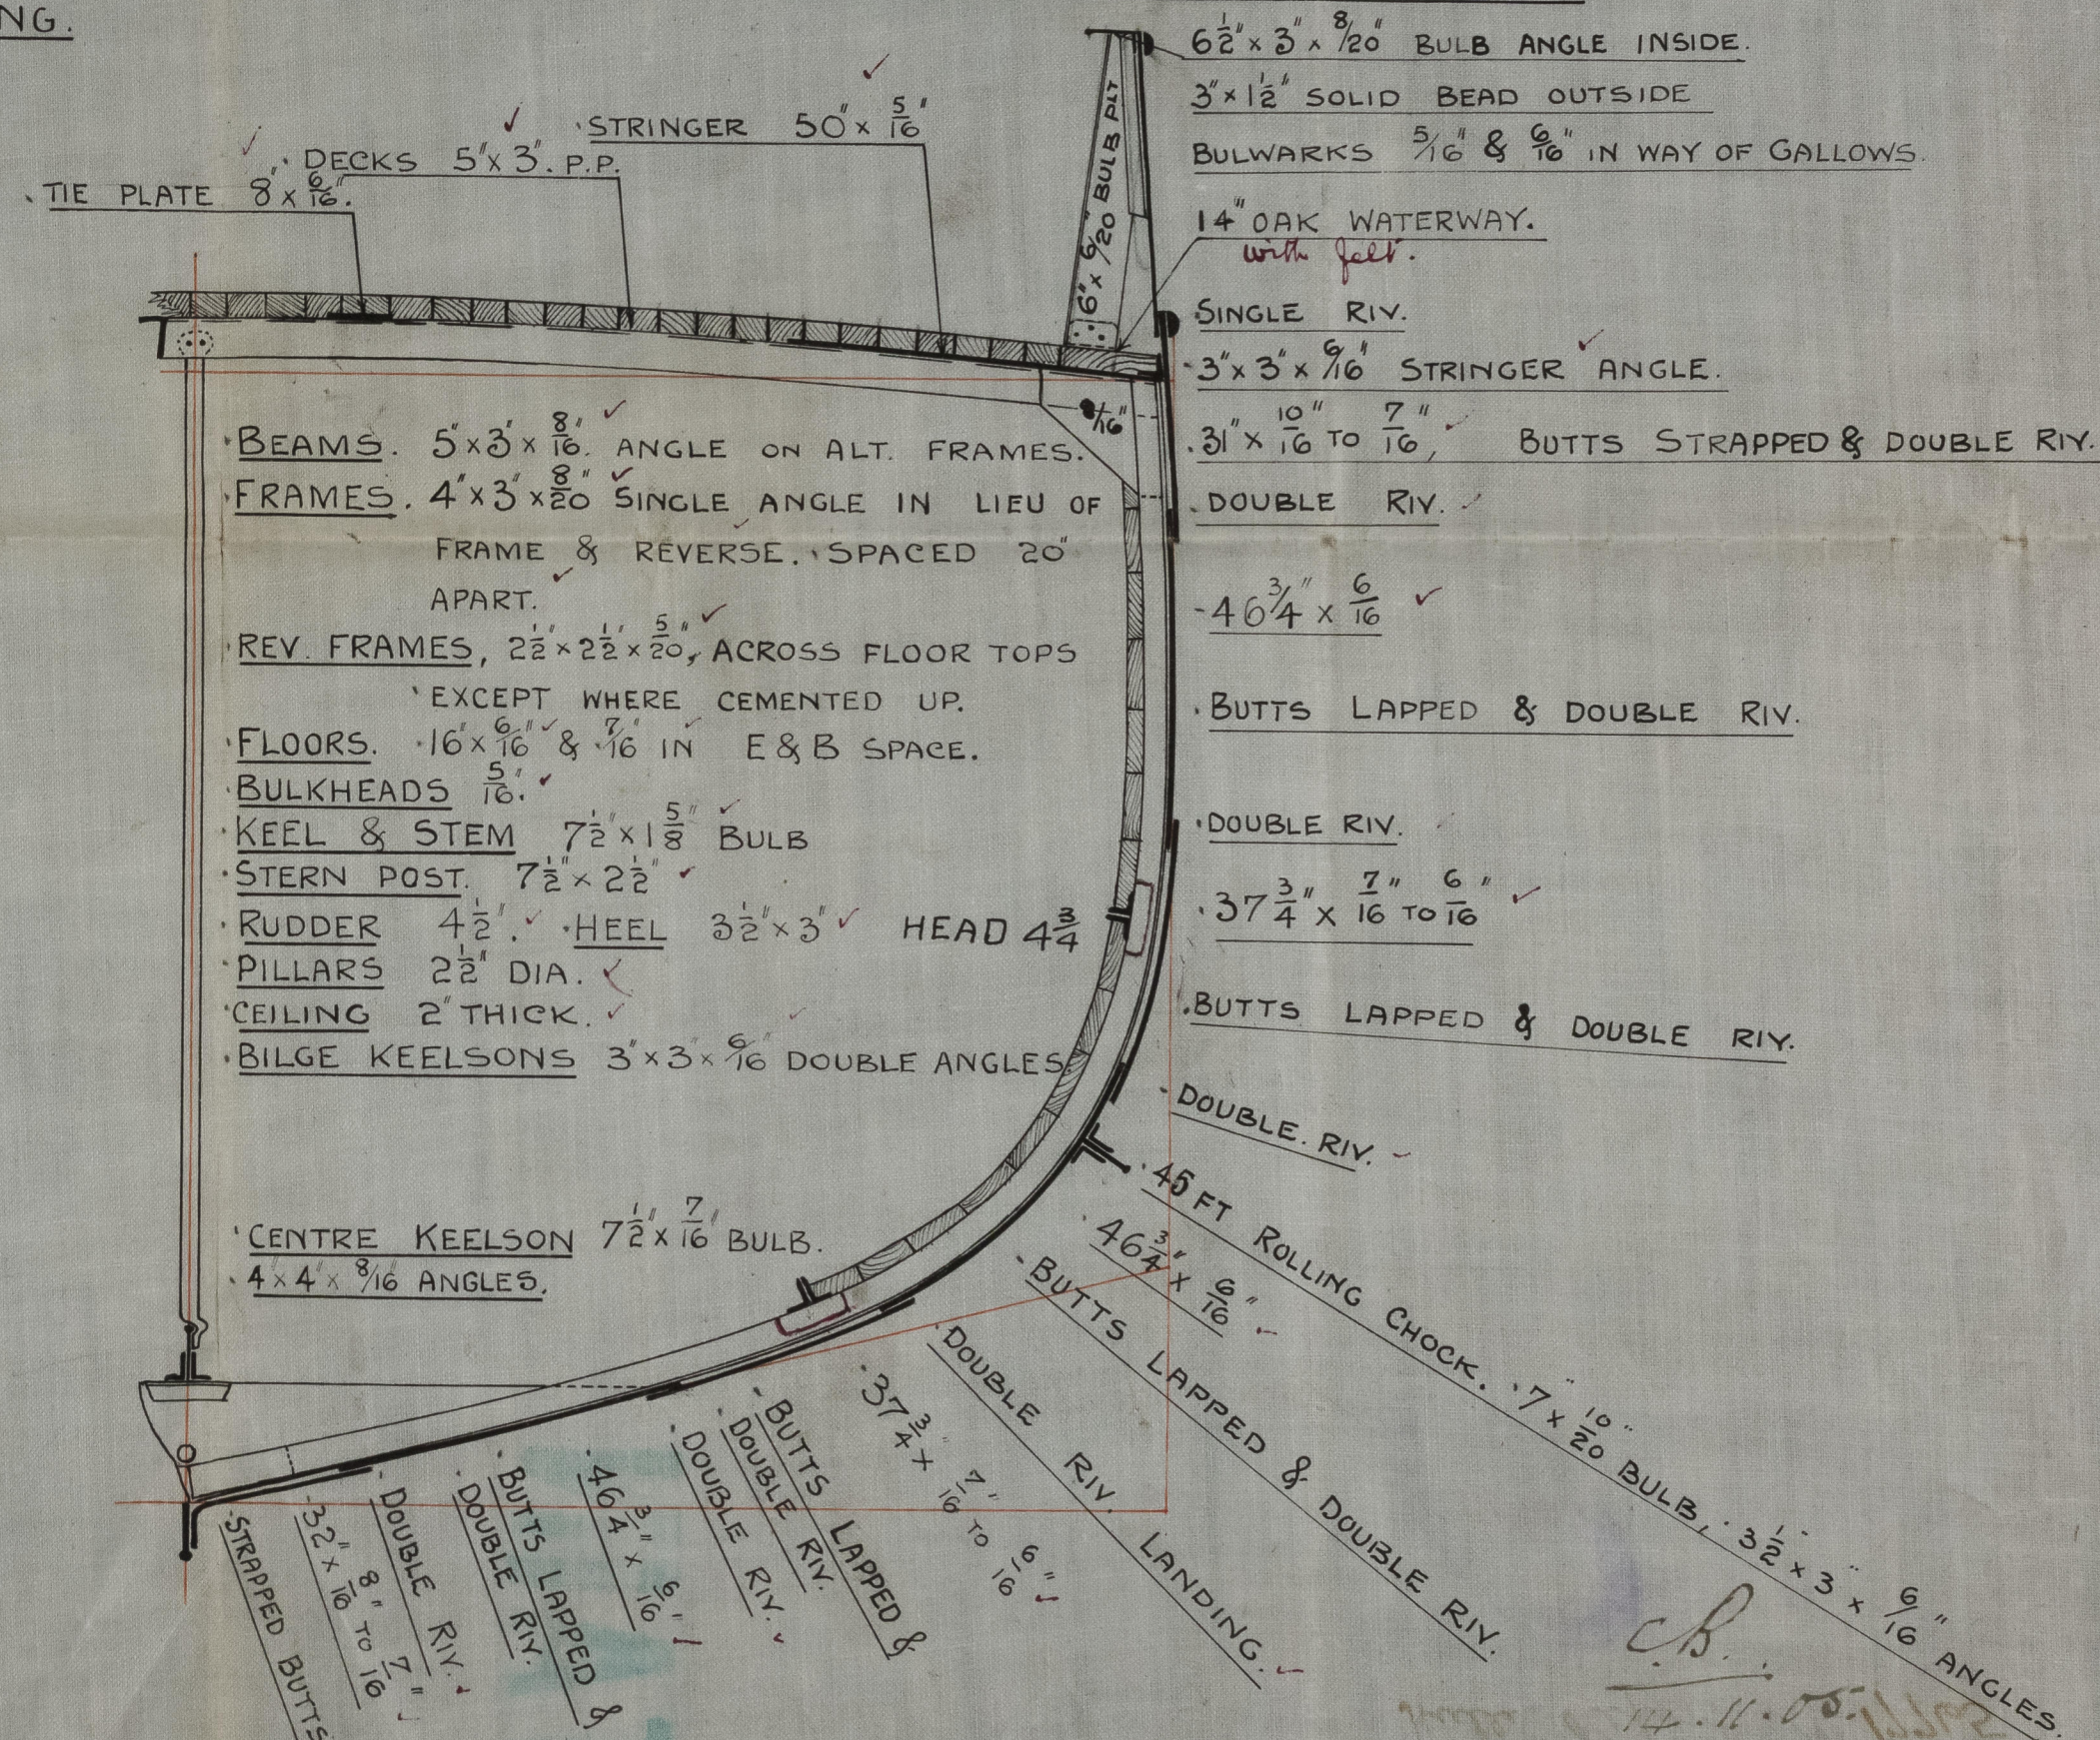

© 2020 Lloyd's Register Foundation

W1491-0141

Hull Report No 17765



SHIP SECTION

Mudshuf Section 360.