

14. 11. 05

Good + Great


Wieder

15. 2. 0

Chapman at home

FEEL
HOUSE

14.11.05

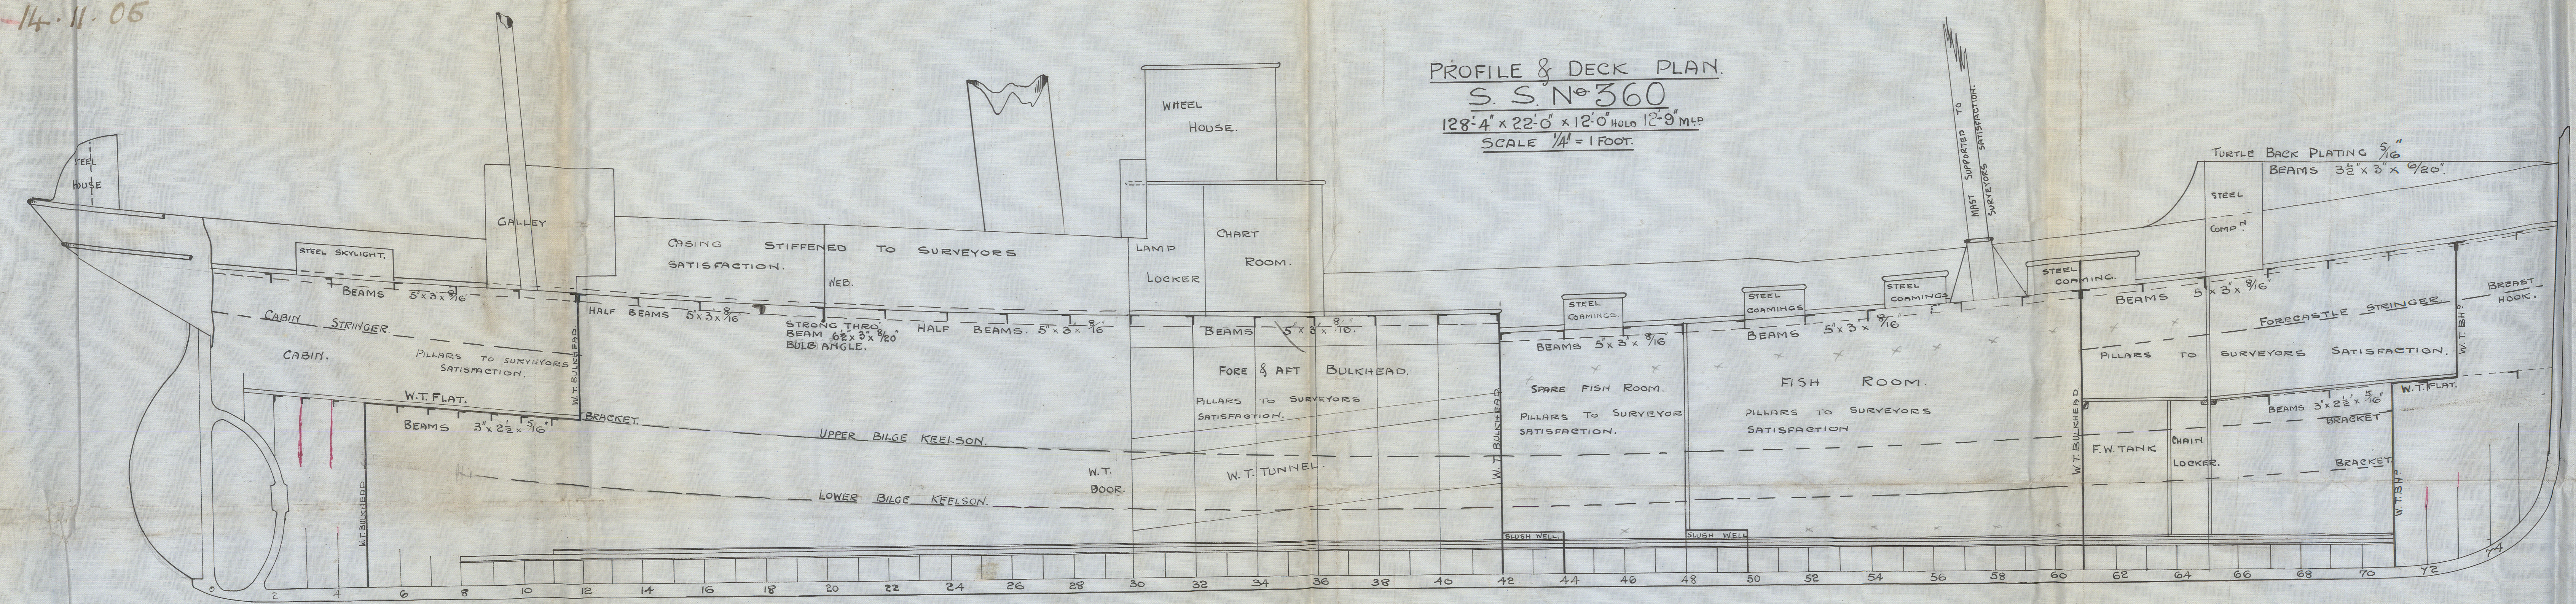


PROFILE & DECK PLAN.
S. S. No 360
128'-4" x 22'-0" x 12'-0" HOLD 12'-9" M.L.P.
SCALE 1/4" = 1 FOOT.



C.B.
14.11.05.



Lloyd's Register
Foundation

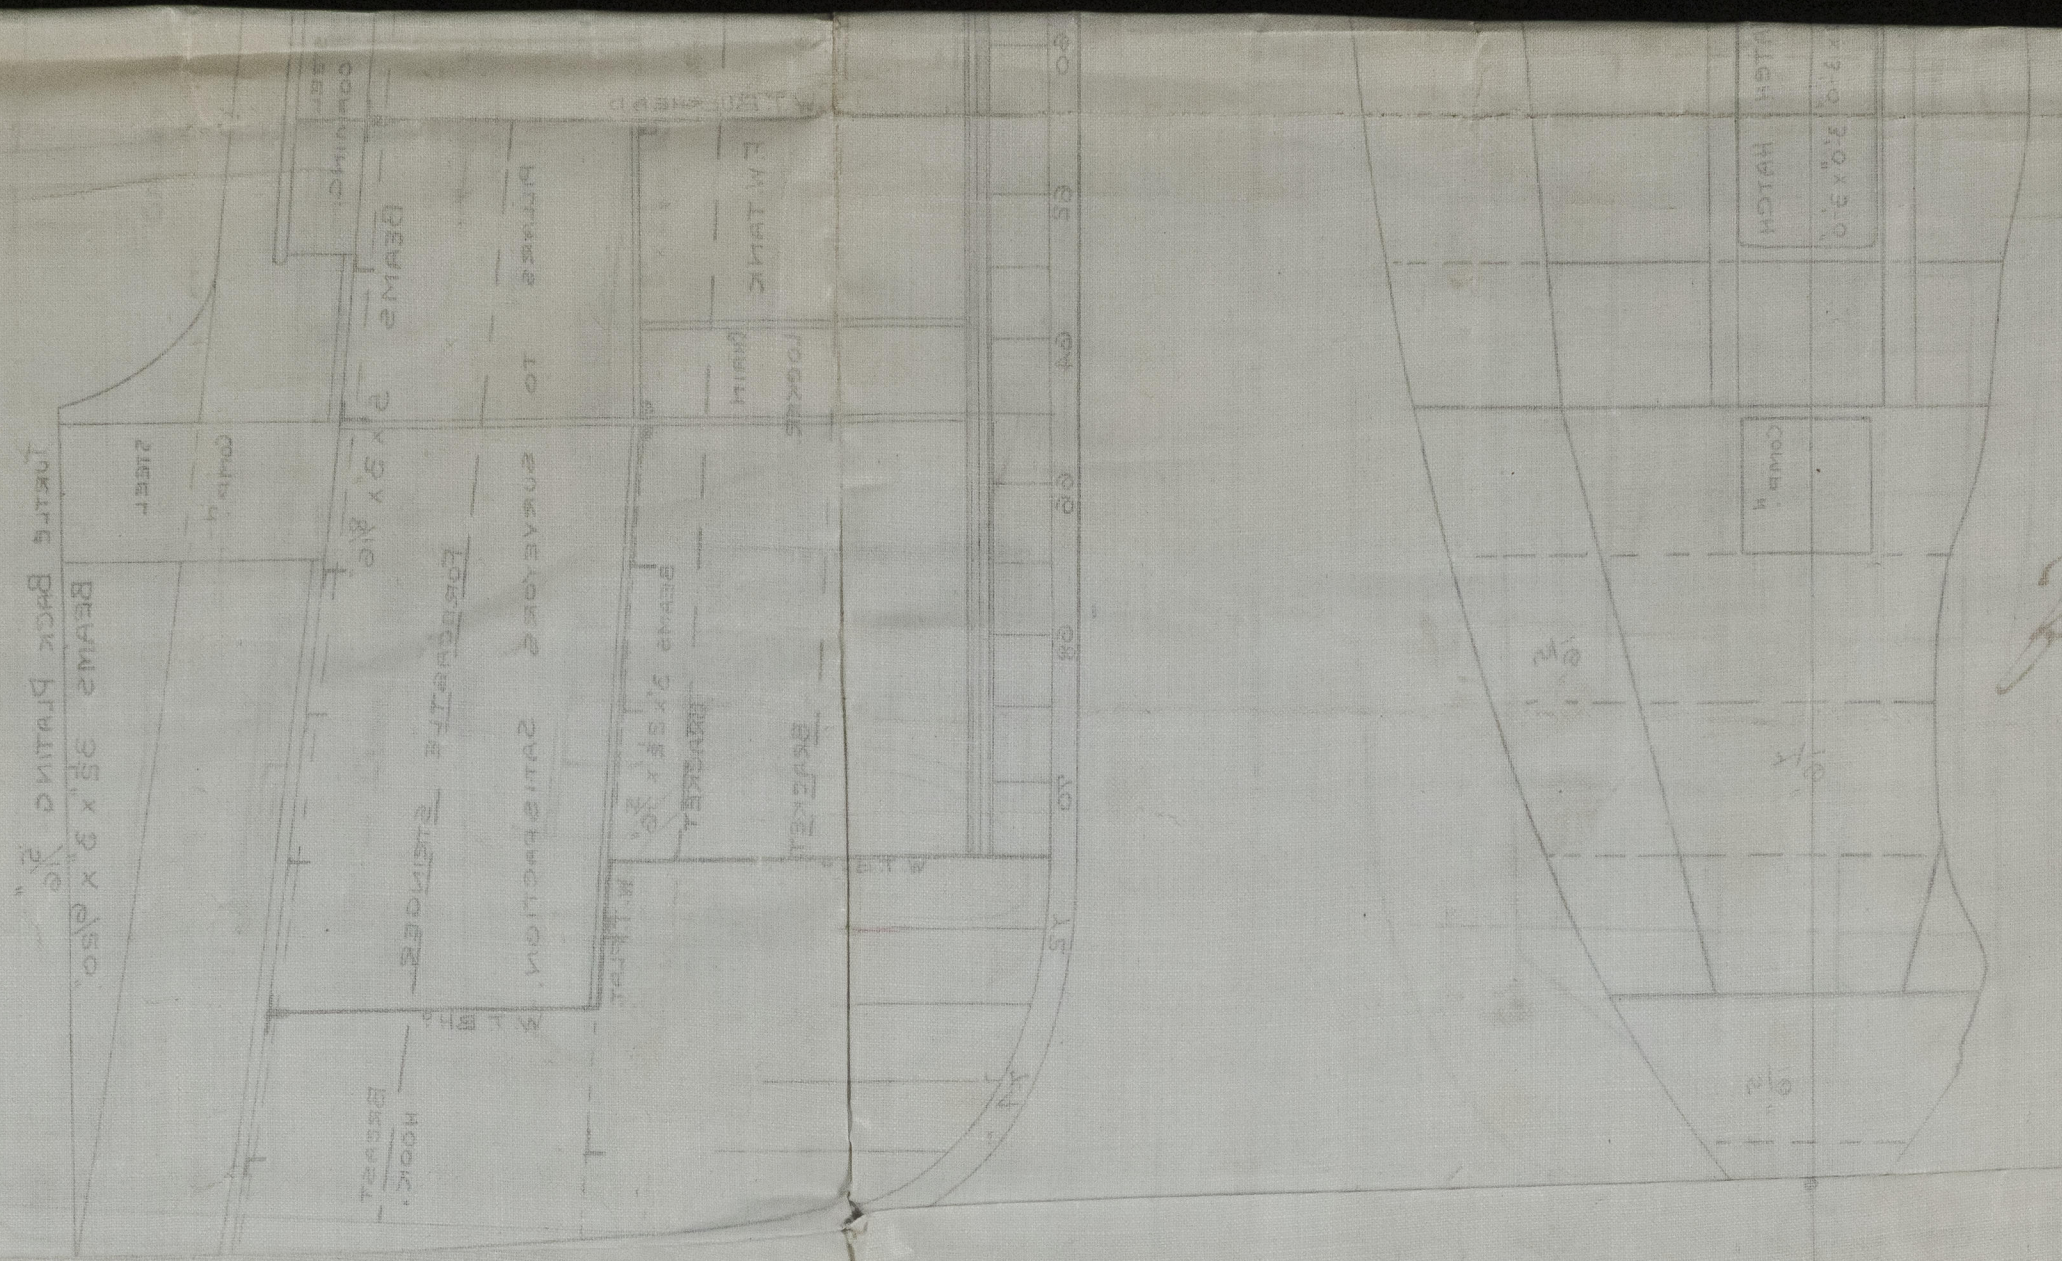

$\frac{1}{2}$ 1/2
 2 1/2
 1 1/2

Profile & Deck Plan.. 360.



© 2020

Lloyd's Register
Foundation