

Preposed New Screw Tug № 115.

<u>Dimensions:</u>	
Length bet. Perp ^s	74' 0"
Beam moulded	17' 0"
Depth "	9' 11"

Scale $\frac{3}{8}'' = 1$ Foot.

Midship Section
of

Steel Screw Tug N^o 115.

Dimensions,

Length B.P. 74'0" *Depth* MLD. 9'11"
Breadth 17'0" *Class* 100 Al. Lloyds

Depths to Length 7.26 *Breadths to Length* 4.35

$\frac{1}{2}$ Breadth	8.5	
Depth	10.78	21
$\frac{1}{2}$ Girth	16.32	
	<u>35.09</u>	Frame No
	74	
	<u>2596</u>	Plating No

Frames $2\frac{1}{2} \times 2\frac{1}{2} \times 1\frac{1}{2}$ " Spaced 19" apart
Reverse frames $3\frac{1}{2} \times 2\frac{1}{2} \times 1\frac{1}{2}$ " double reverse in way of
Boilers Engineering
Stern frame 6" x 2" Stem 6" x $1\frac{1}{4}$ "
Keelbar $6\frac{1}{2} \times 1\frac{1}{2}$ " Rudder head $3\frac{1}{2}$ " Pintles 2"
Floors $1\frac{1}{4} \times \frac{3}{16}$ " under Engines $\frac{1}{2}$ " under Boiler $\frac{7}{16}$ "
Bulkheads $\frac{7}{16}$ " Deck plating $\frac{7}{16}$ "
Pillars where practicable $2\frac{1}{2} \times 1\frac{1}{2}$ "

Scale $\frac{3}{4}"$ to 1 Foot.

Anchors & Cables

Equipment
Bower anchor Stockless 3 1/2 Cwts
Stream anchor 3 1/4 lbs.
0-5 Fathoms 1/4" Stud cable chain
60 " 5/8" Hemp Towline

Riveting Shell Butts overlapped and double riveted.

Reverse frame
height

Fore and aft
 $4 \times 3 \times 5$
 $5 \times 3 \times 4$

Single Angle as far forward and aft
5 x 3 x 9 as practicable
4 x 3 x 1/2

B 5602

H. Charles

Aug. 26.45

Ms A/8

Midship Section









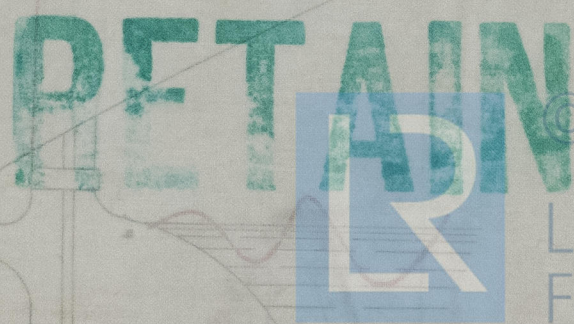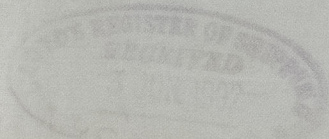

© 2020

Lloyd's Register
Foundation