


CARGO BOAT


Scale 1:100

Length 340.00
Breadth 44.91
Depth 29.75
Tonnage N.D. 3685.58
Do Gross 4186.98




- Bridge deck plan -

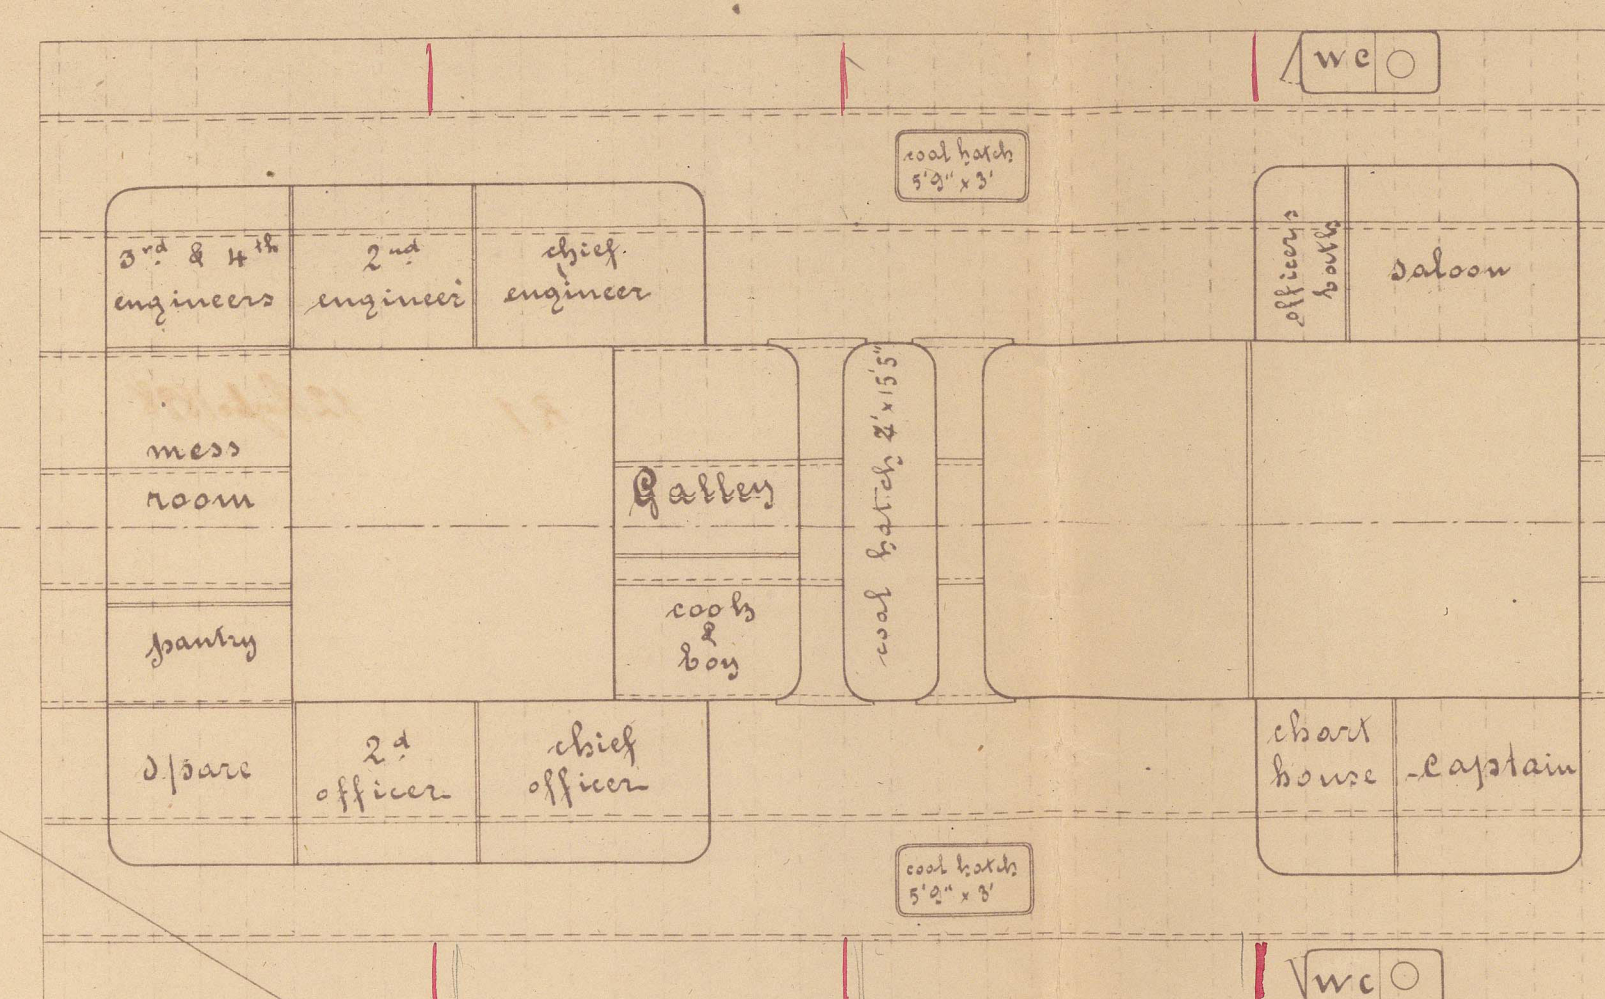

- Section through frame 12 M

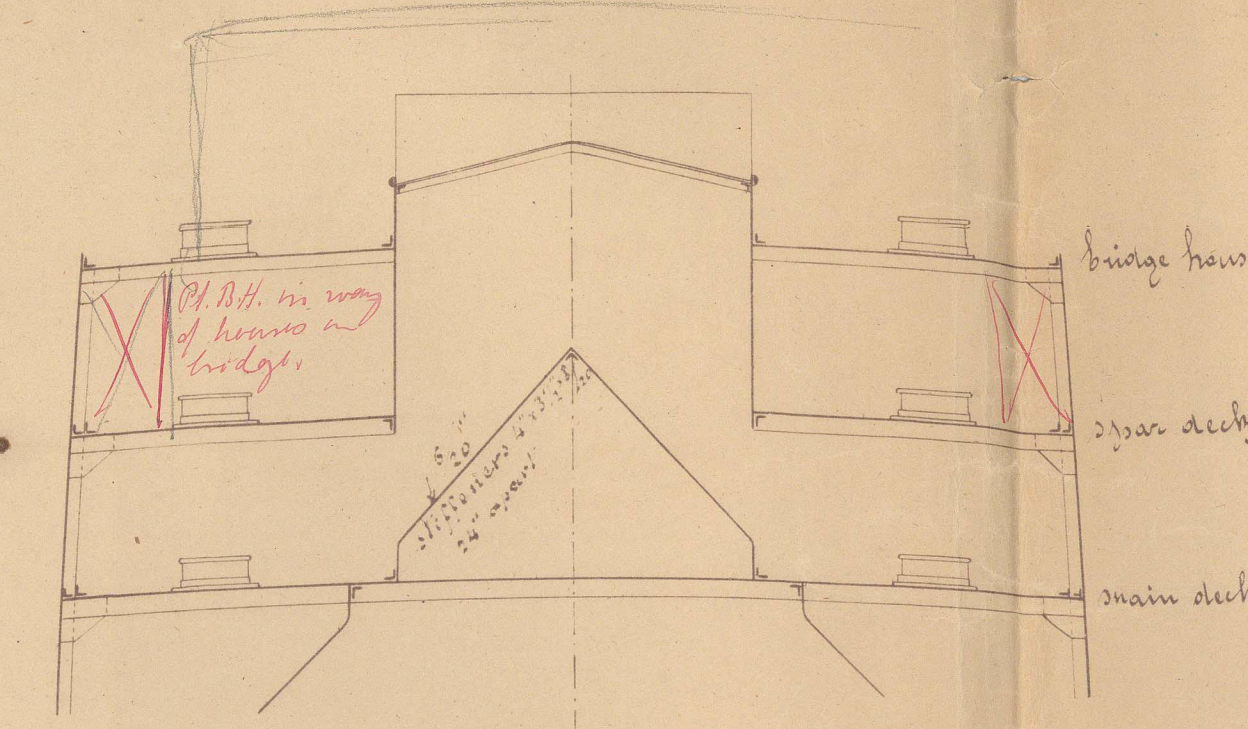


Note: In way of bridge house all covered frames extended to upper part of the open deck angle base.

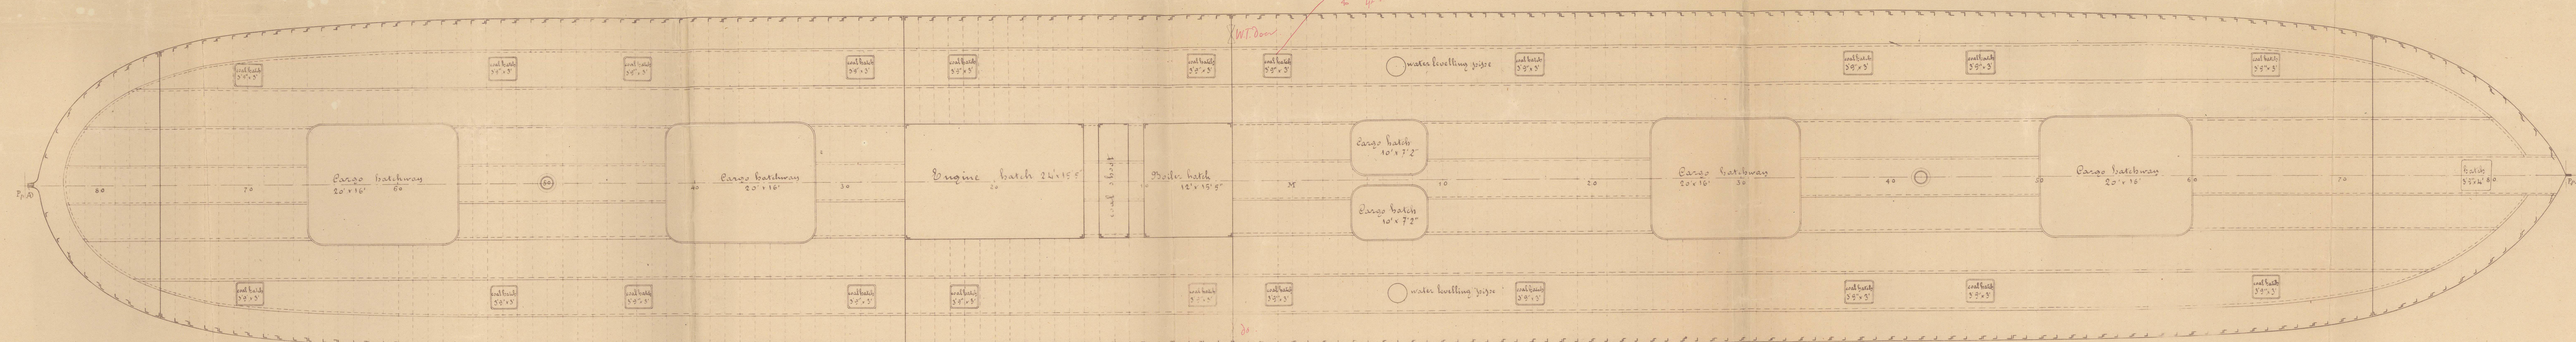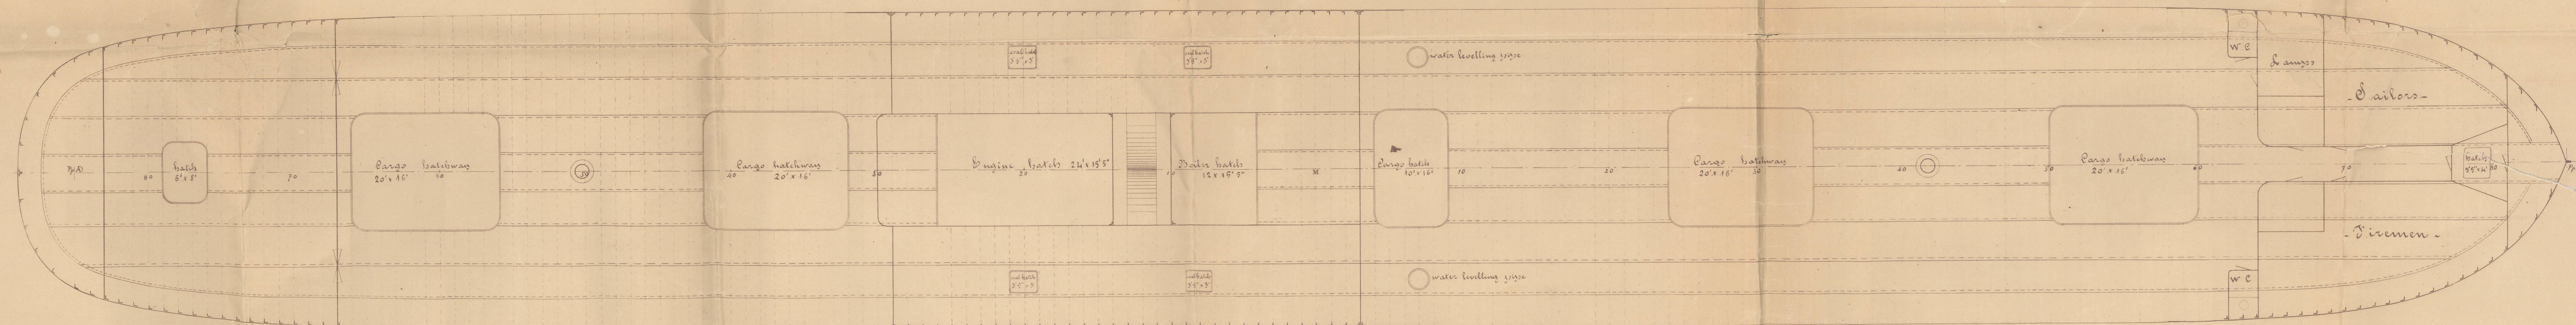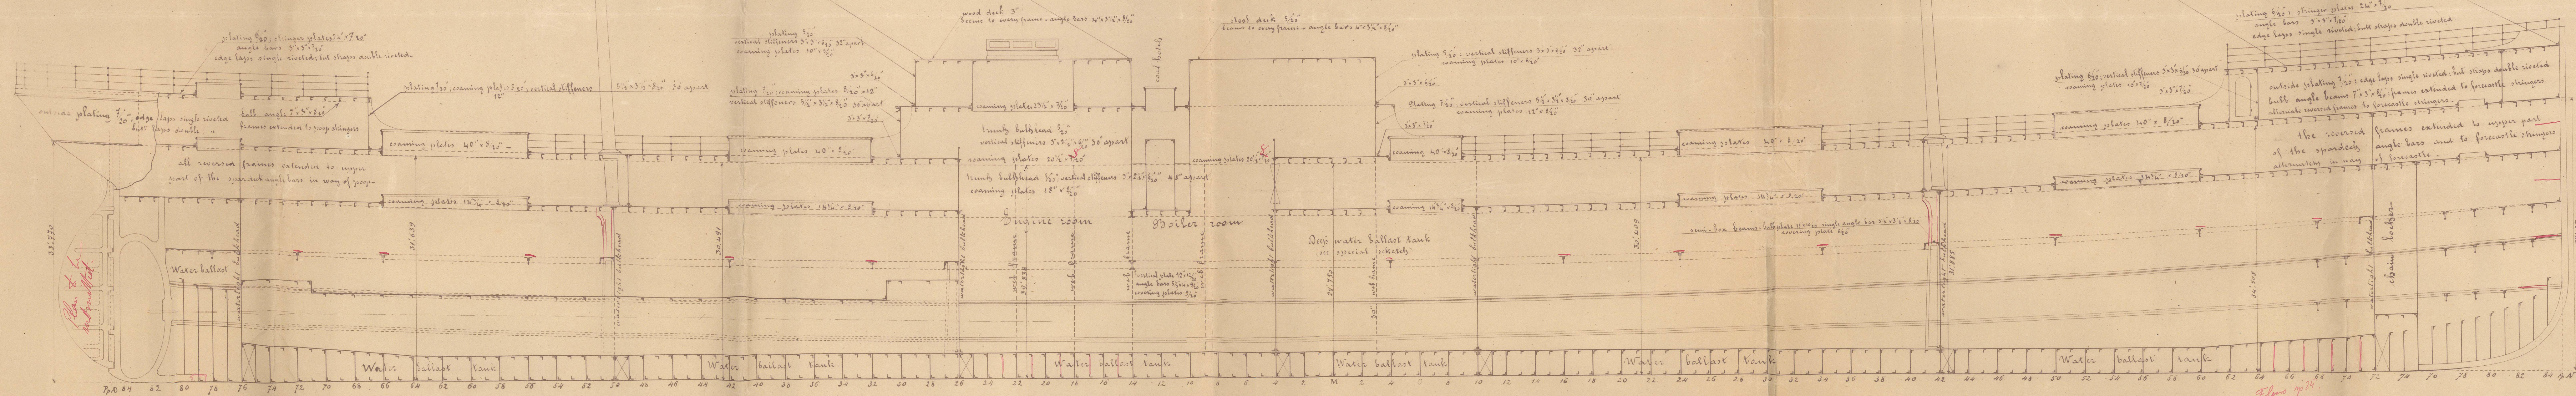

Approved 20/7/98

Box *General* No. in Box *360*
 Builders & Yard No. *Orlando Fratelli*
 Copy of *M. S. P. McBlane & Son, Ballantyne*
1st No. 88 495 2nd No. 29964
 Date *20/7/98*

Profile & Co.

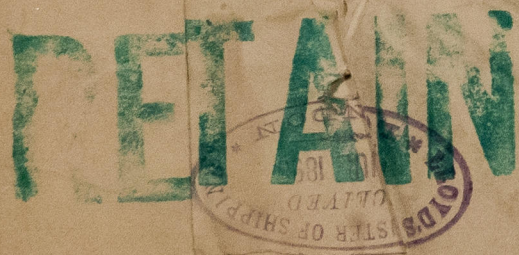

W1486-0090



© 2021
 Lloyd's Register
 Foundation