



9.5.01

SCALE $\frac{1}{8}'' = 1 \text{ FOOT.}$

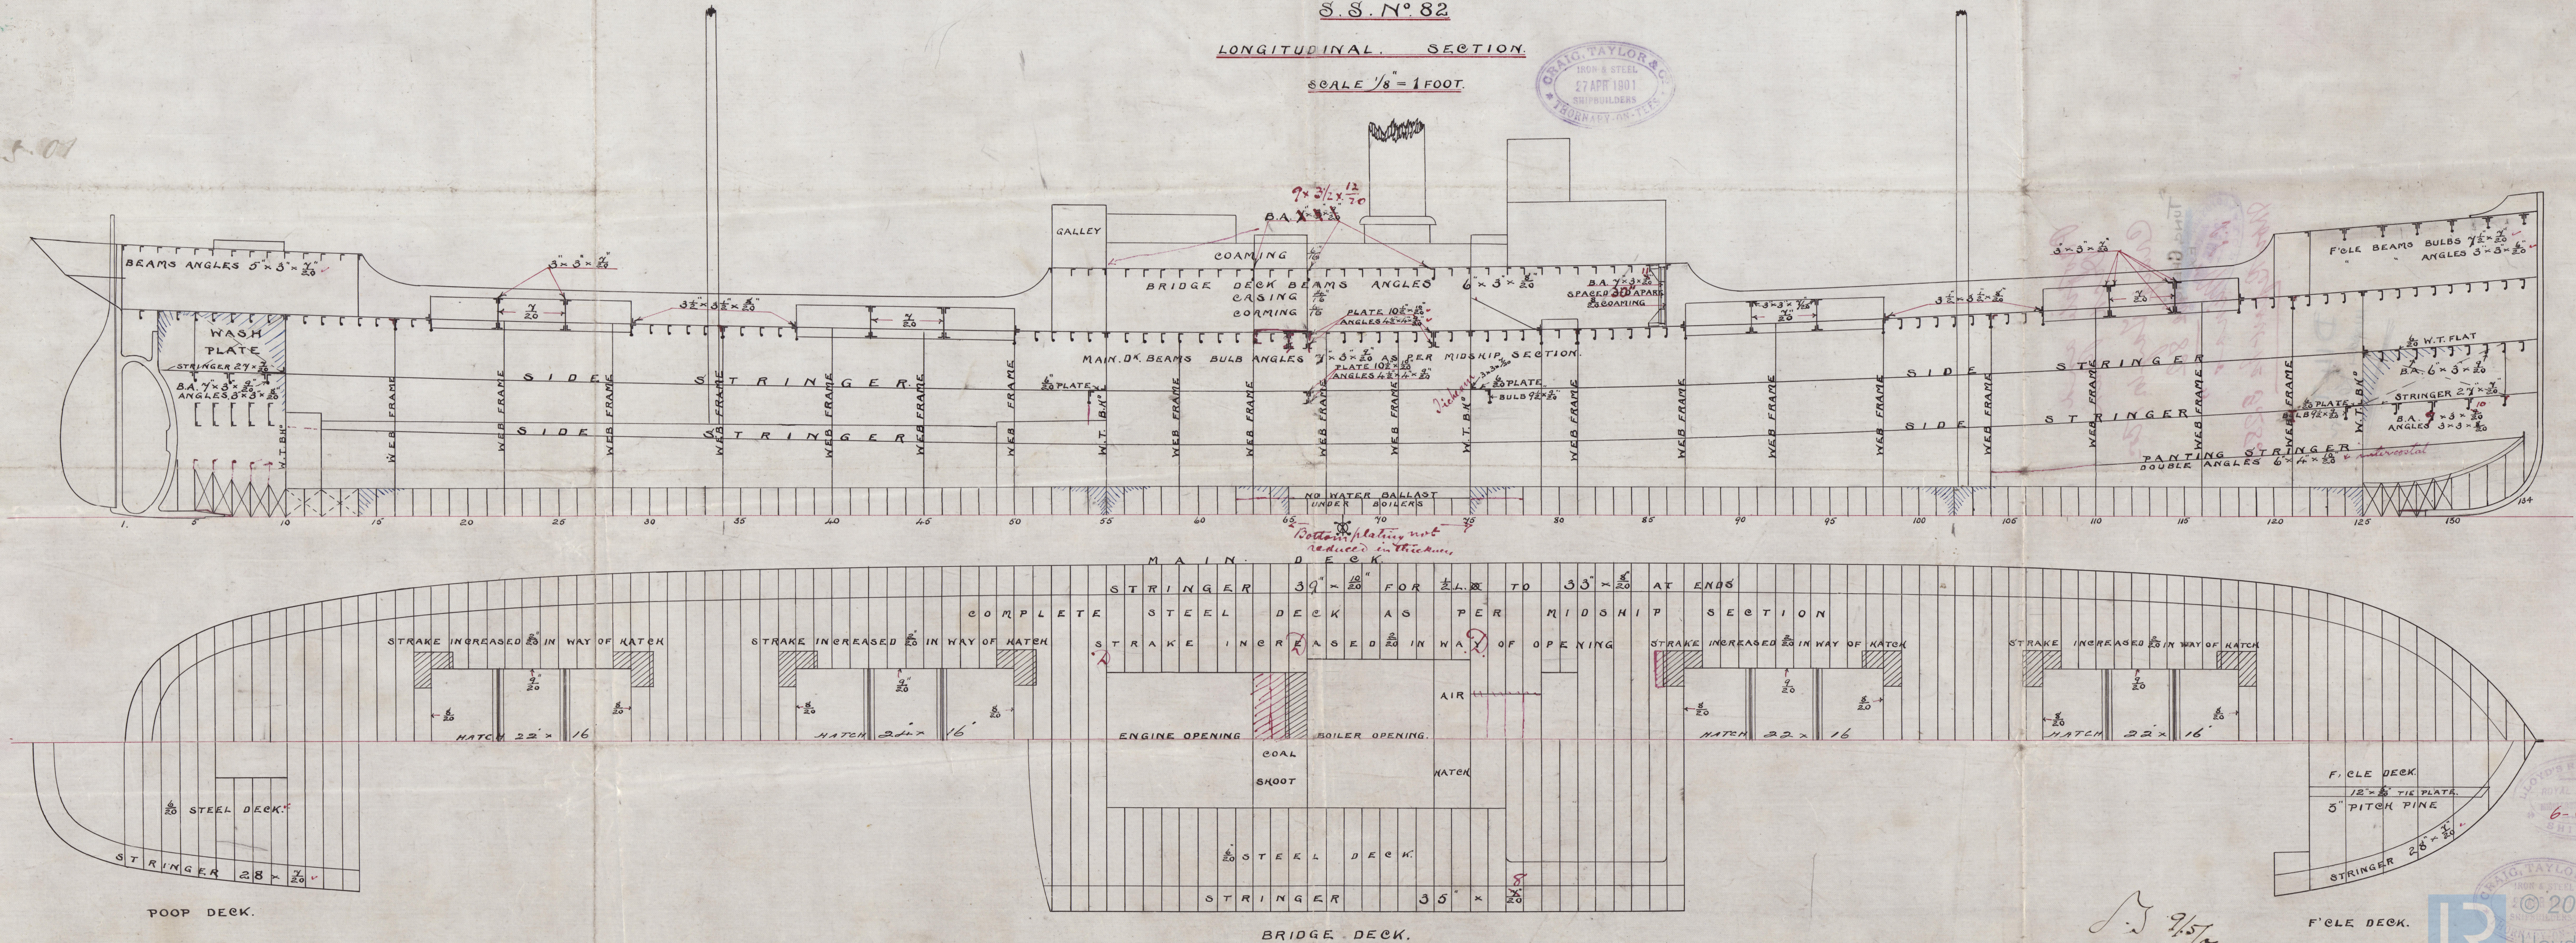

B. 9.5704

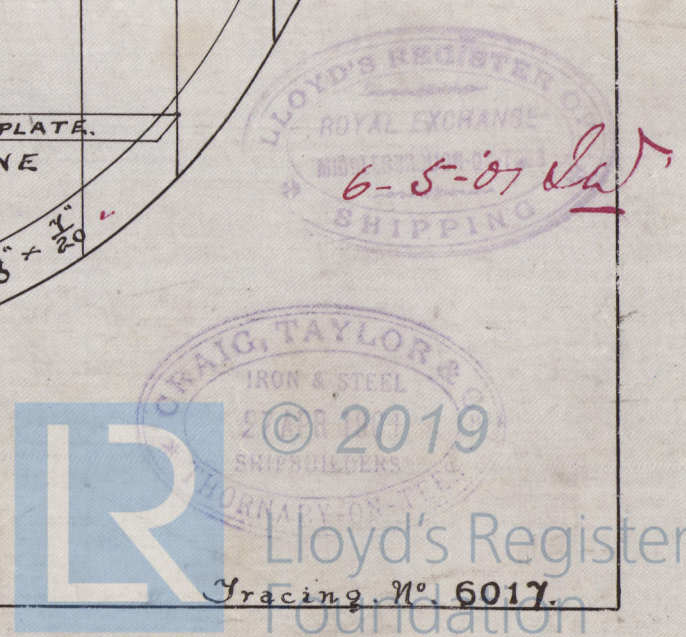

Profile and
Deck Plan

Craig Taylor Co.

TUNG CHENG
EX

No 82

S.S. "Minao"

Moore Report No 3282

D14
under Karori



Lloyd's Register
Foundation