

30-12-05

NUMERALS.

1/2 Girth	32.25
1/2 Breadth	18.00
Depth	16.25
66.50	1 <sup>st</sup> Numeral.
188.83	
199.50	
532.00	
532.00	
532.00	
66.50	
125.57.19.50	2 <sup>nd</sup> Numeral.

# STERN WELL HOPPER DREDGER. N<sup>o</sup>436


TO CLASS A1. SPECIAL SURVEY.

SCALE 1/8" = ONE FOOT.

DIMENSIONS.

LENGTH BETWEEN PERPS	120'-0"
BREADTH MOULDED	36'-0"
DEPTH DO.	15'-6"
LENGTH AS PER RULE	188'-53"
BREADTH " " "	36'-0"
DEPTH " " "	16'-25"

B to L 5.24.  
D to L 11.02.

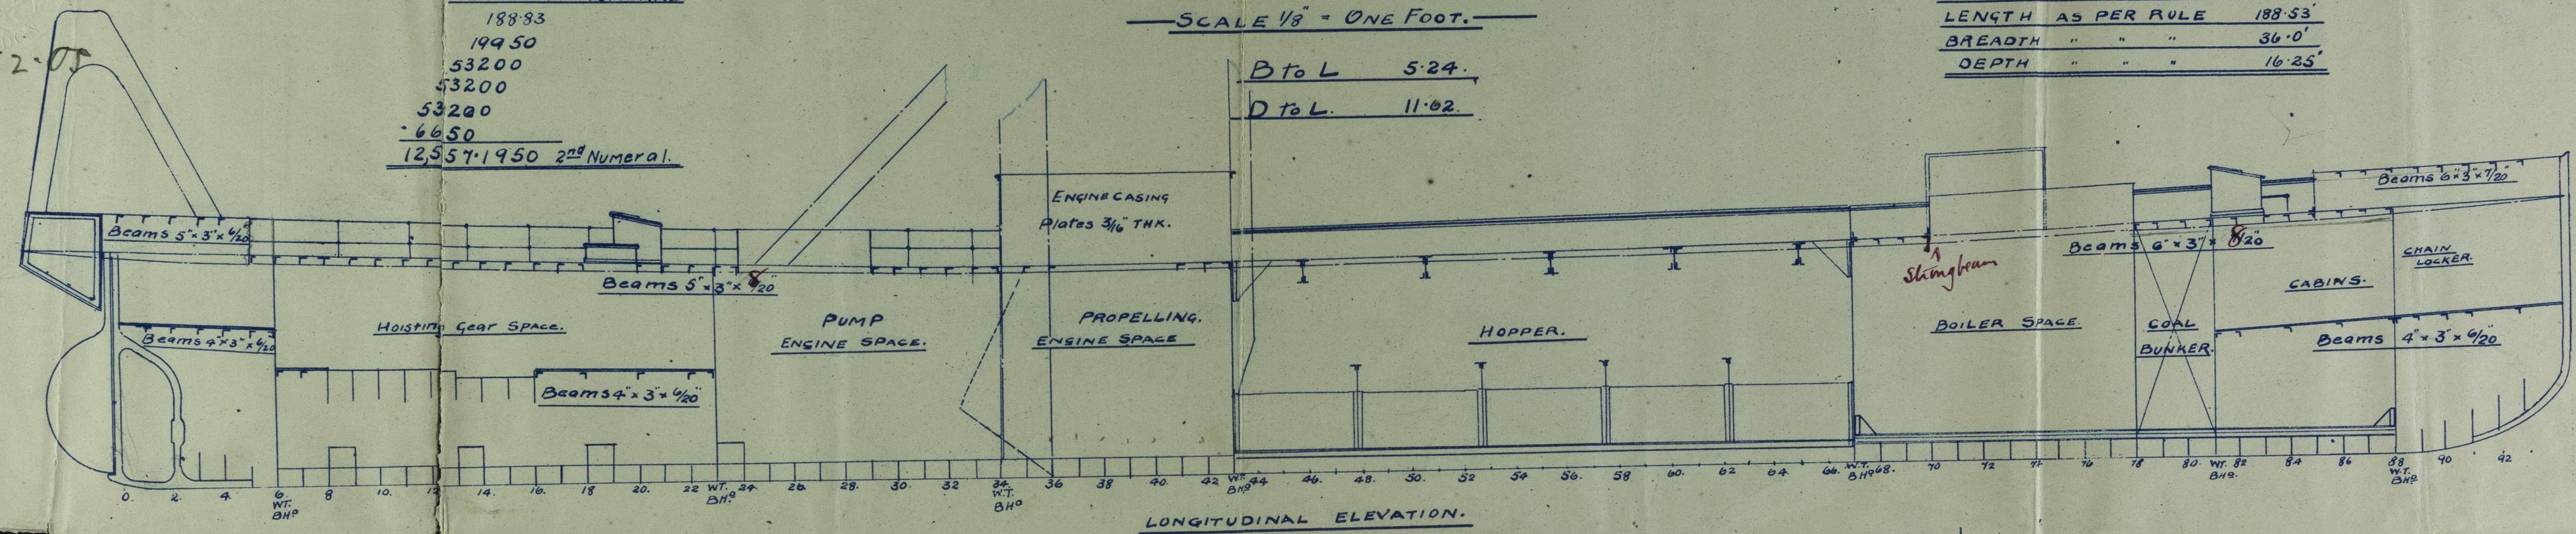


W. SIMONS & CO., LTD

LONDON WORKS.

RENFREW

27/12/05.

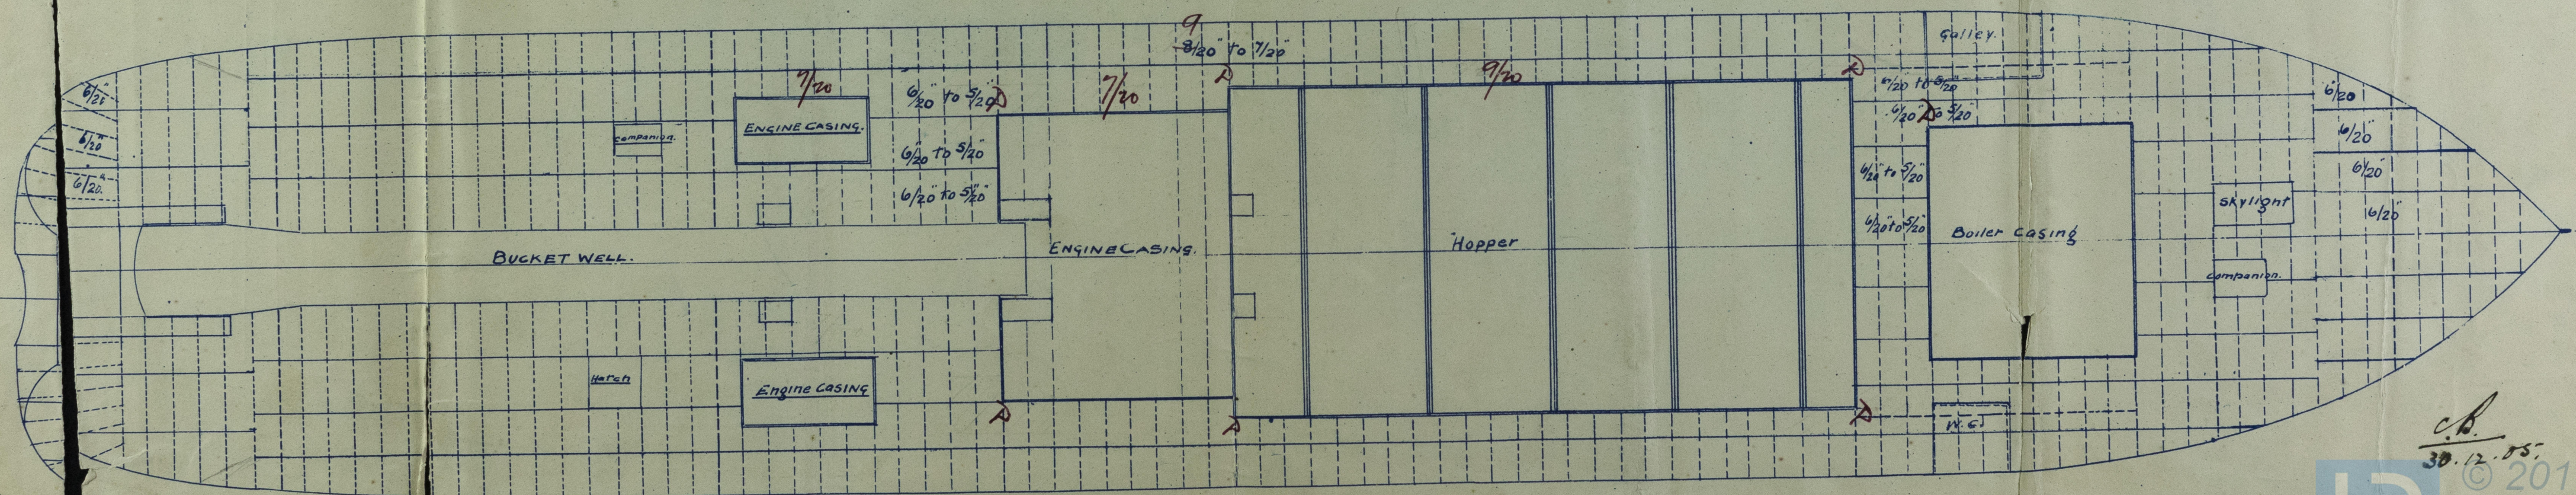

Plan.



Messrs W. Simon & Co

No 436

Profile & R Plan



"Karnafuli. I."  
Gls. n. No 24630

RETAI



© 2019

Lloyd's Register  
Foundation