



TO CLASS TEISHINSHO RULE 1ST CLASS VESSEL & 100AI AT LLOYD'S SPECIAL SURVEY

Detailed sketches of Profile decks etc  
to be submitted for approval.

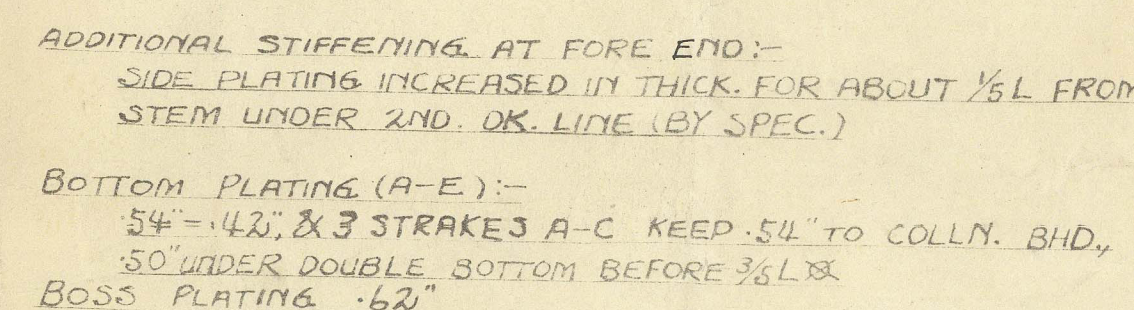

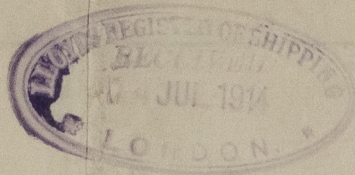



*Kawasaki Dock Co Ltd.*

Builders No. *375.*

*Kohsaka Maru*

*MIDSHIP SECTION*

Hull Design. Dept.,

Kawasaki Dockyard & Co.

DATE


*26/6/14*

*Kobe letter 29/6/14*

*Kobe Rep. No 1710*

*S.S. "Kohsaka Maru"*

*Kobe 1710*

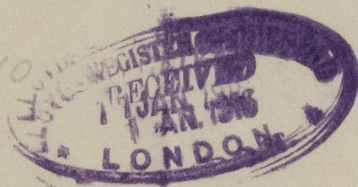

RETAIN



© 2021

Lloyd's Register  
Foundation