


13-8-14

No 375

CONSTRUCTION PROFILE & DECK PLANS.

SCALE 1/8 INCH TO 1 FOOT.

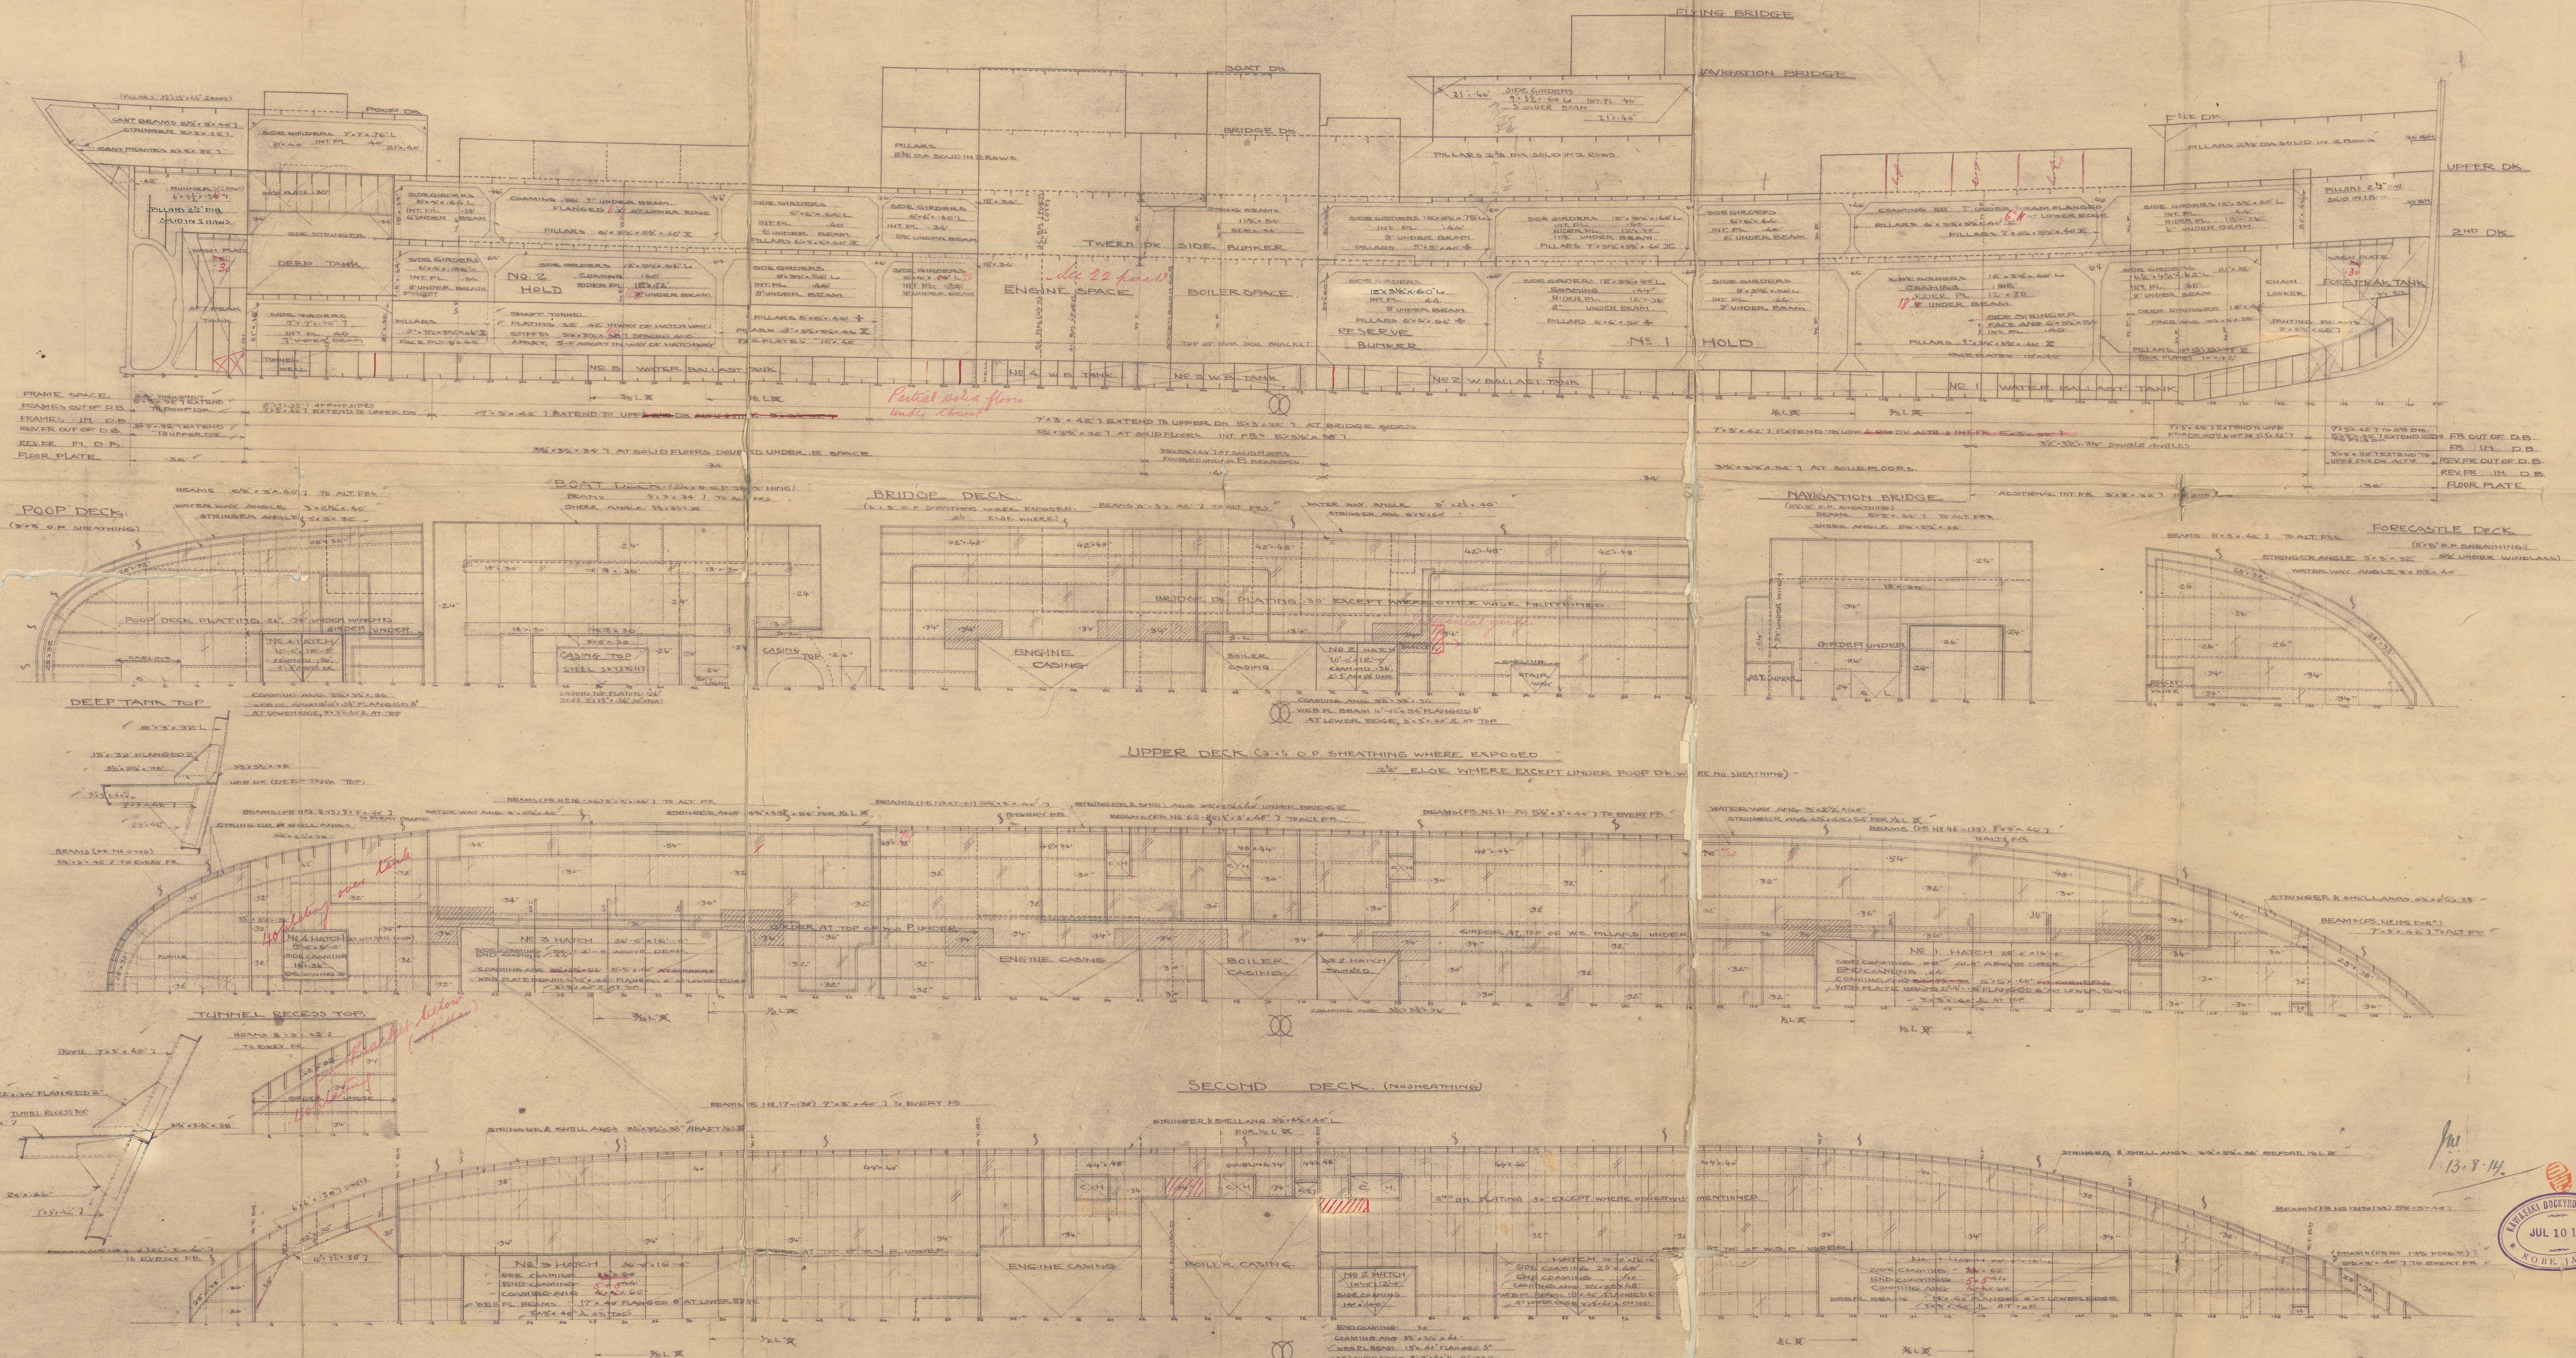

13-8-14



SHEET No 4

Kawasaki No 375

Construction Profile
& Deck plans.

Kobe let. 15.7.14

St. "Kohoku MARU"

Kobe Rep. No 1710



RETAIR