
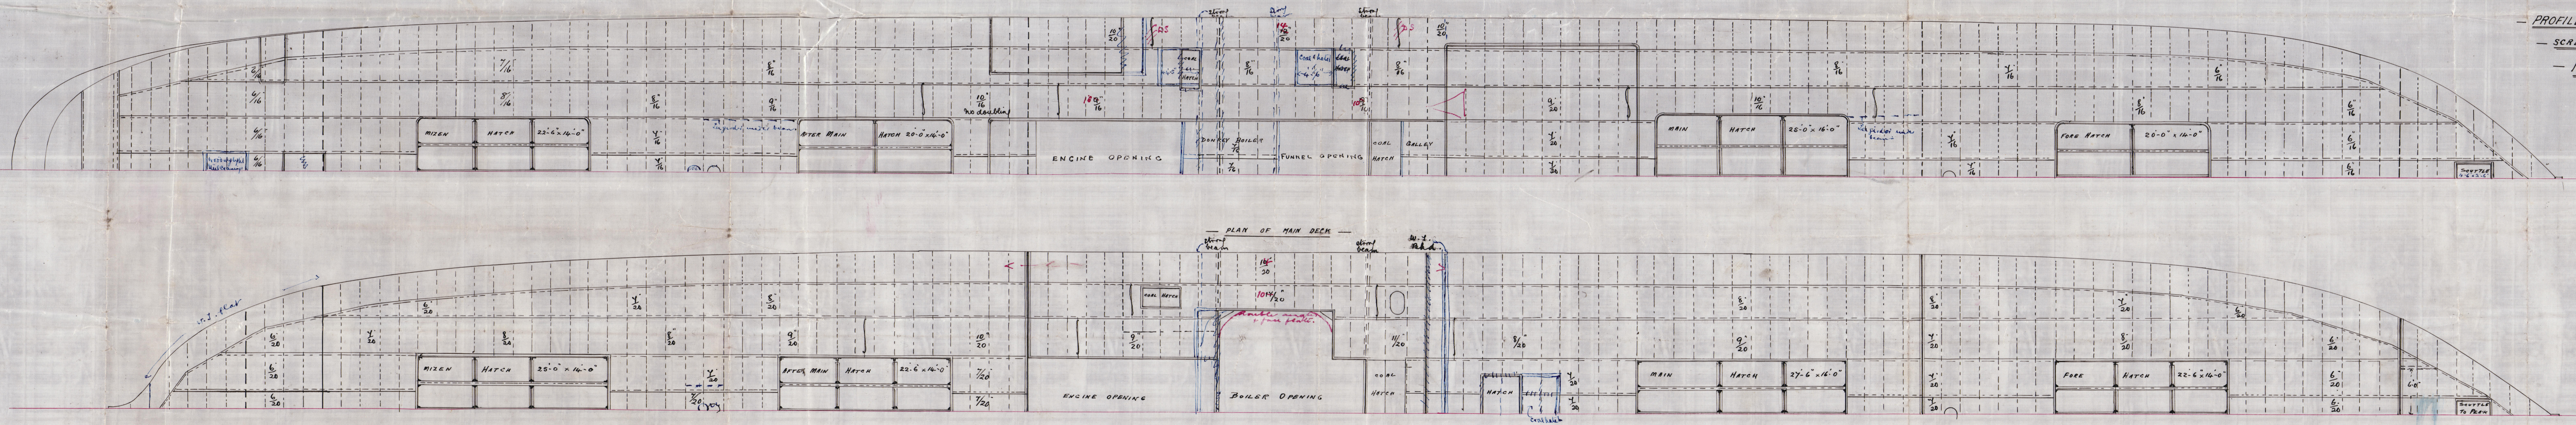


1.4.95

13000150  
13000150

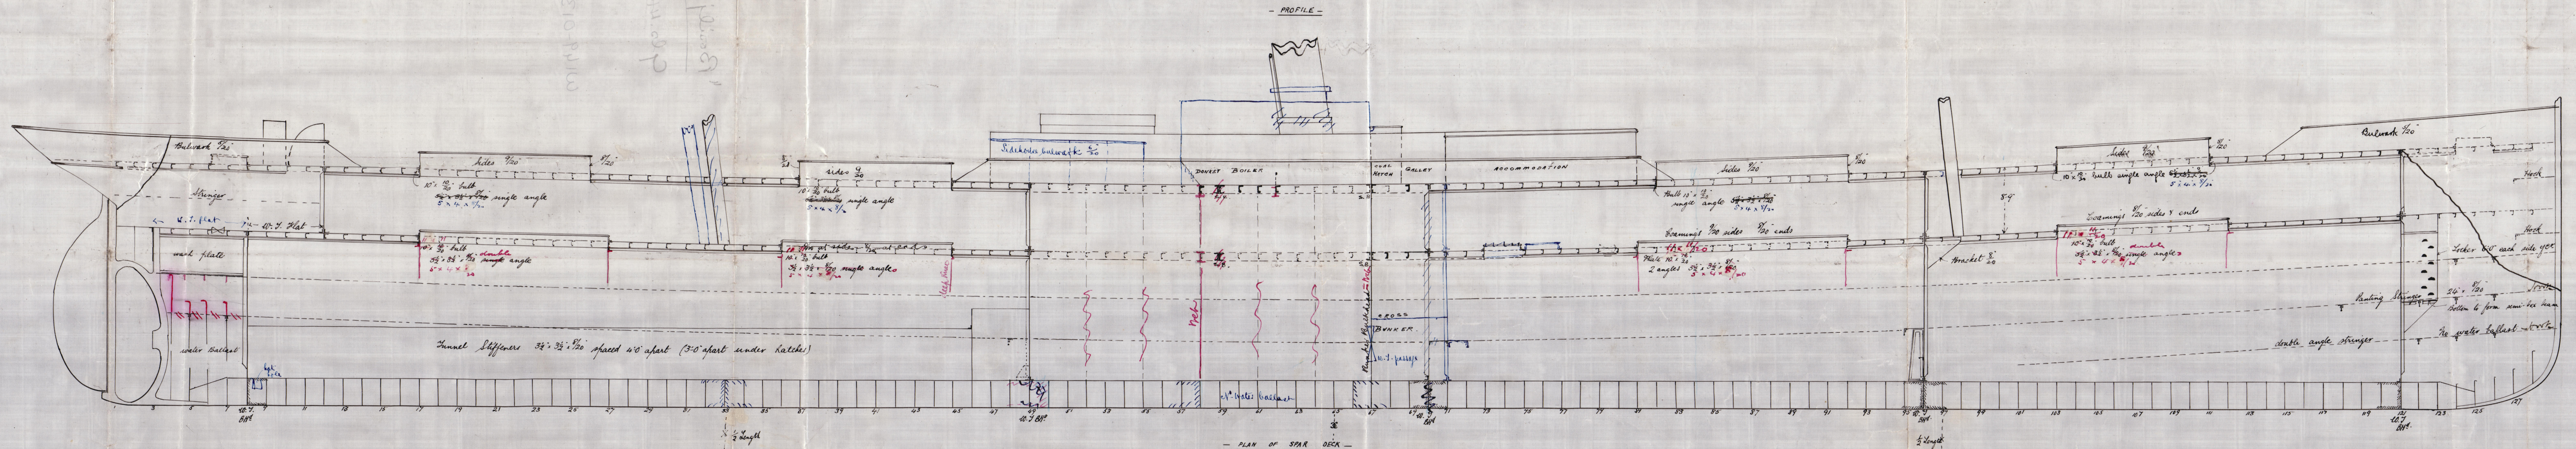

PROFILE & DECK PLANS  
SCREW STEAMER  
No 400

Note alterations shown in blue  
are as fitted in vessel.



14/95

30 MAR 95


14432



S.S. "Dominic" Glasgow Report No. 12052 -  
 S.S. "Dunstan" do " 14206 -

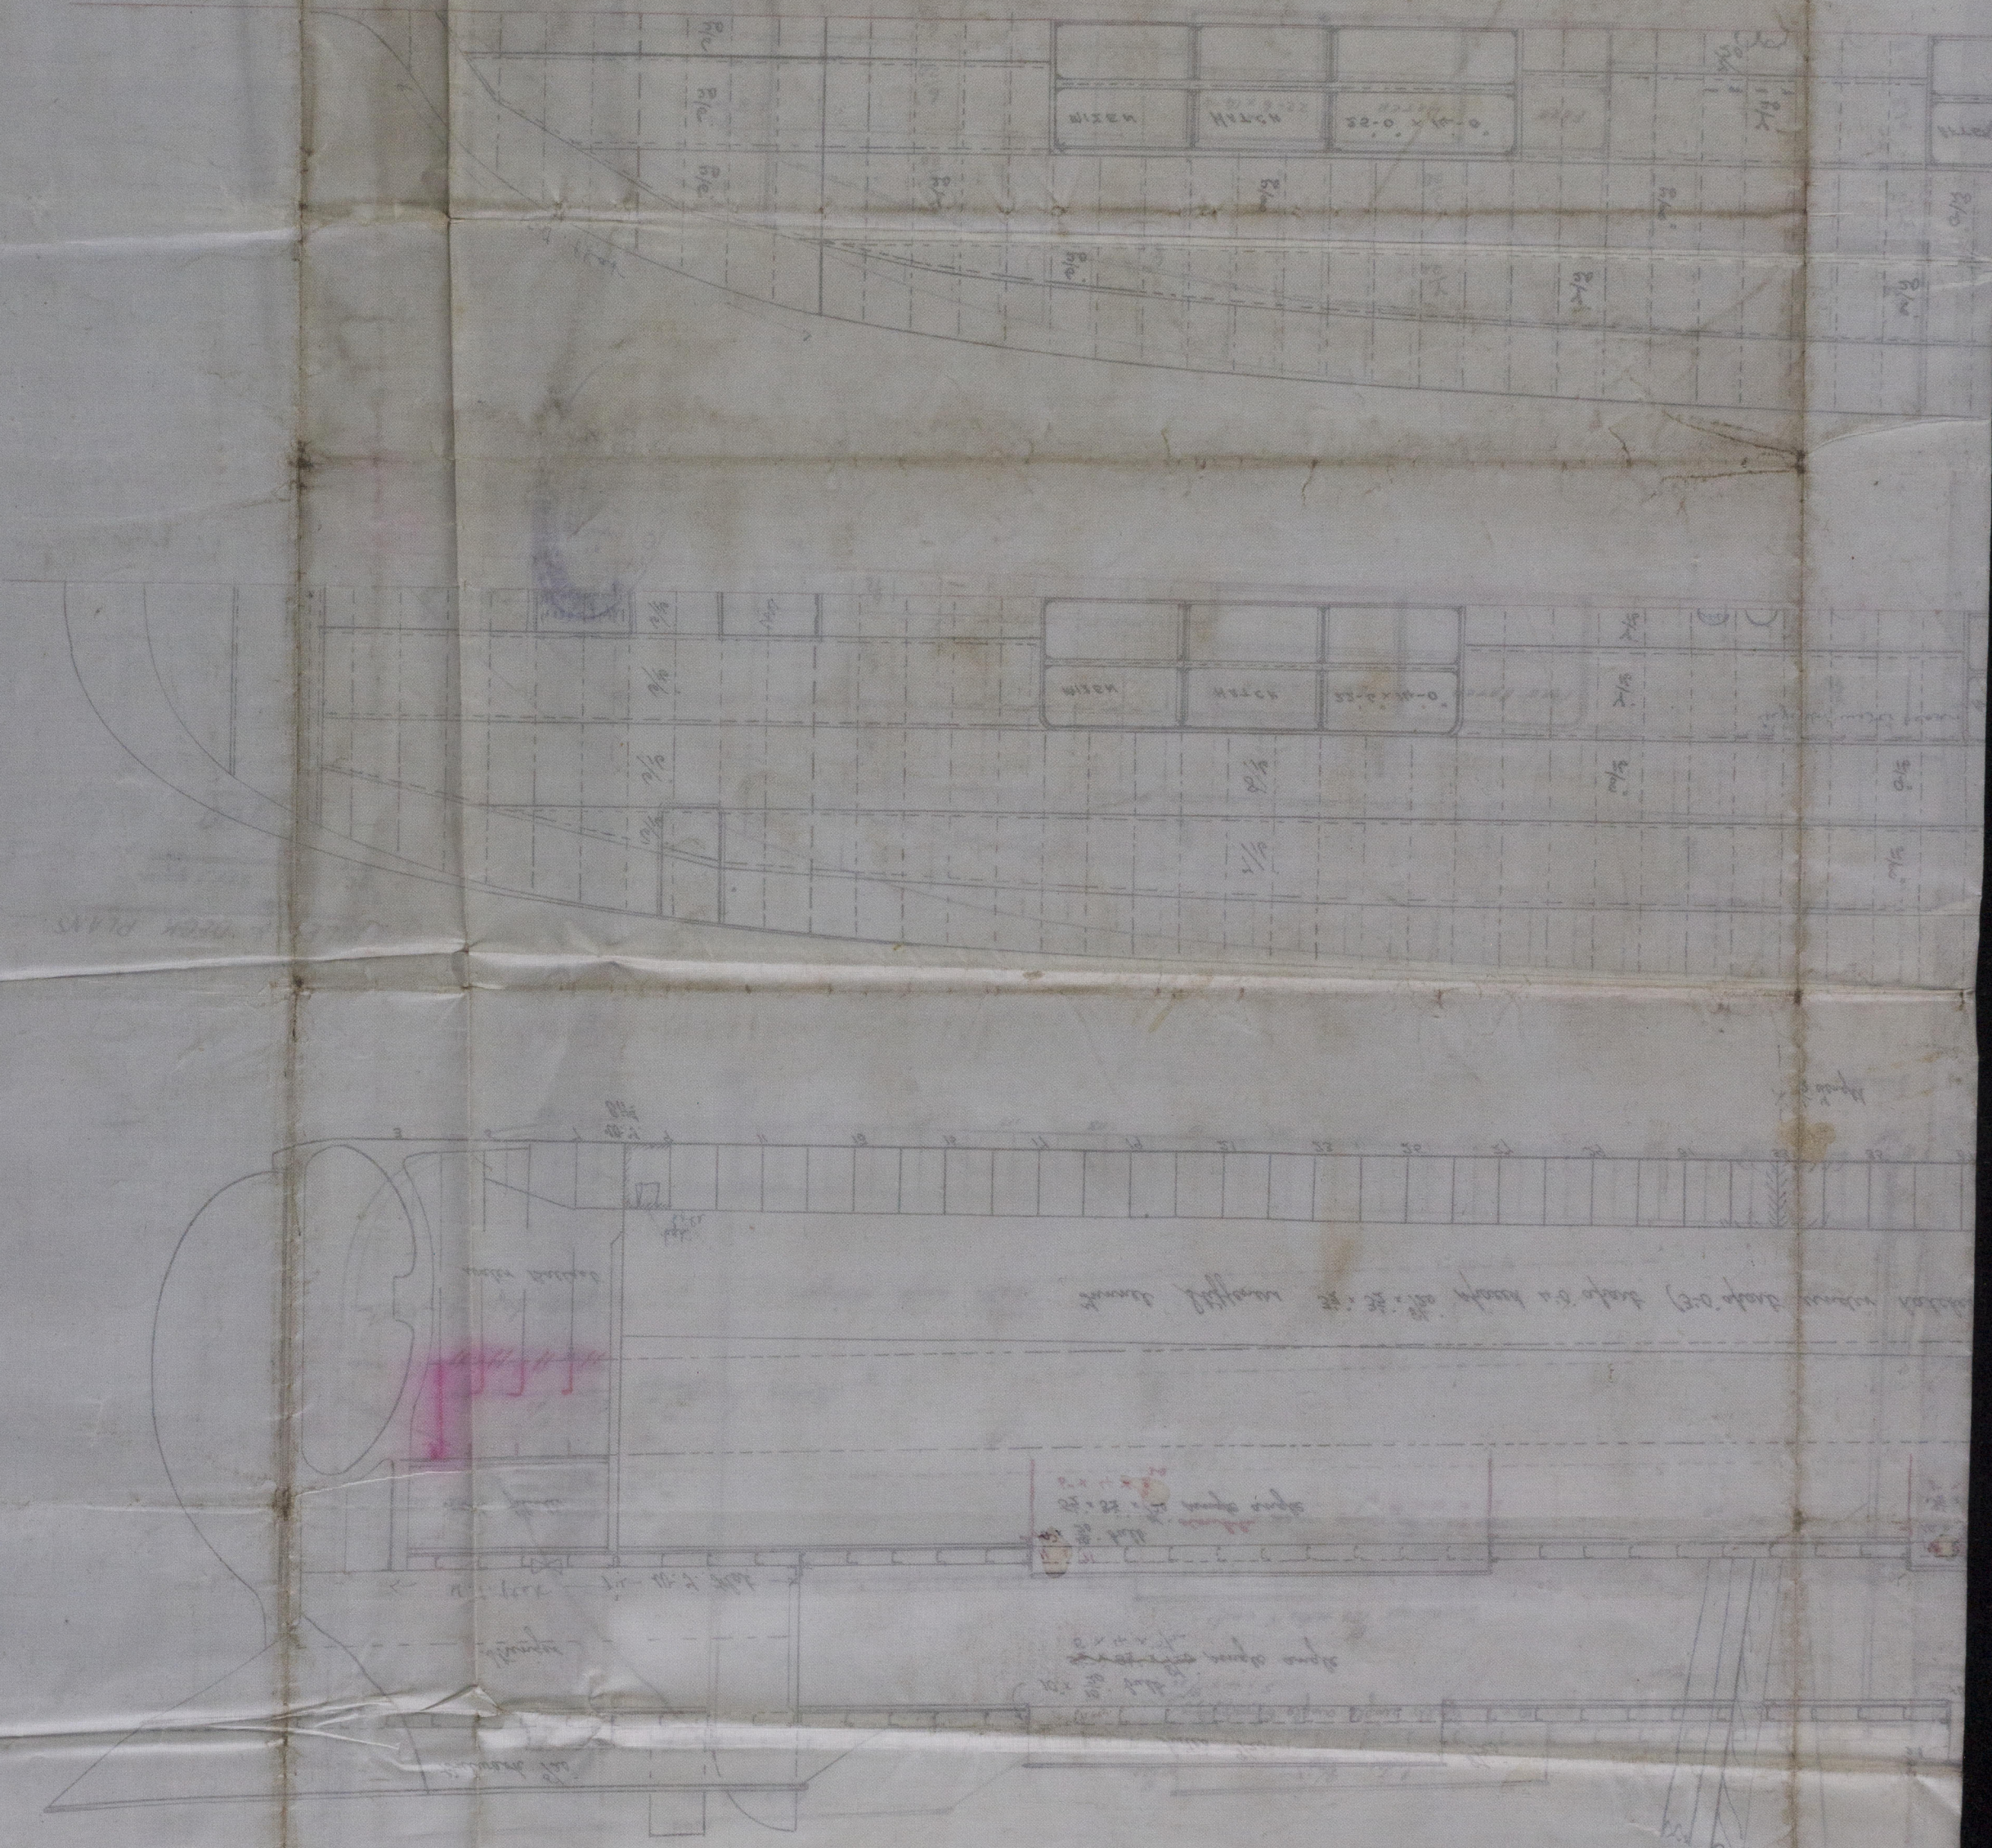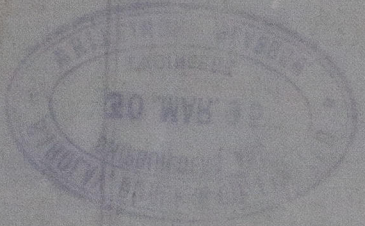

14206

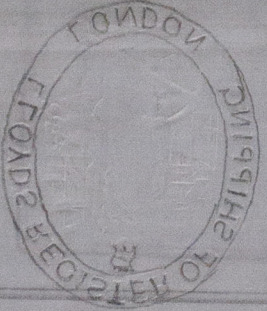

W149-0132

Glo. 4290

"Baillika"



© 2019  
 Lloyd's Register  
 Foundation