

No. 43.)

FALCO

Received at

Office,

189

Lloyd's Register of British and Foreign Shipping.

(Report on Vessel No. 14290, Port Glasgow)

Polycarpus Falco

No. 4918 SHIP FORGINGS OR CASTINGS.

I have to report that the undermentioned Iron or Steel Forgings or Castings, manufactured by Messrs Robt Kerr & Sons of Irvine for the Vessel No. 402, being built by Messrs Barclay Curle & Co of Glasgow have been inspected by me as set forth below, and found to be, so far as can be seen, Sound & efficient

on Forgings.

Lloyd's

No. 4918

W H

William Hamilton

Glasgow

21/8/95

STERN FRAME.

RUDDER FRAME.

STEM.

Material*

made


Dimensions

Process on Inspection

When Inspected

Scrap iron
Forged
10 ft 6
Forging & smithing
27/5/95 to 19/8/95

SKETCHES OF FRAMES SHOWING POSITION AND DESCRIPTION OF WELDS OF FORGINGS, OR PARTICULARS OF TESTS APPLIED TO CASTINGS.

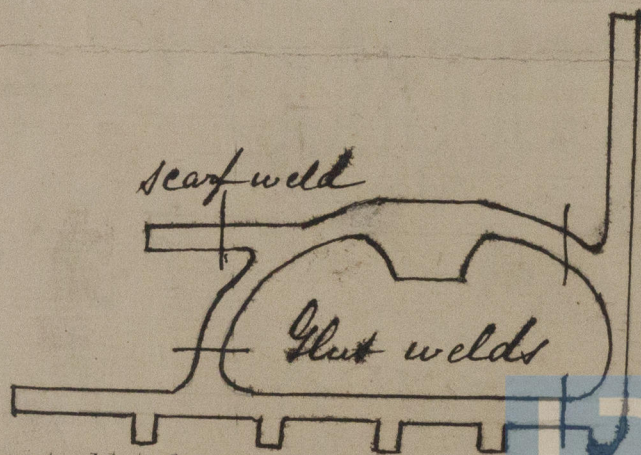

Fee (if any chargeable) £

To be paid at

* If of Iron, state whether scrap or puddled Iron.