


PARTICULARS FOR FREEBOARD.

Coefficient	.153.
Length L.W. line	410'-0"
Sheer Aft	60'
• 1/6 From A.P.	26 3/4
• 1/3 " "	6 3/4
• Midships	—
• 1/31 From F.P.	13 1/4
• 1/6 " "	52 1/2
• Forward	118"


PROFILE.
M.S. No 425. - 424-8
Scale 1/8" = ONE FOOT.

 

APPROVED for 424-8
LLOYD'S REGISTER OF SHIPPING
11/11/39

APPROVED
LLOYD'S REGISTER OF SHIPPING
11/11/39

PLAN OF STRENGTHENING OF BOTTOM FORWARD
AND PAINTING ARRANGEMENT WILL BE SUBMITTED.

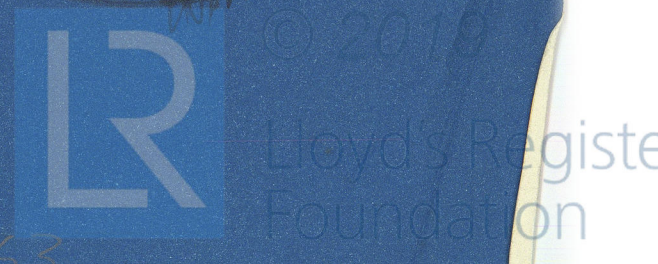

(2)

C. Connell & Co Ltd

Nº 425 14/8

Profile.

Glasgow Report 5852/
(Belin? Feb.).

Ibd

GLASGOW REPORT Nº 60729



425 "Bhima"

GLASGOW REPORT Nº 60930

427 Ibd - NDWS.

GLASGOW REPORT Nº 61771

Mr. Indus.

GLASGOW REPORT Nº 61982.

428 Suttley

GLASGOW REPORT Nº 62180

W149-0163



© 2019

Lloyd's Register
Foundation