



76.6.06

W. 21/2
p. 21/2
W. 21/2

PROFILE AND DECK PLAN
STEEL SCREW TRAWLER
S.S. N° 379

DIMNS: LEN 128'4" x 22'0" x 11'6" DEPTH TO TOP OF FLOOR
SCALE 1/4" = ONE FOOT.

COCHRANE & SONS
IRON AND STEEL
5596 22/6/06
S. 22/6/06
S. 22/6/06

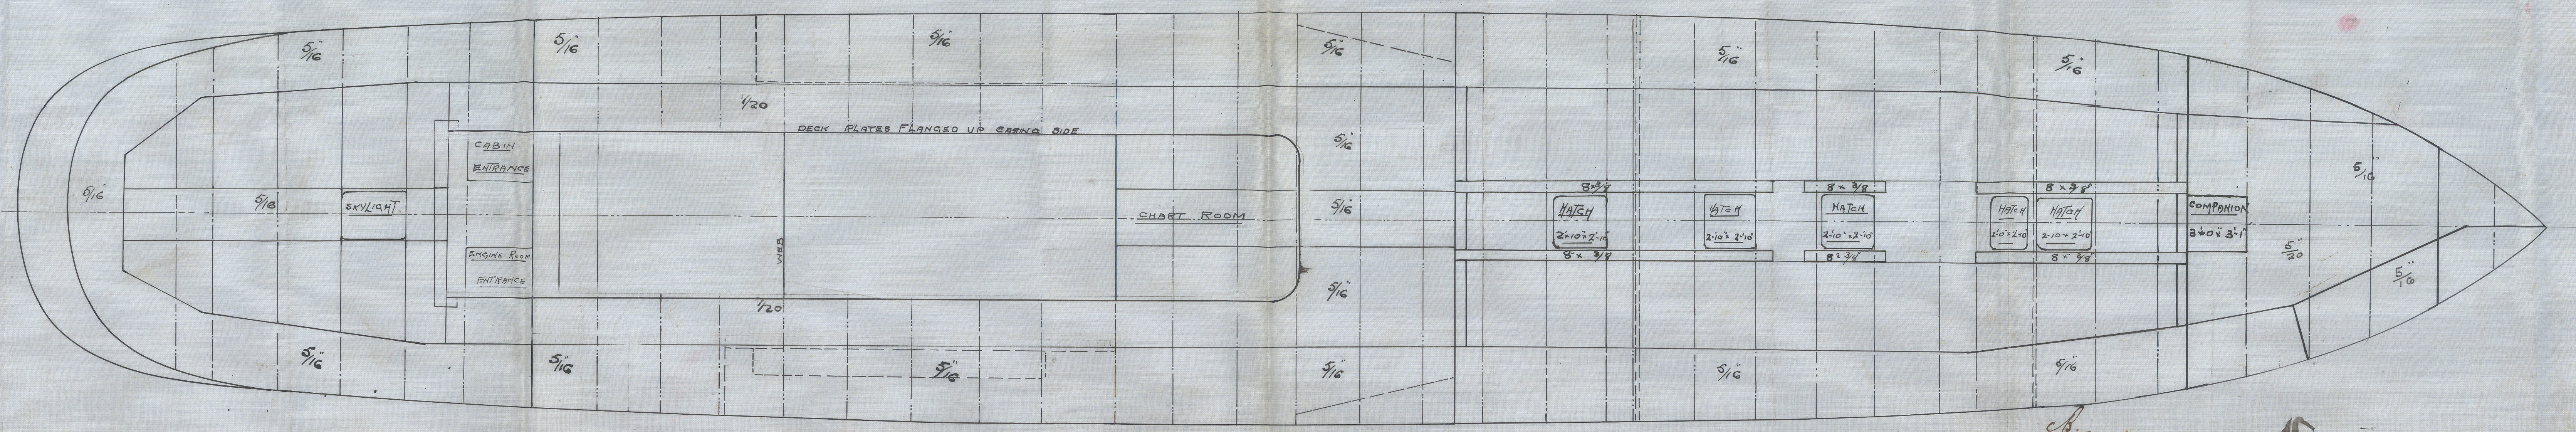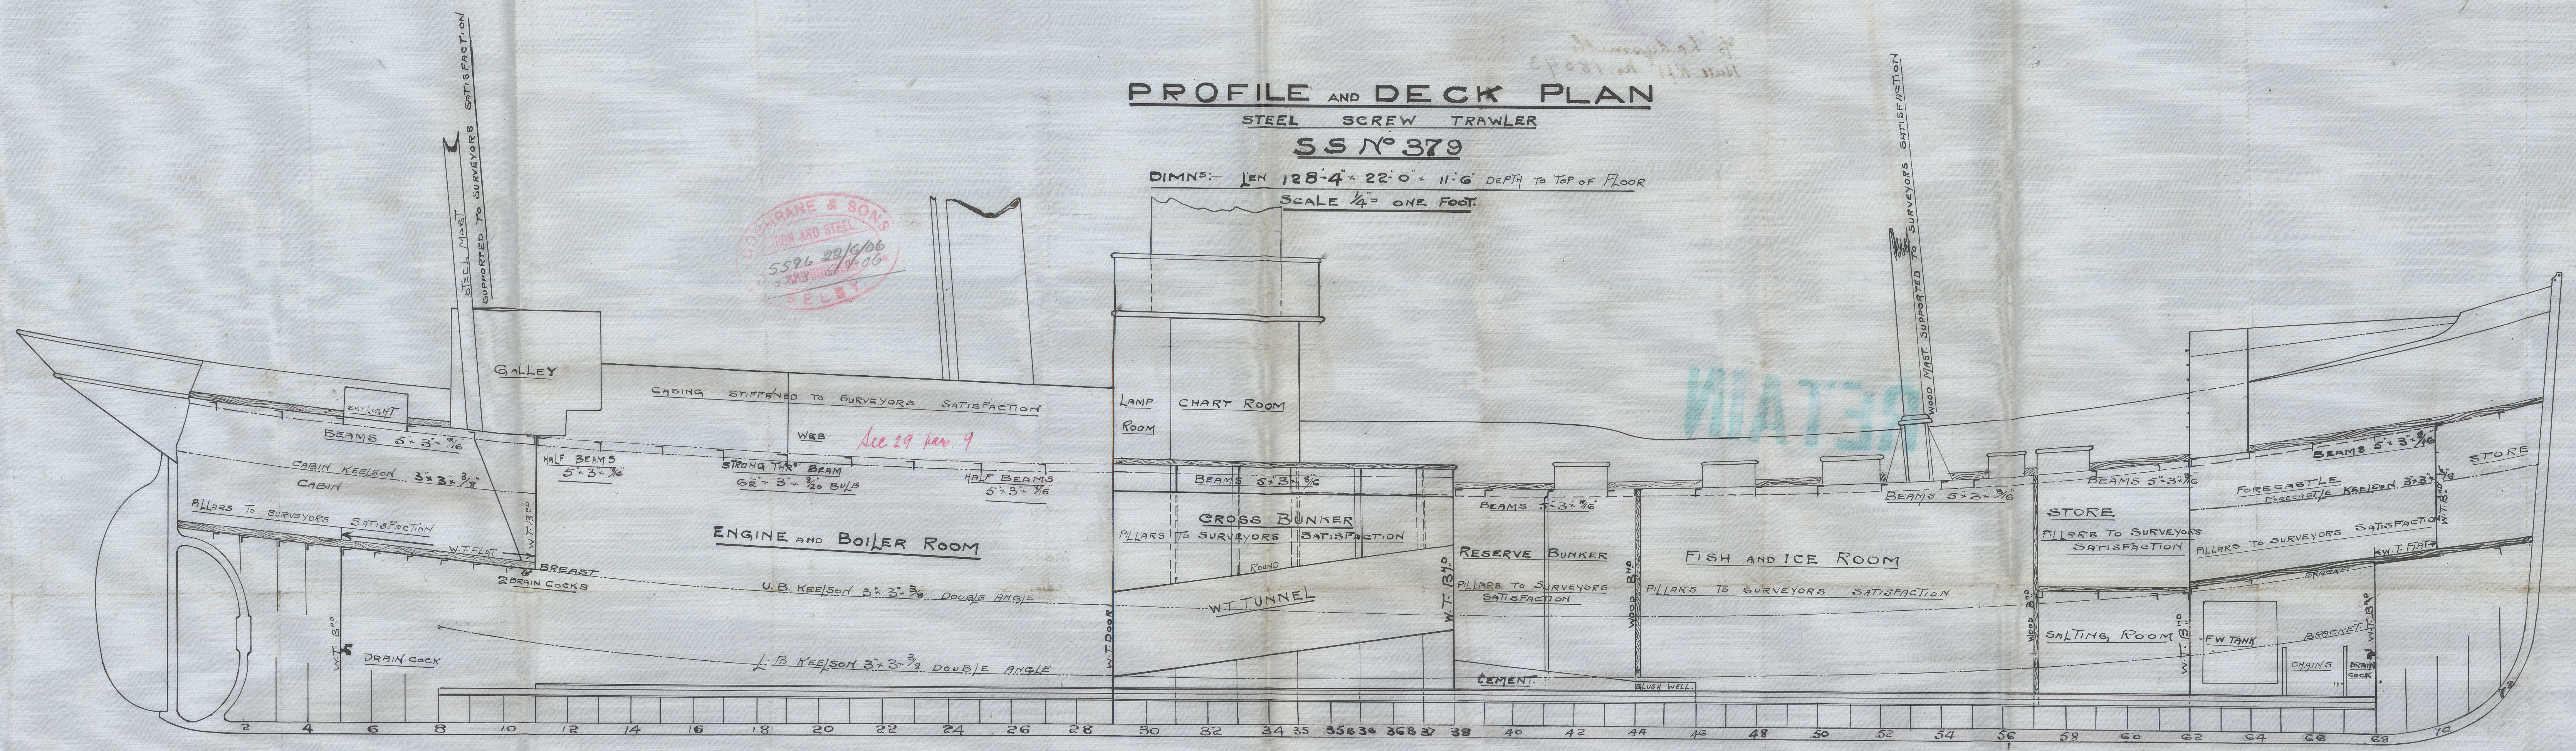

W. 21/2
p. 21/2
W. 21/2

Cochran & Sons

No 349

Amended plan of
Profile & Decks

s/s Ladysmith
Hull Rpt No. 18593

LEO AND DECK PLAN

FEEL SCREW TRAWLER

22 No 379

158'-4" x 55'-0" - 11'-6" DEPTH TO TOP OF FLOOR

SCALE 1" = ONE FOOT

RETAIN



© 2021

Lloyd's Register
Foundation

W1444-0036