

DIMENSIONS.

DIMENSIONS.

1/2" lining plate fitted
between tube nests
on front tube plate

CHARLES D HOLMES & CO
ENGINEERS & BOILER MAKERS
HULL 2-10-05

STEEL BOILER № 796


13' 0" dia Inside, 10' 0" Out length
~~200 lbs~~ 180 lbs W.P.

1
796
11/1/06


Messrs
Charles D. Holmes & Co.

Boiler No 796
of "Lady Smith"
Hull Report No. 18593

No 1528
Lloyds Test
360 lbs
14.11.06
J.H.

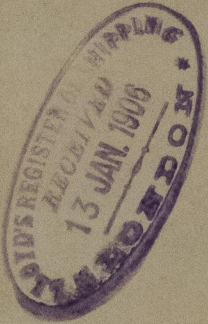

W1494-0037

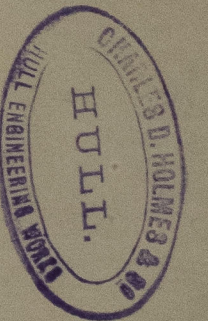

W1494-0037



© 2021

Lloyd's Register
Foundation