

76.6.06


MIDSHIP SECTION

STEEL SCREW TRAWLER

N^o 379

DIMENSIONS: LEN. 128'-4" x 22'-0" x 11'-6" DEPTH TO TOP OF FLOOR 12'-3" MOULDED

SCALE 1/2" = ONE FOOT

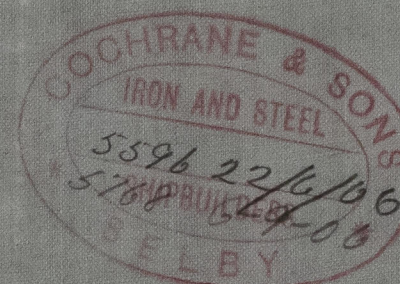

- TO CLASS 100A.1. FOR FISHING PURPOSES
- ENGINE & BOILER CASING AS PREVIOUSLY APPROVED
- DECK PLATED IN WAY OF ENGINE & BOILER CASING

LOYDS NUMERALS

1/2 BREADTH 10.95
1/2 GIRTH 19.0
DEPTH 12.7


PROPORTIONS

42.65 1ST NO
127.20
5425.080.2ND NO
2 1/2" DIA.
DEPTH TO LENGTH 10.01
BREADTHS 6.08
5.80

EQUIPMENT

1ST BOYER 5 1/2 OUNTS. EX. STOCK
2ND " 5 " " " "
3RD " 2 3/4 " " " "
105 FATHOMS 1 1/16" SHORT LINK CABLE.
60 " 6" HAWSER.
60 " 5" WARP.

COCHRANE & SONS
SHIPBUILDERS
SELBY
YORKS

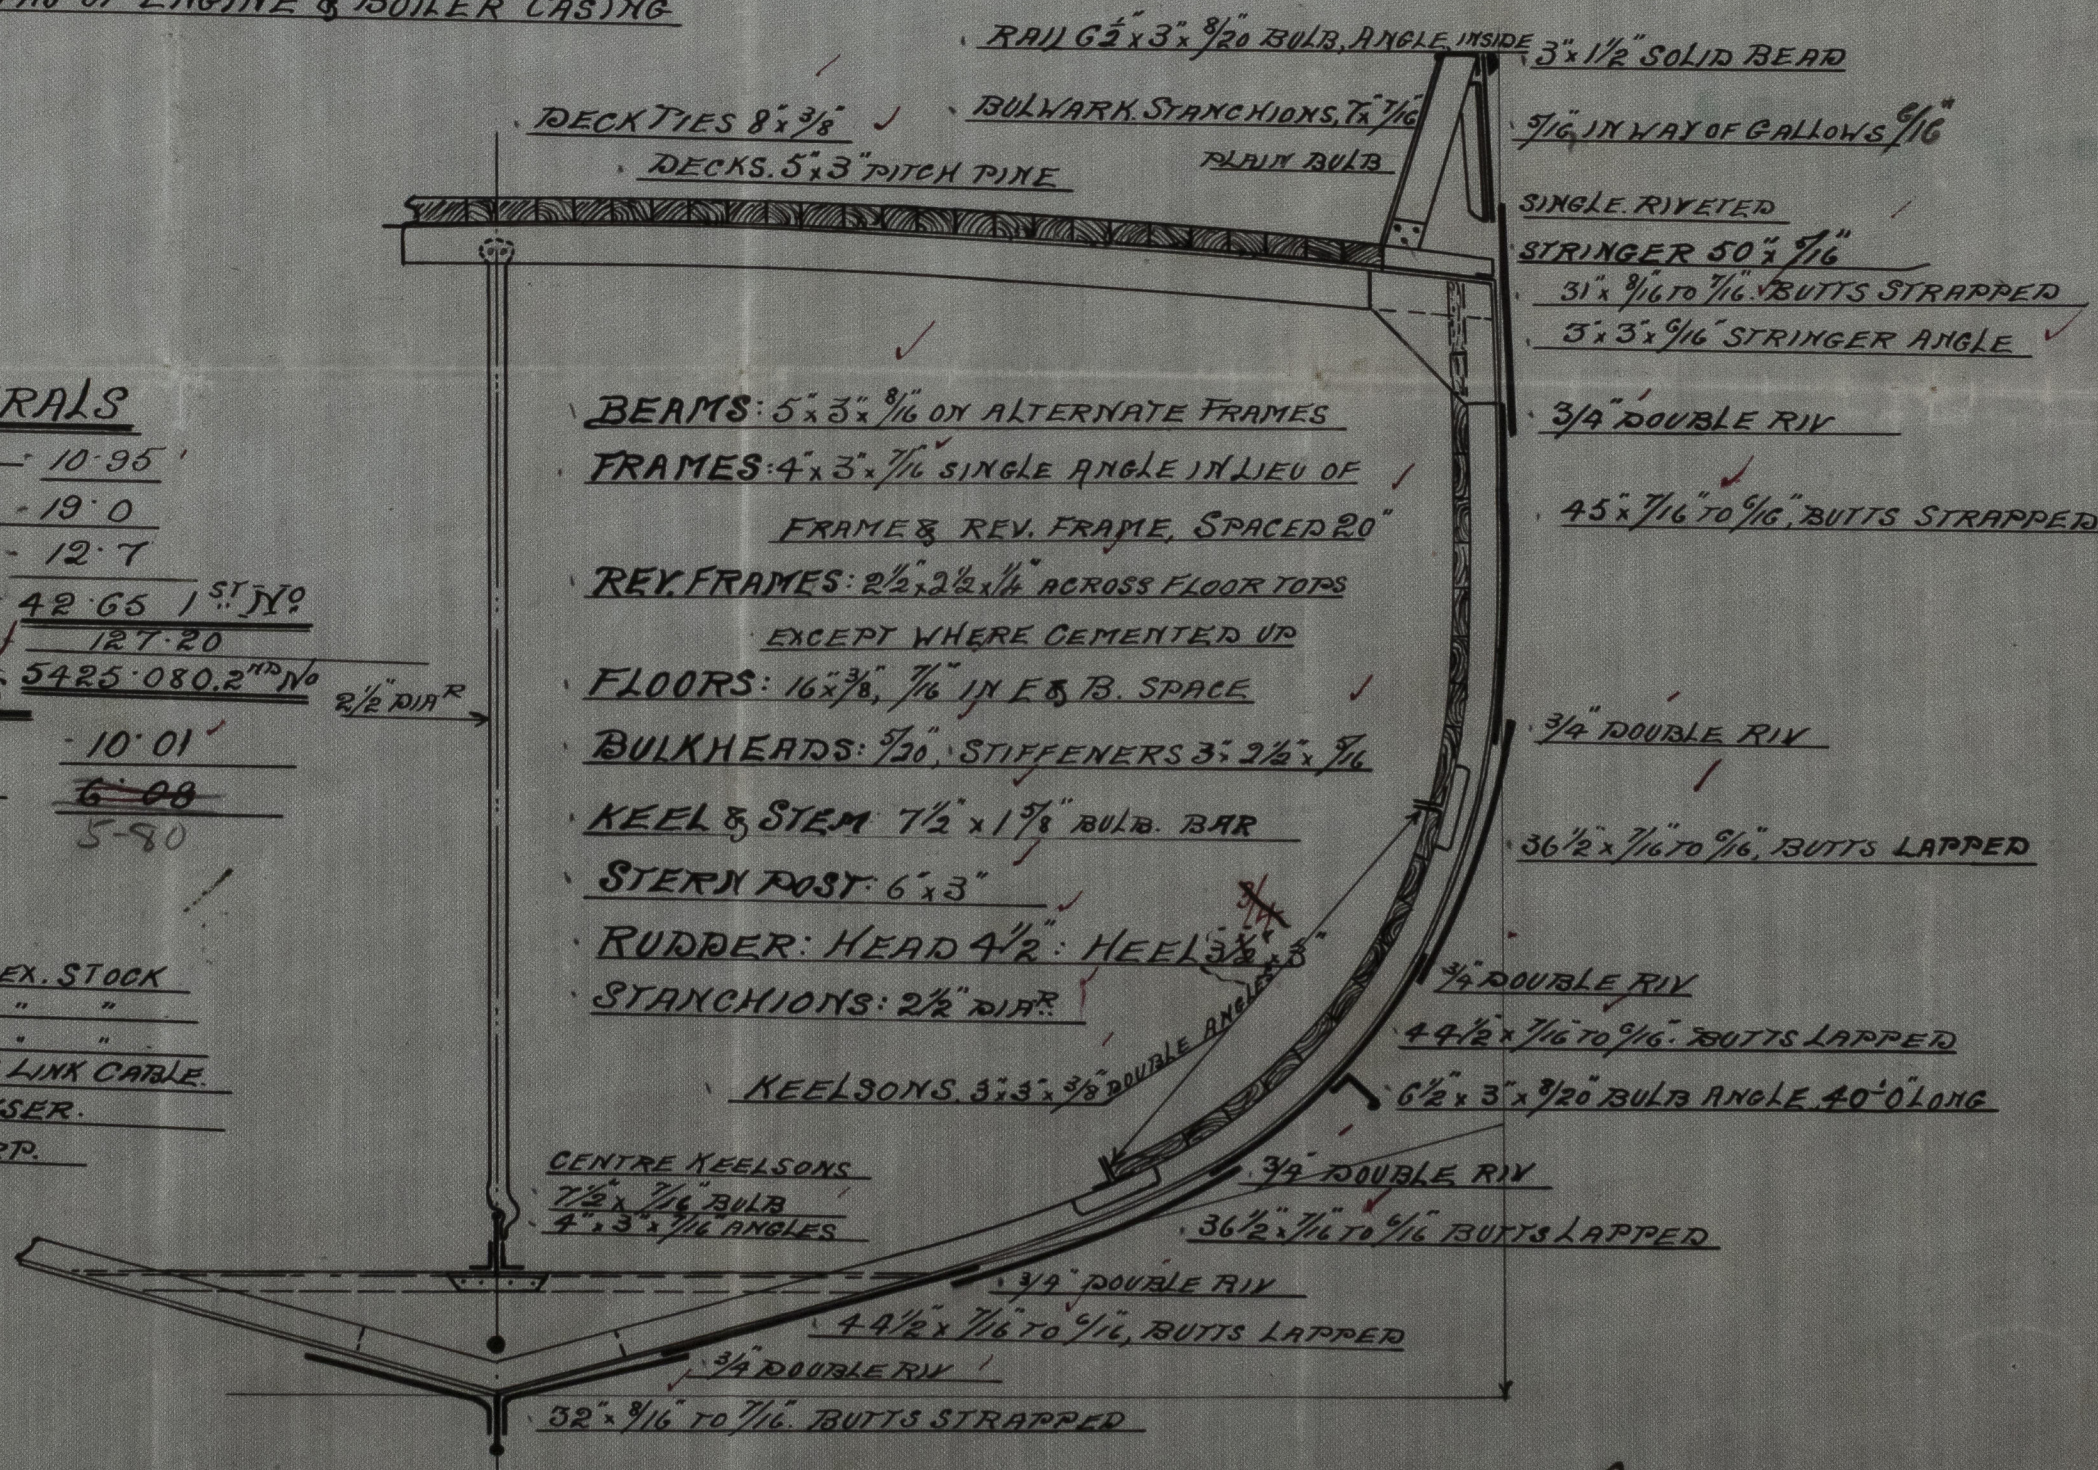

C.B.
76.6.06

Cochrane & Son
No 379.
amended.
Midship Section.
s/s Ladysmith
Hull. Report No.

8100-10038

SHIP SECTION

















Midship Section 379

Midship Section 379

W1494-0038



© 2021

Lloyd's Register
Foundation