

PLAN OF STRENGTHENING AT BRIDGE
ENDS TO BE SUBMITTED.

-DECKS
-S. S. No. 389-
-SCALE $\frac{1}{8}'' = 1'-0''$ -

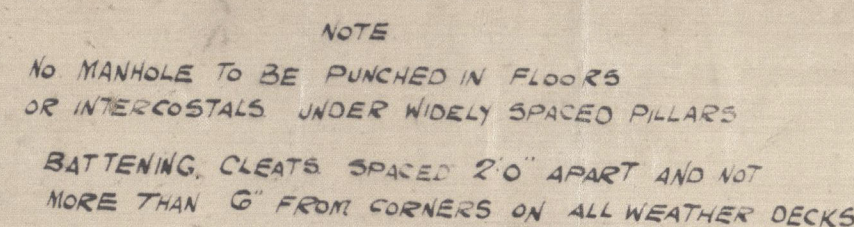


Diagram illustrating the arrangement of battening cleats and hatch coamings on the match end of a ship's hull.

Labels in the diagram:

- BATTENING CLEAT
- MATCH
- HATCH
- COAMING
- B.W.A.
- B.K.
- SKETCH SHIEWING BKTS ON MATCH END COAMINGS

NO. B.A. STIFFENER OR STAY	AT AFT END OF N°4 HATCH	BRID DK
"	3	}
" FORE	2	
" AFT	2	
" FORE	2	
" AFT	3	
" AFT	1	}
" FORE	1	

UPPER DK.

SECOND DK.

Decks (as built)

Duncan 389-90

389. S. S. "Chaucer"

Greenock Report N. 19026.

WS. 27



W15-0095

© 2020

Lloyd's Register
Foundation