


SCALE $\frac{1}{4}'' = 1 \text{ FOOT}$

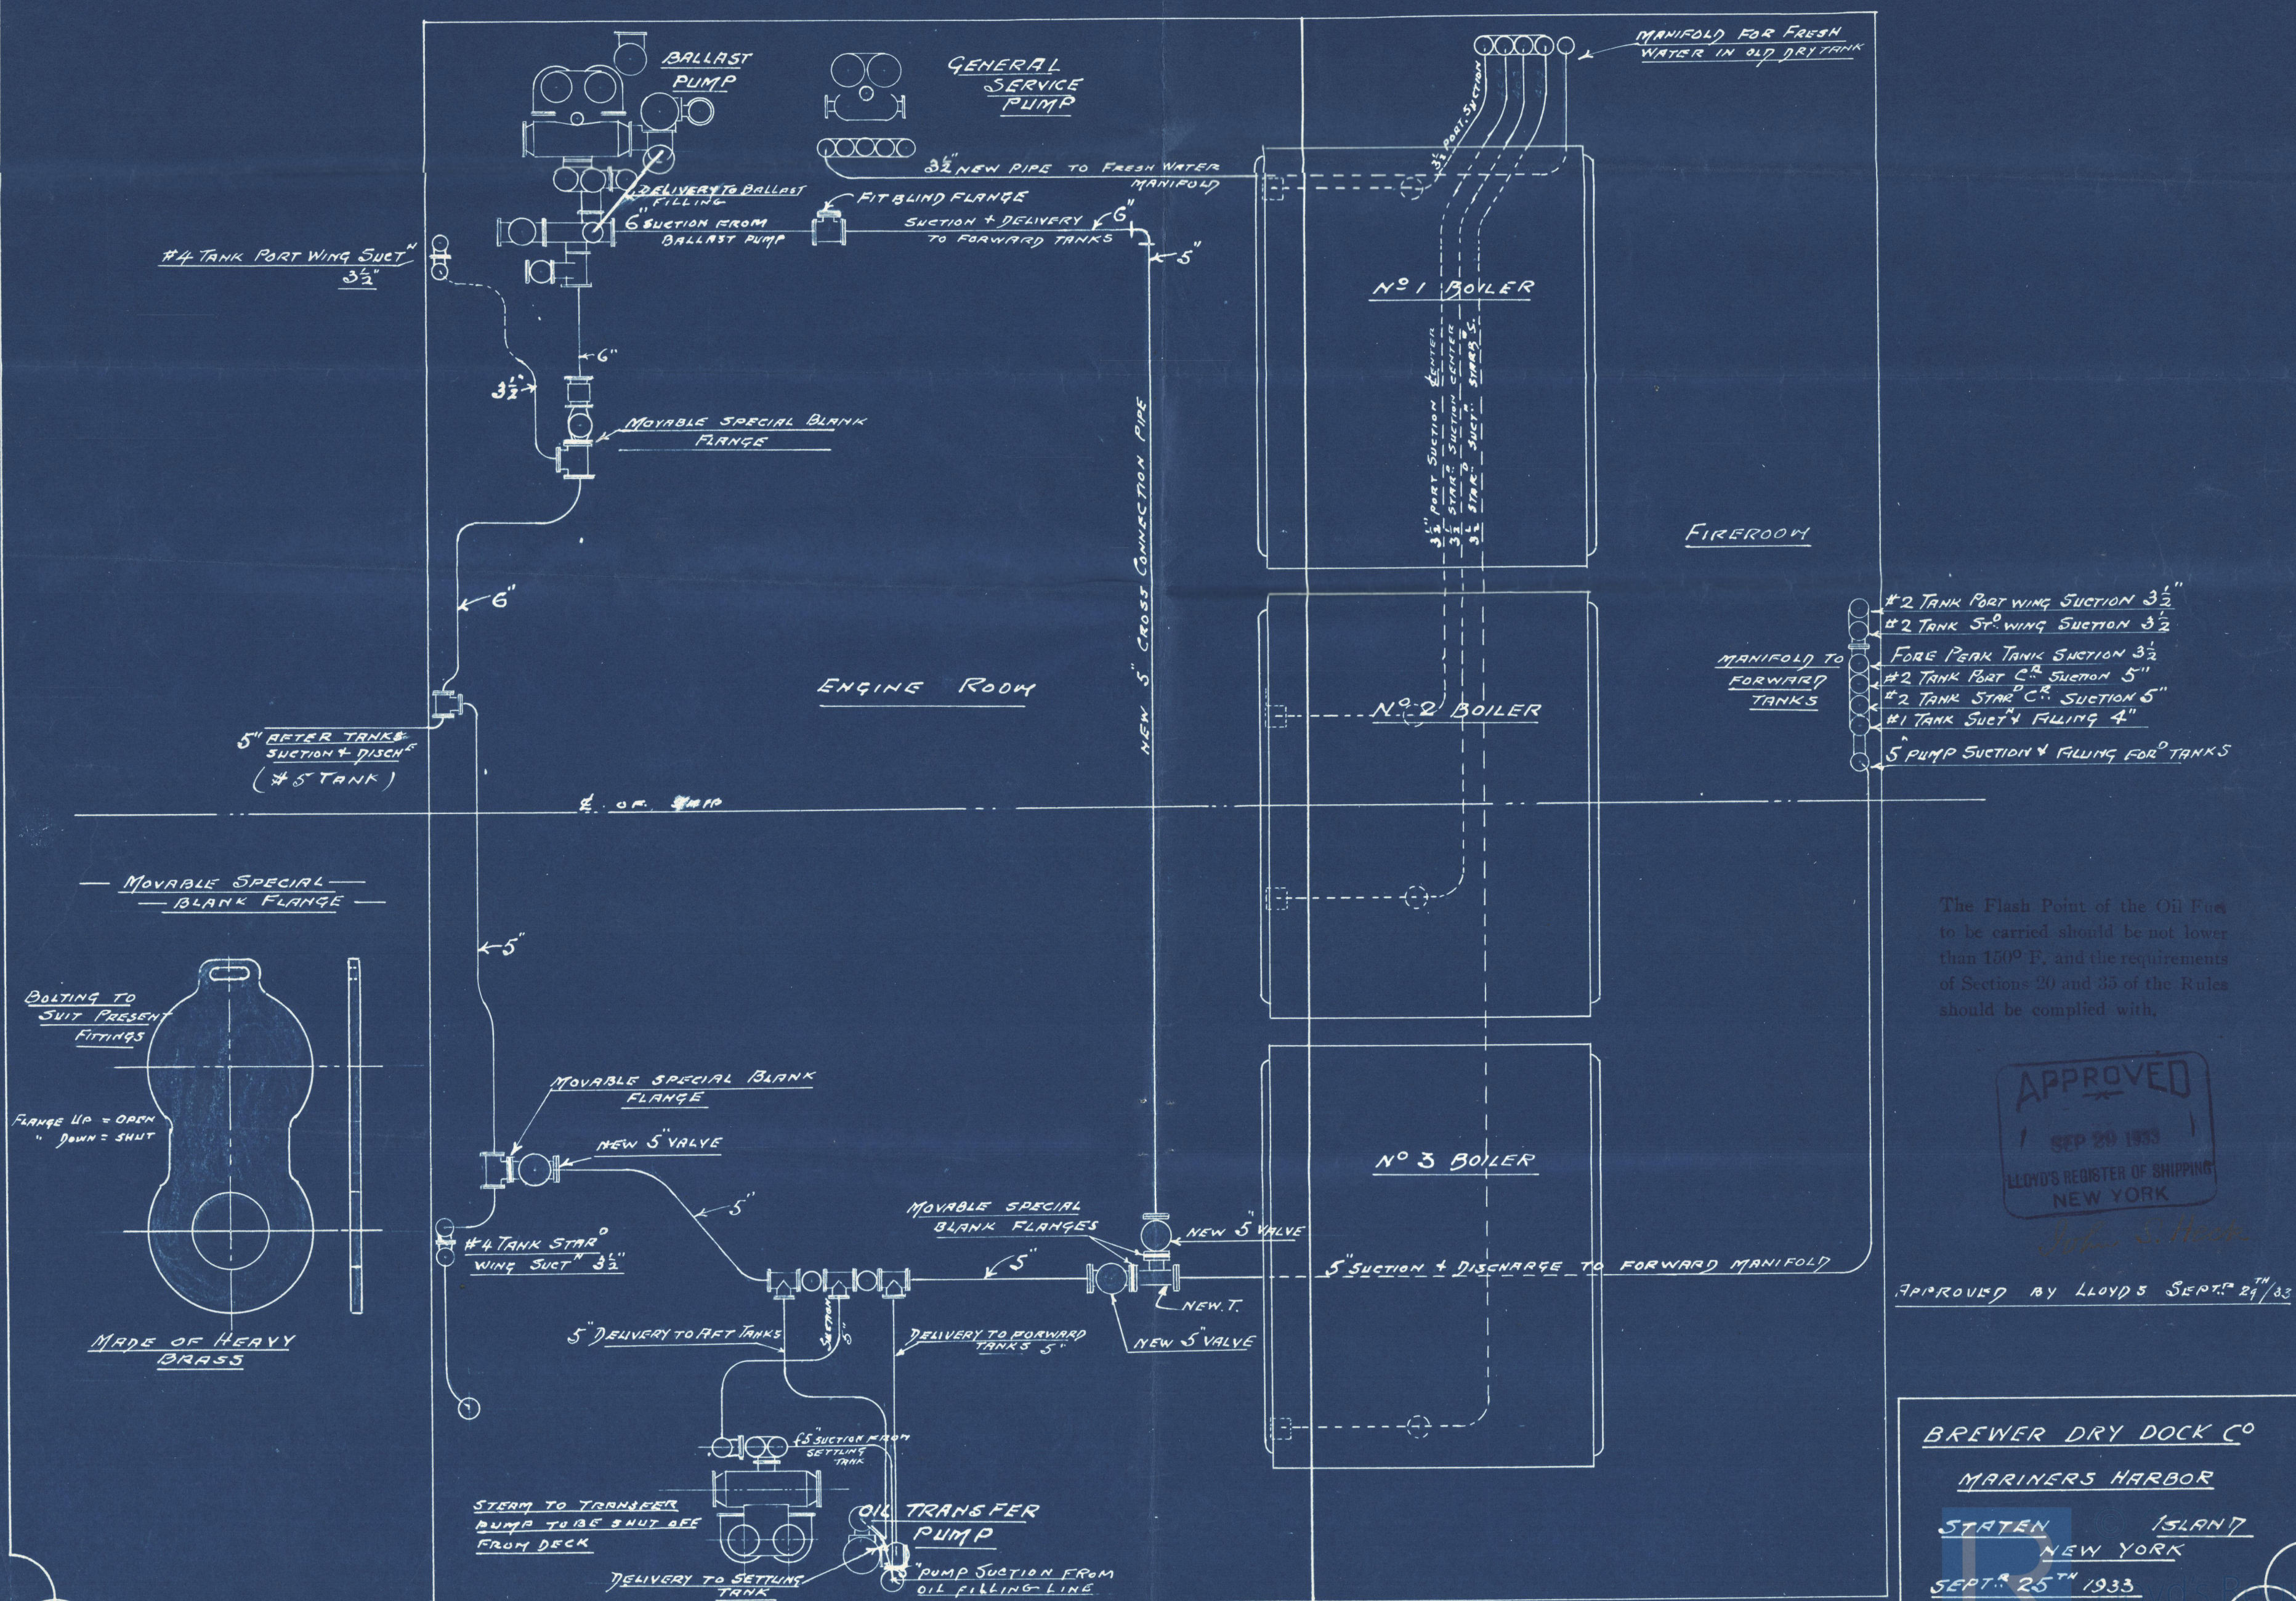

APPROVED BY LLOYD S. SEPT. 29TH/33

BREWER DRY DOCK CO
MARINERS HARBOR
STATEN ISLAND
NEW YORK
SEPT. 25TH 1933

"American
Oricle"

S.S. American Oricle.

New York Sept No 3494

Arrangement for using double bottom
for fuel oil or ballast alternately.

WISO-0142



© 2020

Lloyd's Register
Foundation