



THE WHOLE SYSTEM OF FUEL OIL BURNING TO BE INSTALLED IN ACCORDANCE WITH THE RULES & REGULATIONS OF LLOYDS & U.S. STEAMBOAT INSPECTION SERVICE

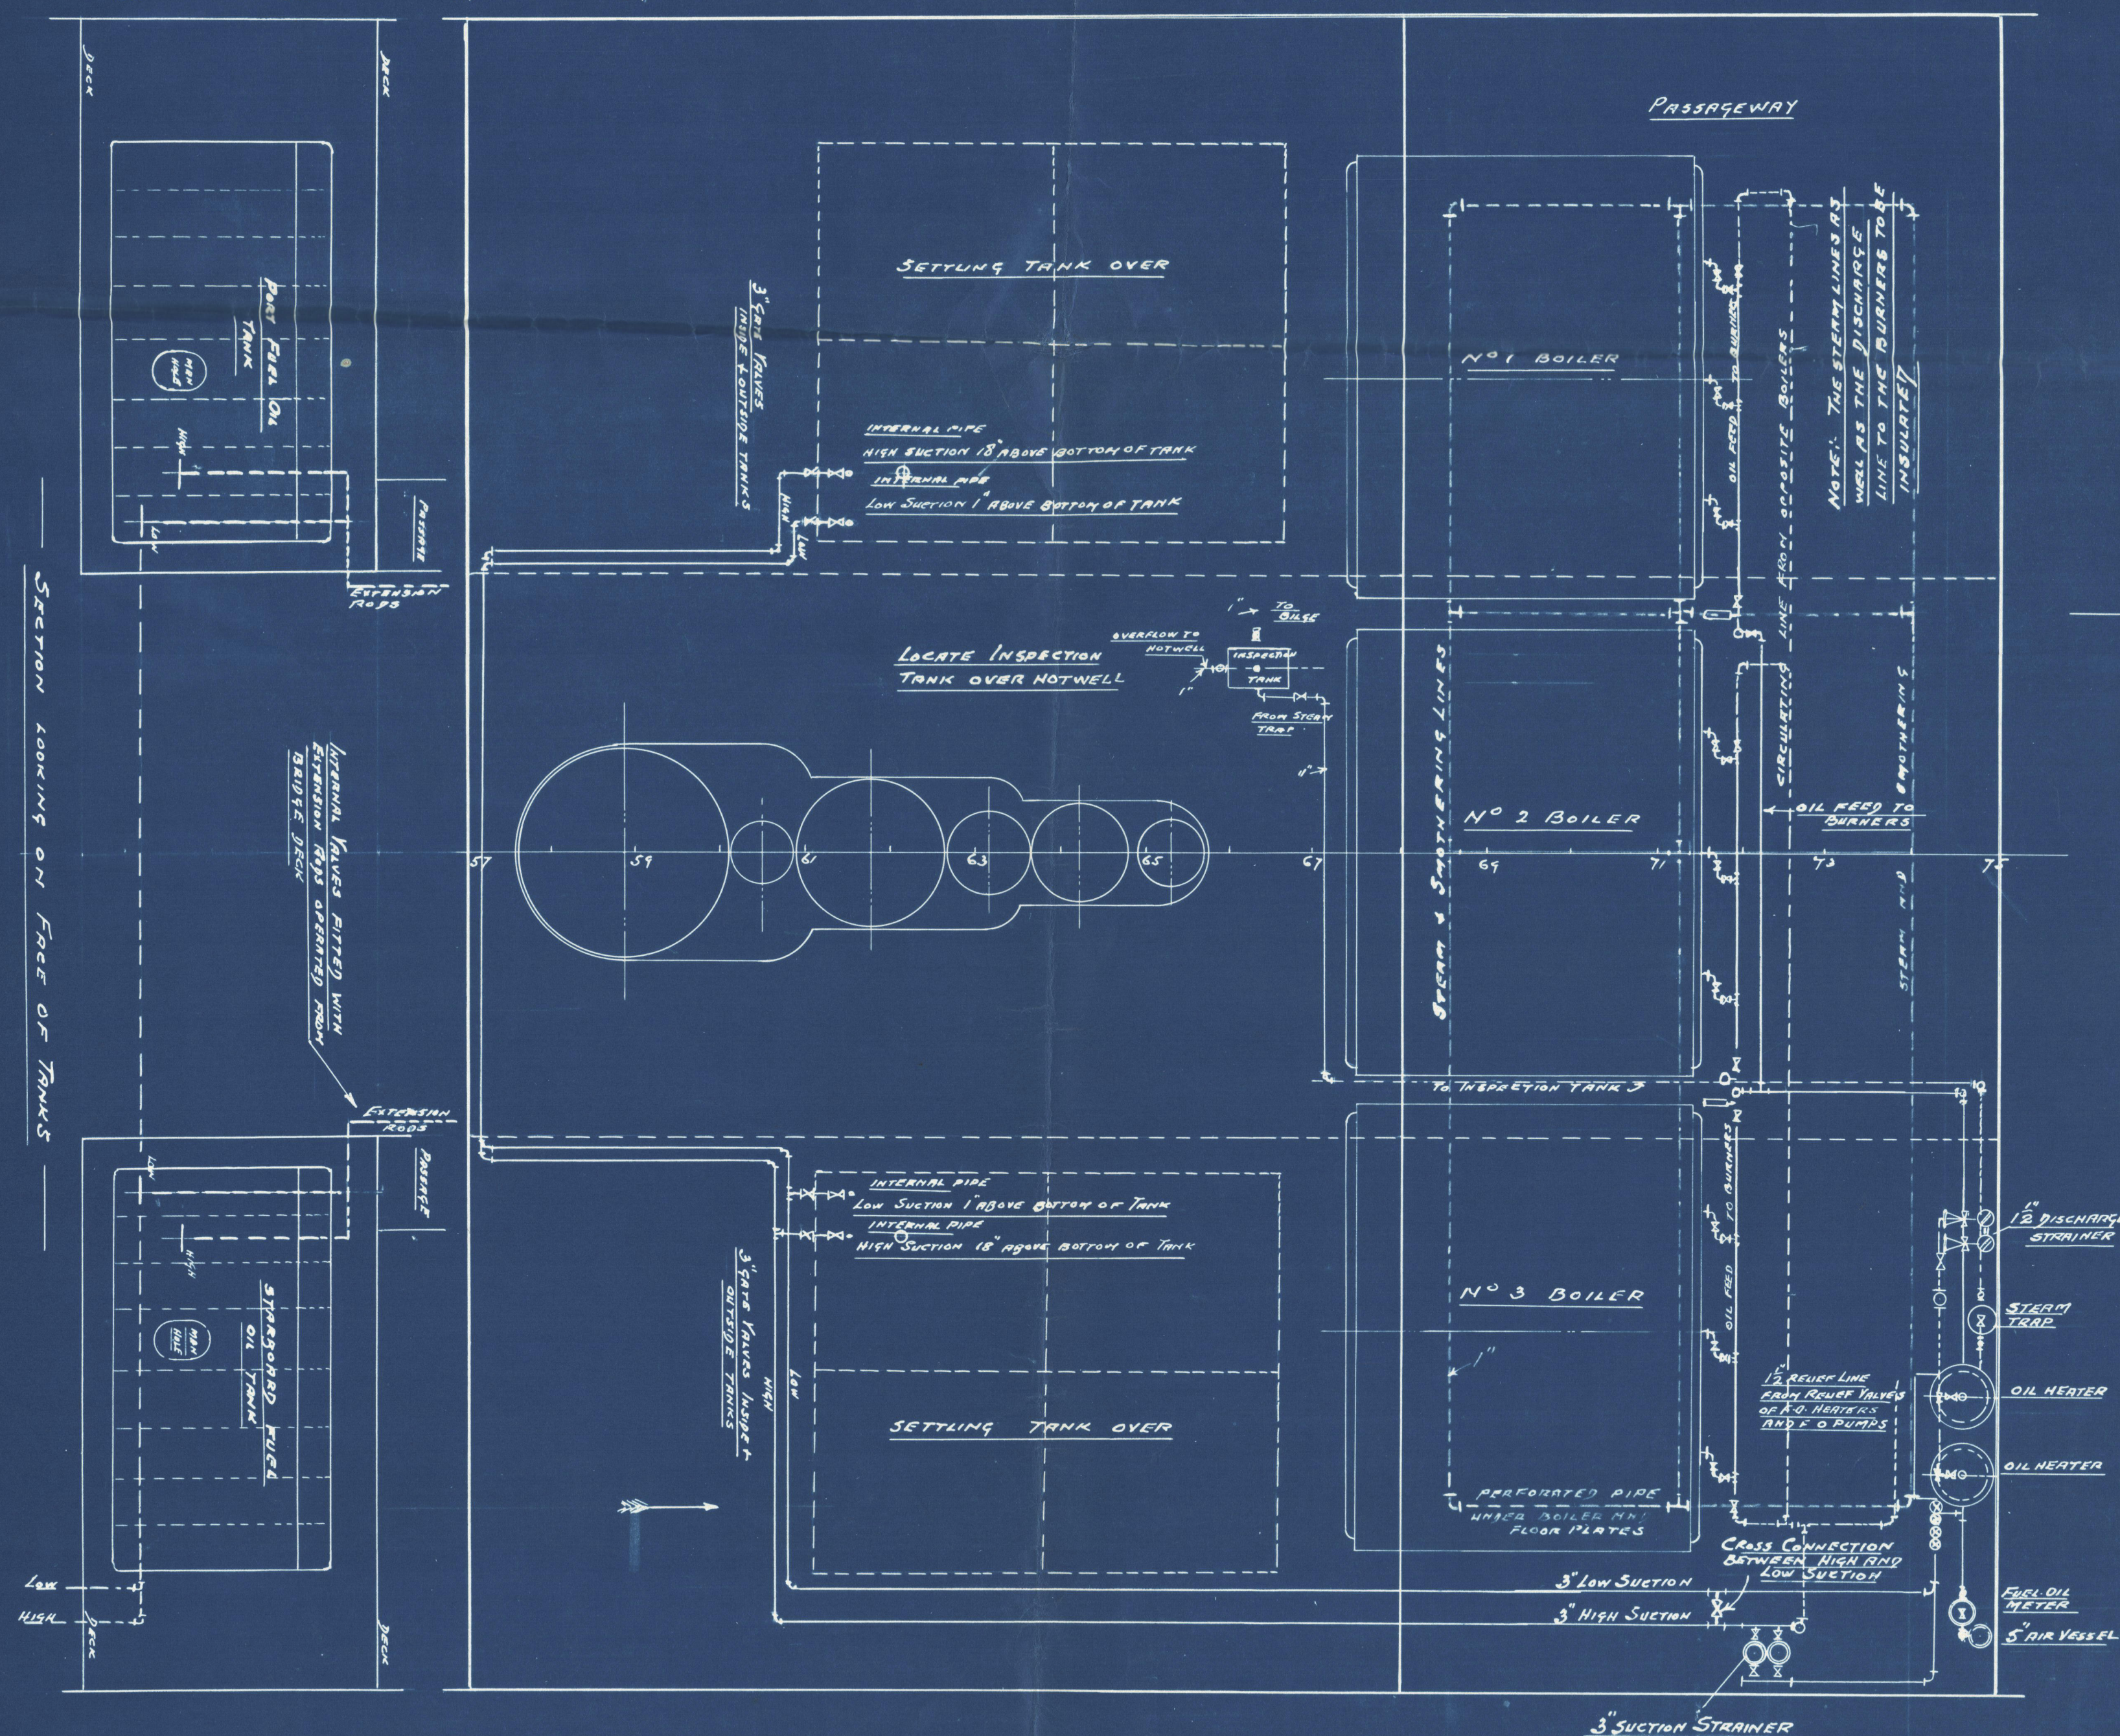

DIAGRAMMATIC LAYOUT OF FUEL OIL BURNING INSTALLATION STEAM SMOTHERING &c

SCALE APPROX $\frac{1}{4}'' = 1 \text{ FOOT}$

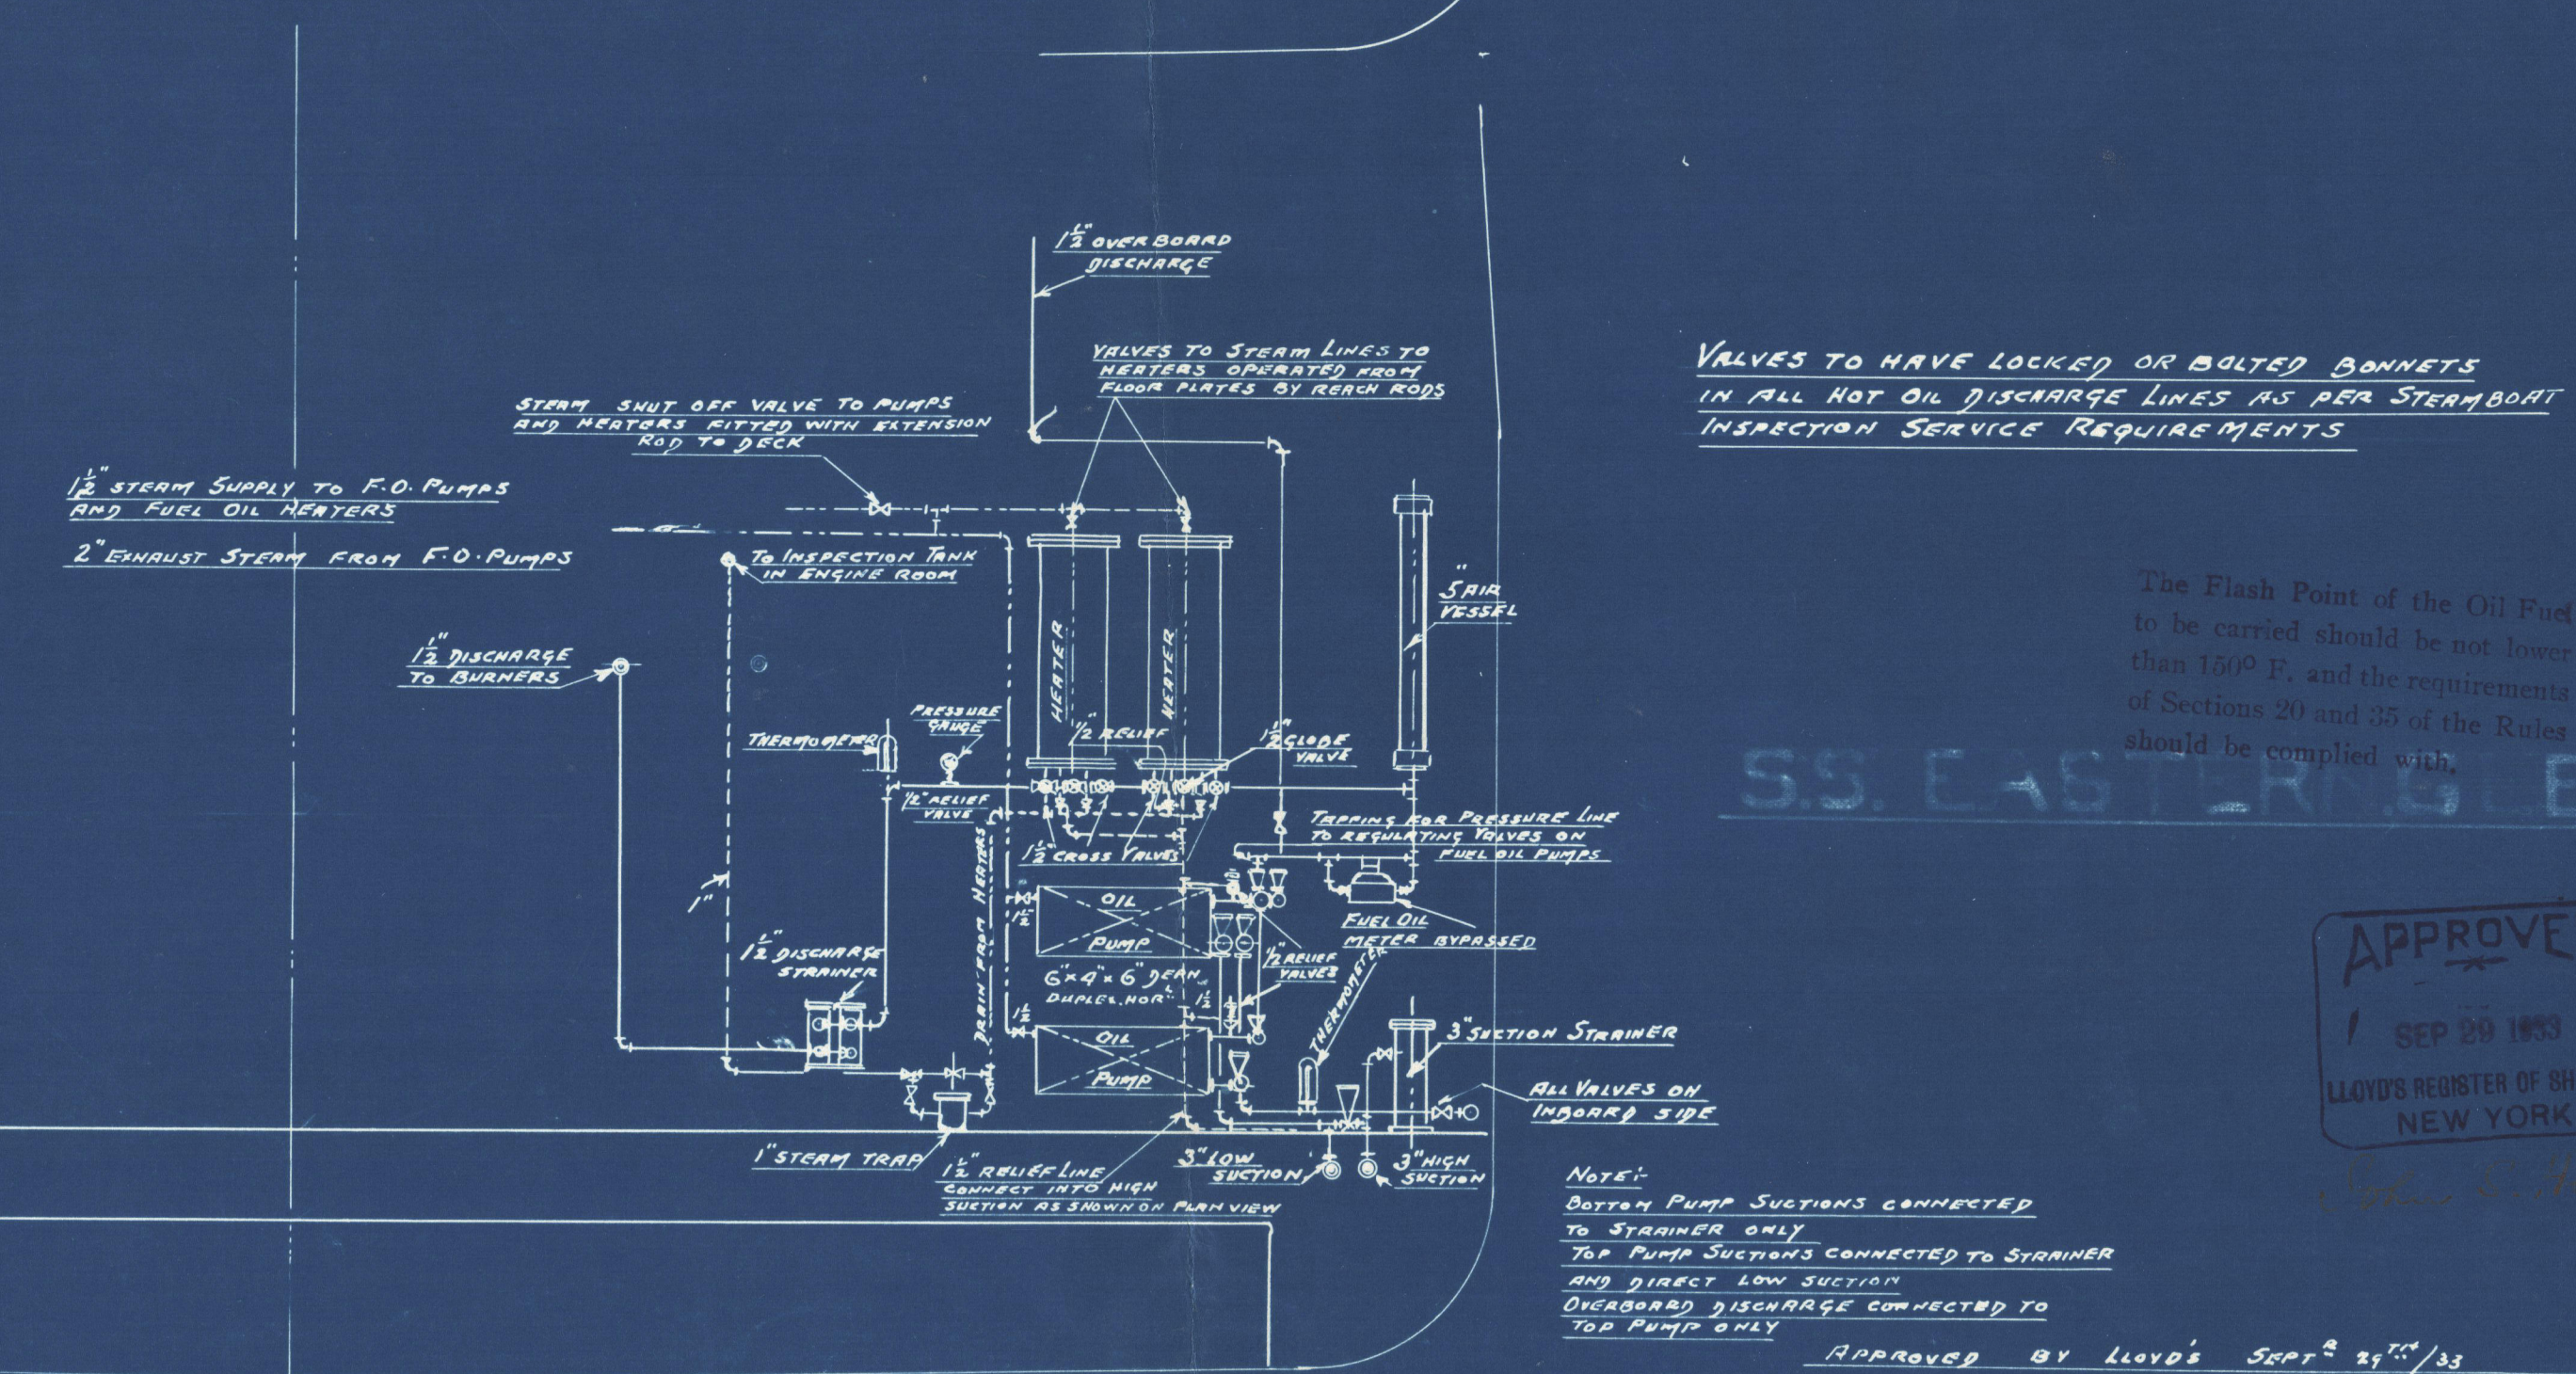

NOTE:
BOTTOM PUMP SUCTIONS CONNECTED
TO STRAINER ONLY
TOP PUMP SUCTIONS CONNECTED TO STRAINER
AND DIRECT LOW SUCTON
ONBOARD DISCHARGE CONNECTED TO
TOP PUMP ONLY

APPROVED BY LLOYD'S SEPT^R 29TH/33

BREWER DRY DOCK CO
MARINERS HARBOR
STATEN ISLAND NEW YORK
SEPT^R 25TH 1933

'American Oriole'

'American Oriole'

Nyk. Rept 34911

Diagrammatic layout of FO. Argyl

W1150-0143



© 2020

Lloyd's Register
Foundation