

25.6.12



PROFILE & DECK

Nº 544.

DIM. 80'-0" x 17'-0" M¹⁰ x 10'-0" M¹⁰

SCALE $\frac{1}{4}$ " INCH = 1 FOOT.

PLAN No. 1635
FOR ENCLOSURE TO
Messrs Lloyd's Surveyors
Hull FROM
COCHRANE & SONS,
SHIPBUILDERS, SELBY.
DATE 20/6/12. RK

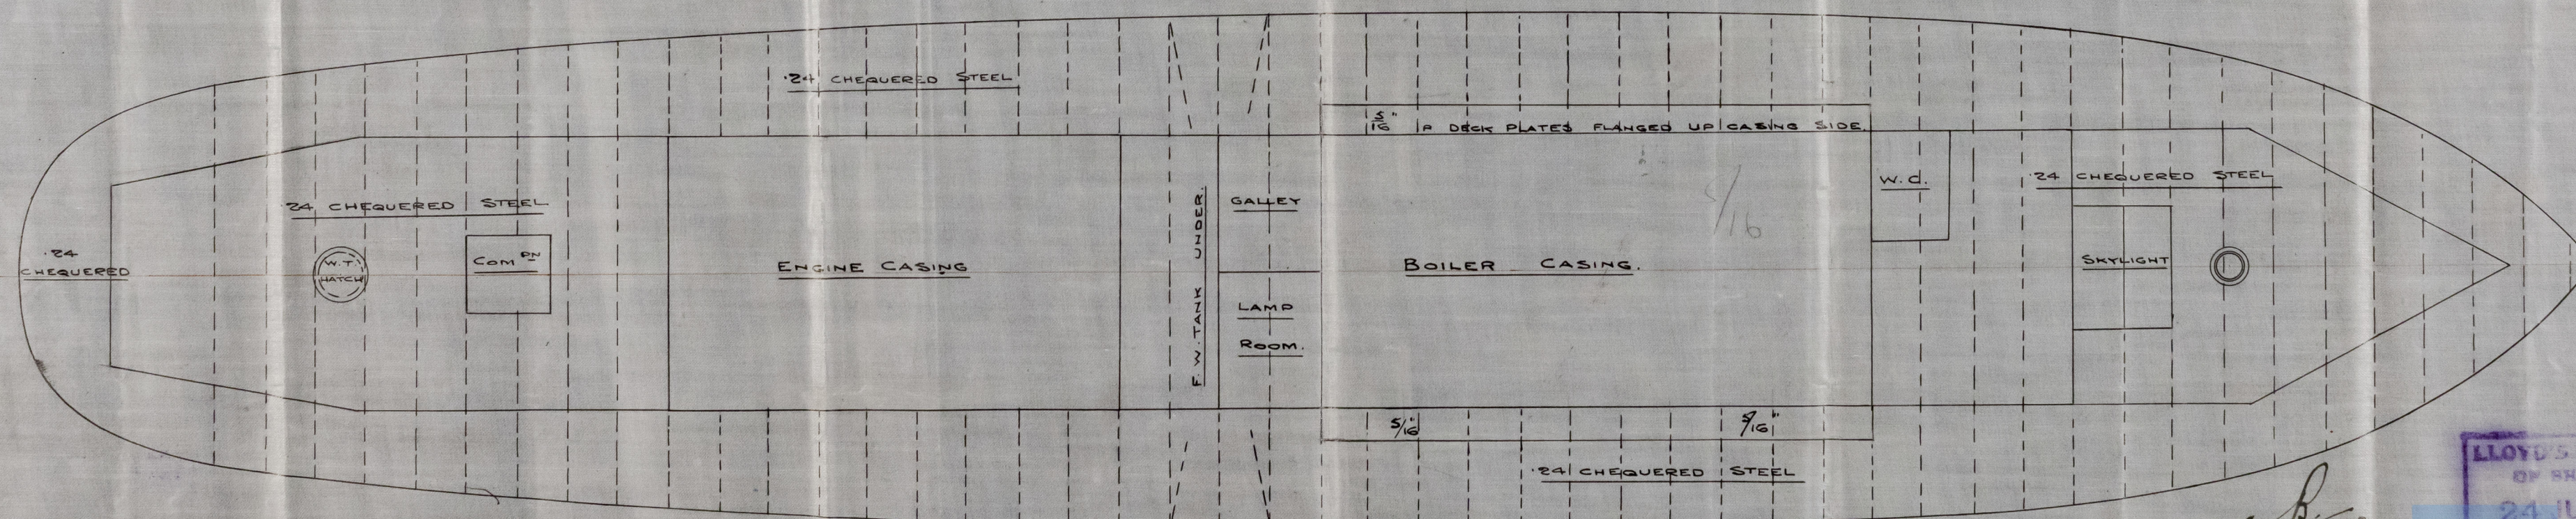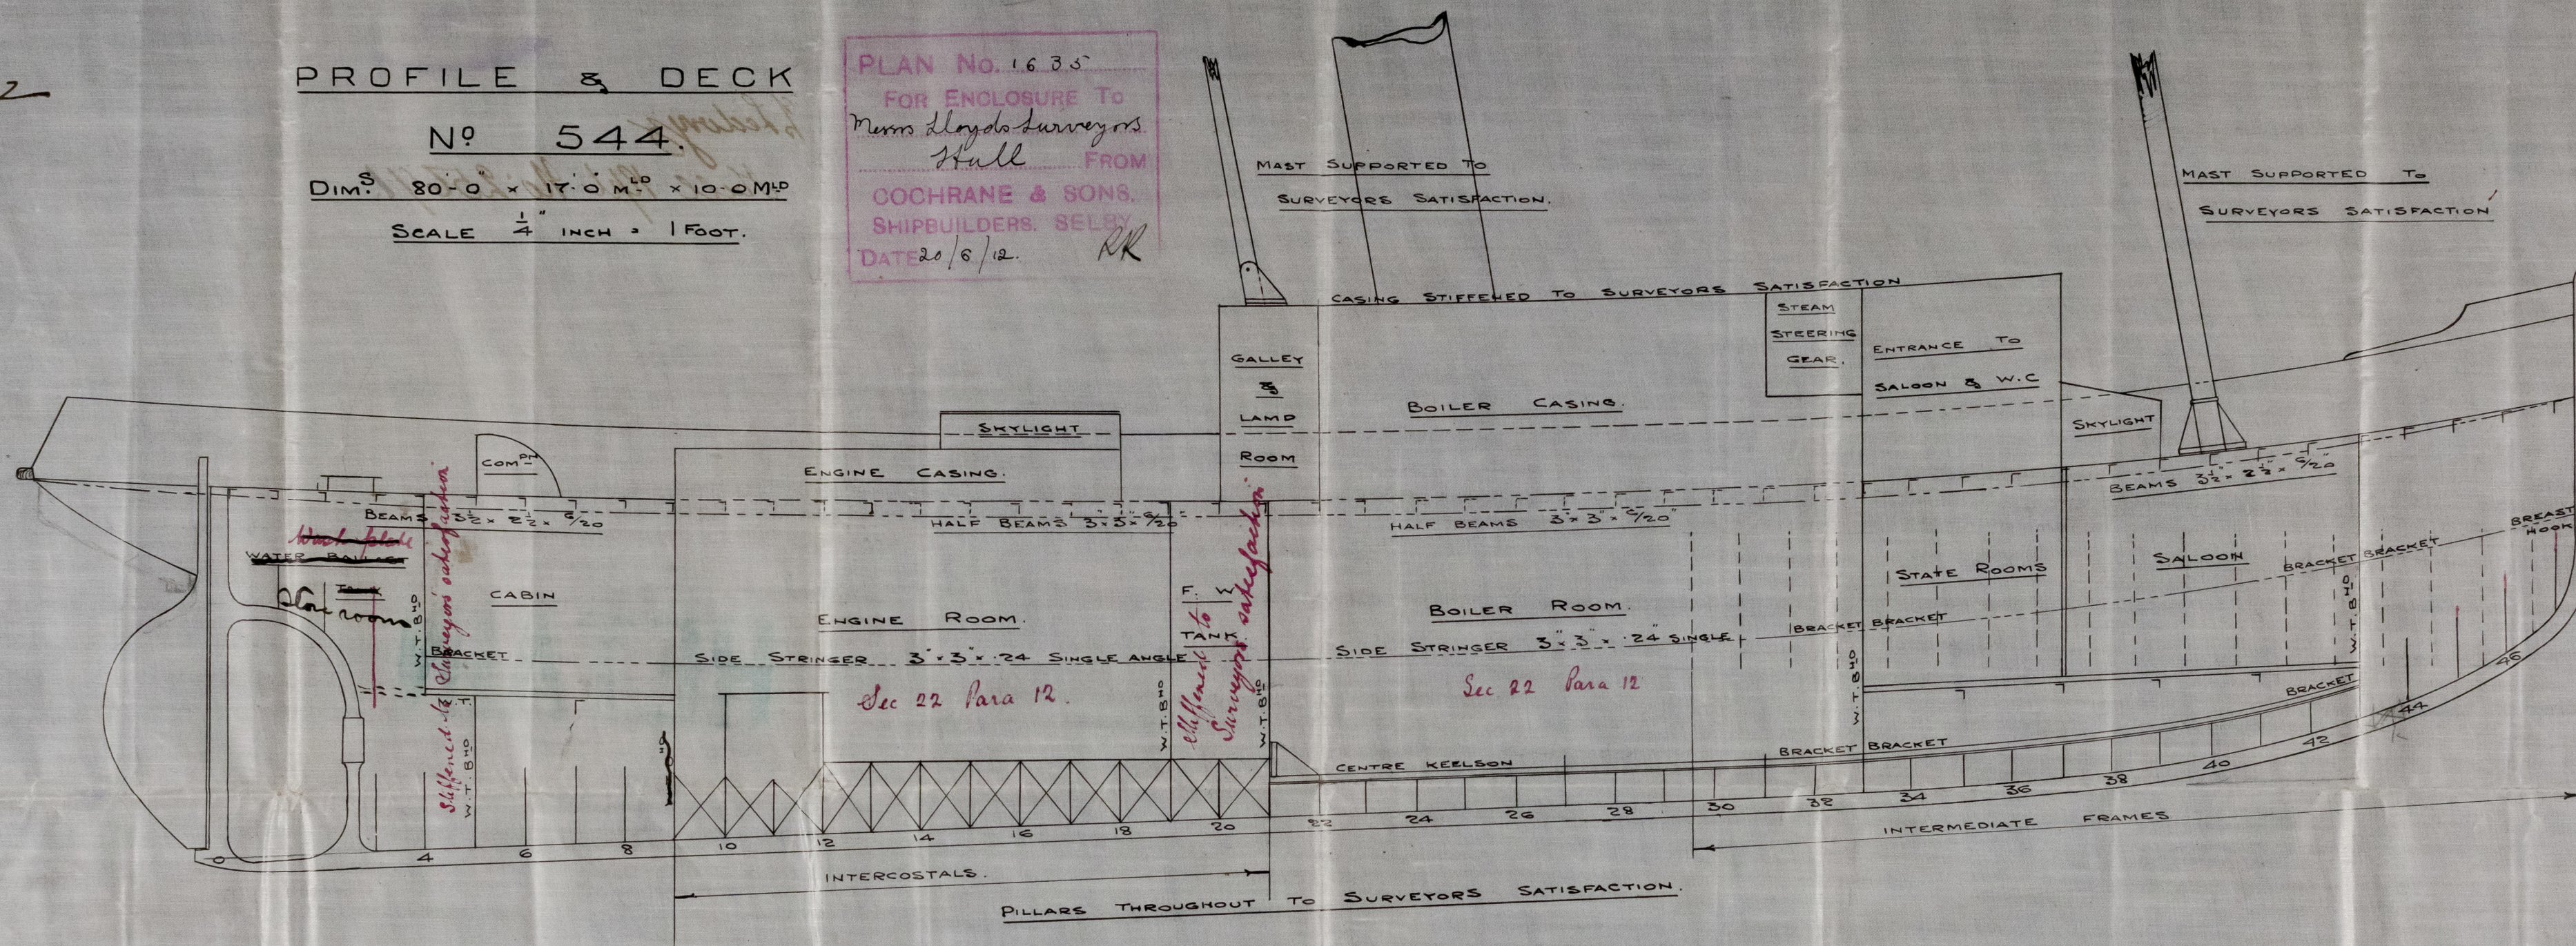

Lloyd's Register
Foundation

W1502-0035

Cochran & Sons
No. 544.

Profile & Deck Plan.

J. Ledvitz

Hull Rpt No: 25641

SCALE 1/4" INCH = 1 FOOT.

ENTRANCE TO

SALOON & W.C.

STATE ROOMS



© 2021

Lloyd's Register
Foundation