

25.6.12


arab P. unanad
11/10/12
waited girabim

Sample of
all left hull

Nº 544
MIDSHIP SECTION
STEEL SCREW TUG

TO CLASS 100 A.L. LLOYDS FOR TOWING PURPOSES.
DIMS: 80'-0" B.P. x 17'-0" MLD. x 10'-0" MLD
SCALE 1/2" = 1 FOOT.

PLAN No. 1634
FOR ENCLOSURE TO
Messrs Lloyd's Surveyors
Hull FROM
COCHRANE & SONS,
SHIPBUILDERS, SELE
DATE 20/6/12 RK

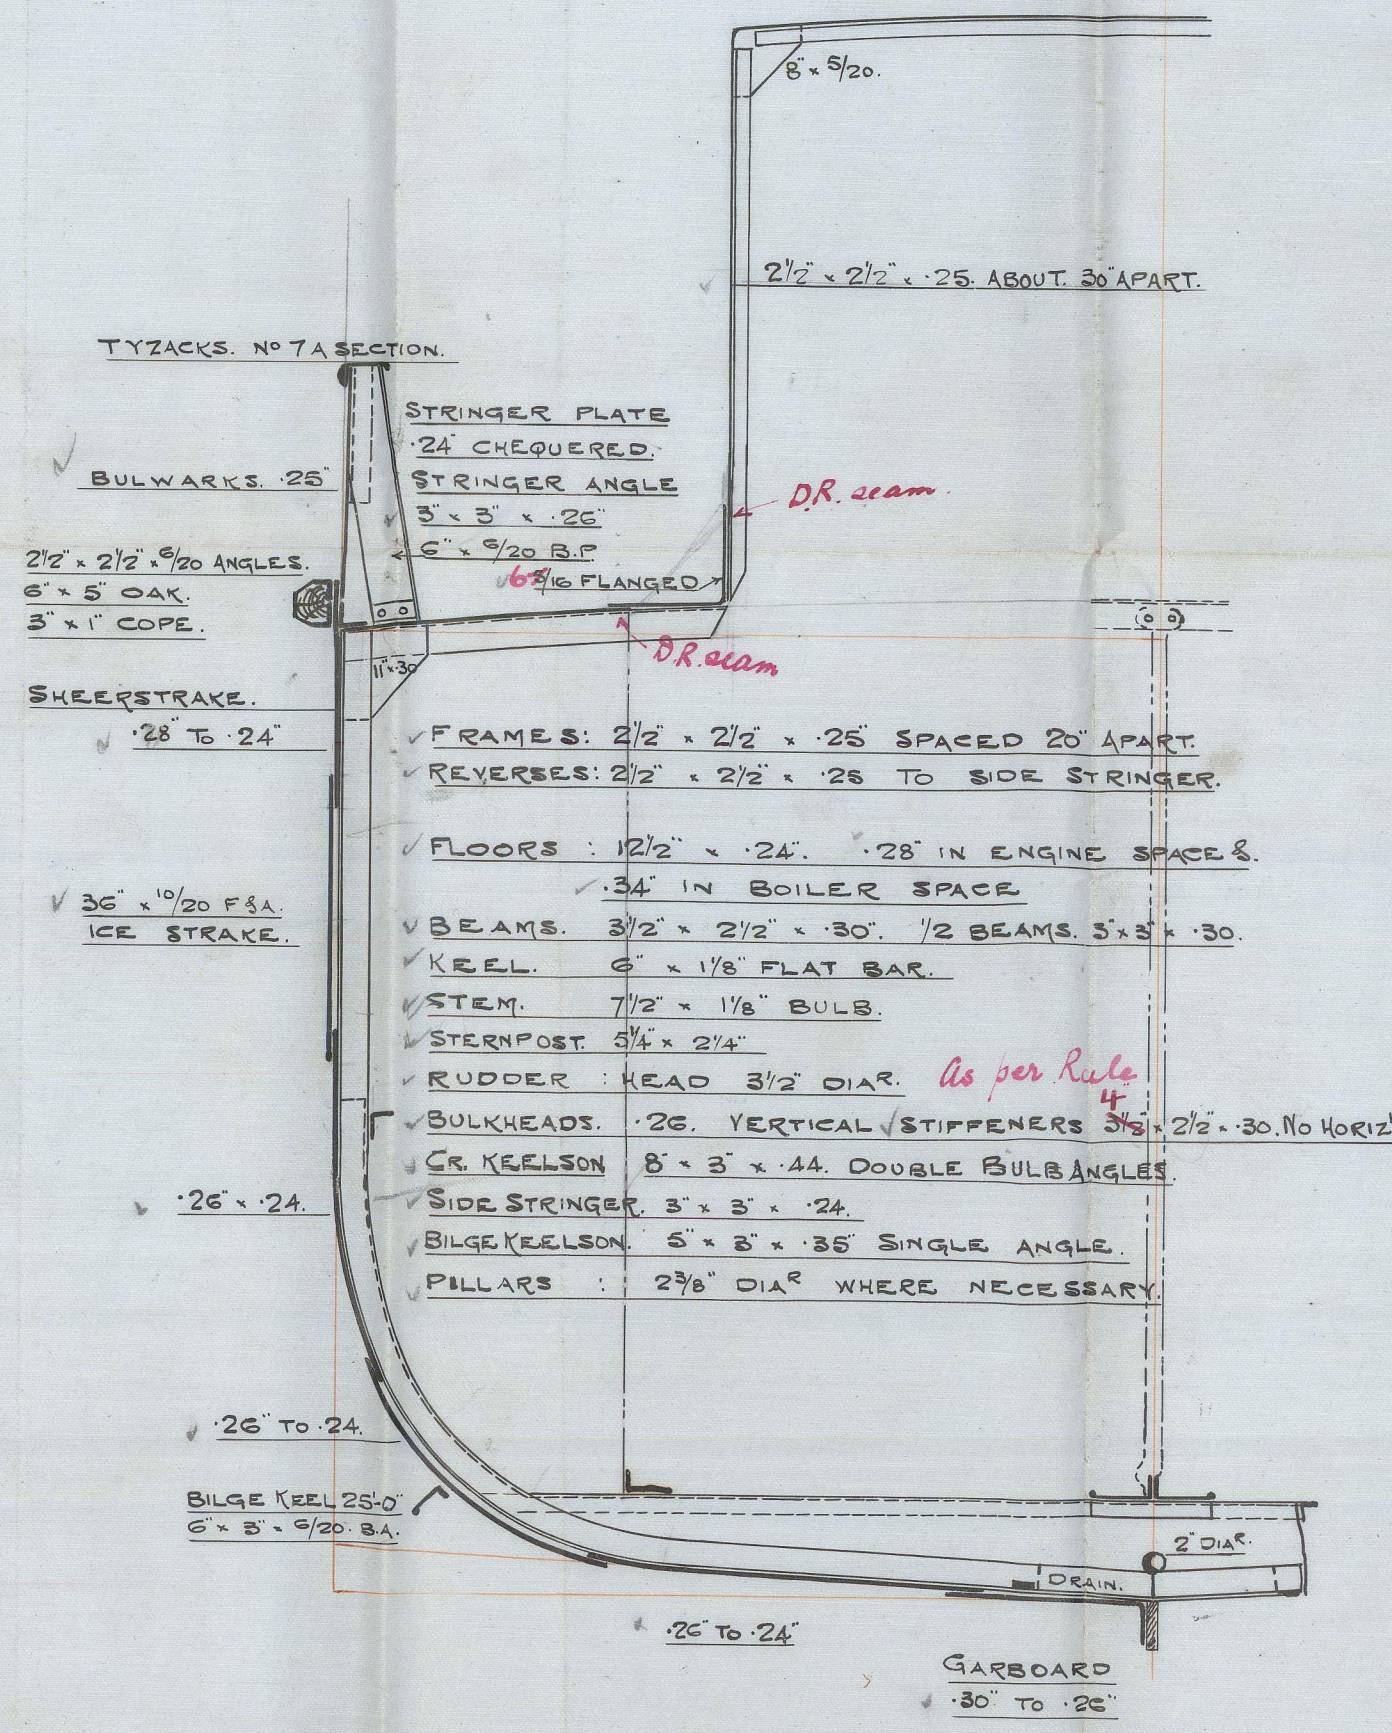

NUMERALS.

B+D.	27.
L x (B+D)	2160
d	8.95
L/D	8.00
B/L	4.70

EQUIPMENT.

2 ANCHORS.	3 3/4 CWTs STOCKLESS.
1	1 3/4 " EX STOCK
60 FATHOMS.	1 1/2" STUD CABLE.
60 "	5" HAWSER
60 "	2 1/2" WARP.
50 "	10" MANILLA.

RIVETING.

BUTTS OF SHEER STRAKE, GARBOARD AND
ICE STRAKES TO BE STRAPPED AND
DOUBLE RIVETED.
REMAINING STRAKES TO BE OVERLAPPED &
DOUBLE RIVETED.
AND STRAKE BELOW
LOWER EDGE OF SHEER STRAKE DOUBLE RIVETED
REMAINDER SINGLE RIVETED.

C.B.
25.6.12.

LLOYD'S REGISTER
OF SHIPPING
24 JUN 1912
HULL, ENGL.

Cochrane & Sons
No. 544.
Midship Section.

1/2 Ledoryz
Hull Hpt No. 1

