

11. 8. 13


Steel screw Motor barge „Lewis Castle“

97'-0" x 18'-11" x 8'-6"

Stiffening arrangement at break

Scale $\frac{1}{10}$

GEDRONDEERS BOOT,
LEIDERDORP.
SCHREPSBOUW- en
REPARATIEWERVEN
„de HOOP“ „de VAARD“

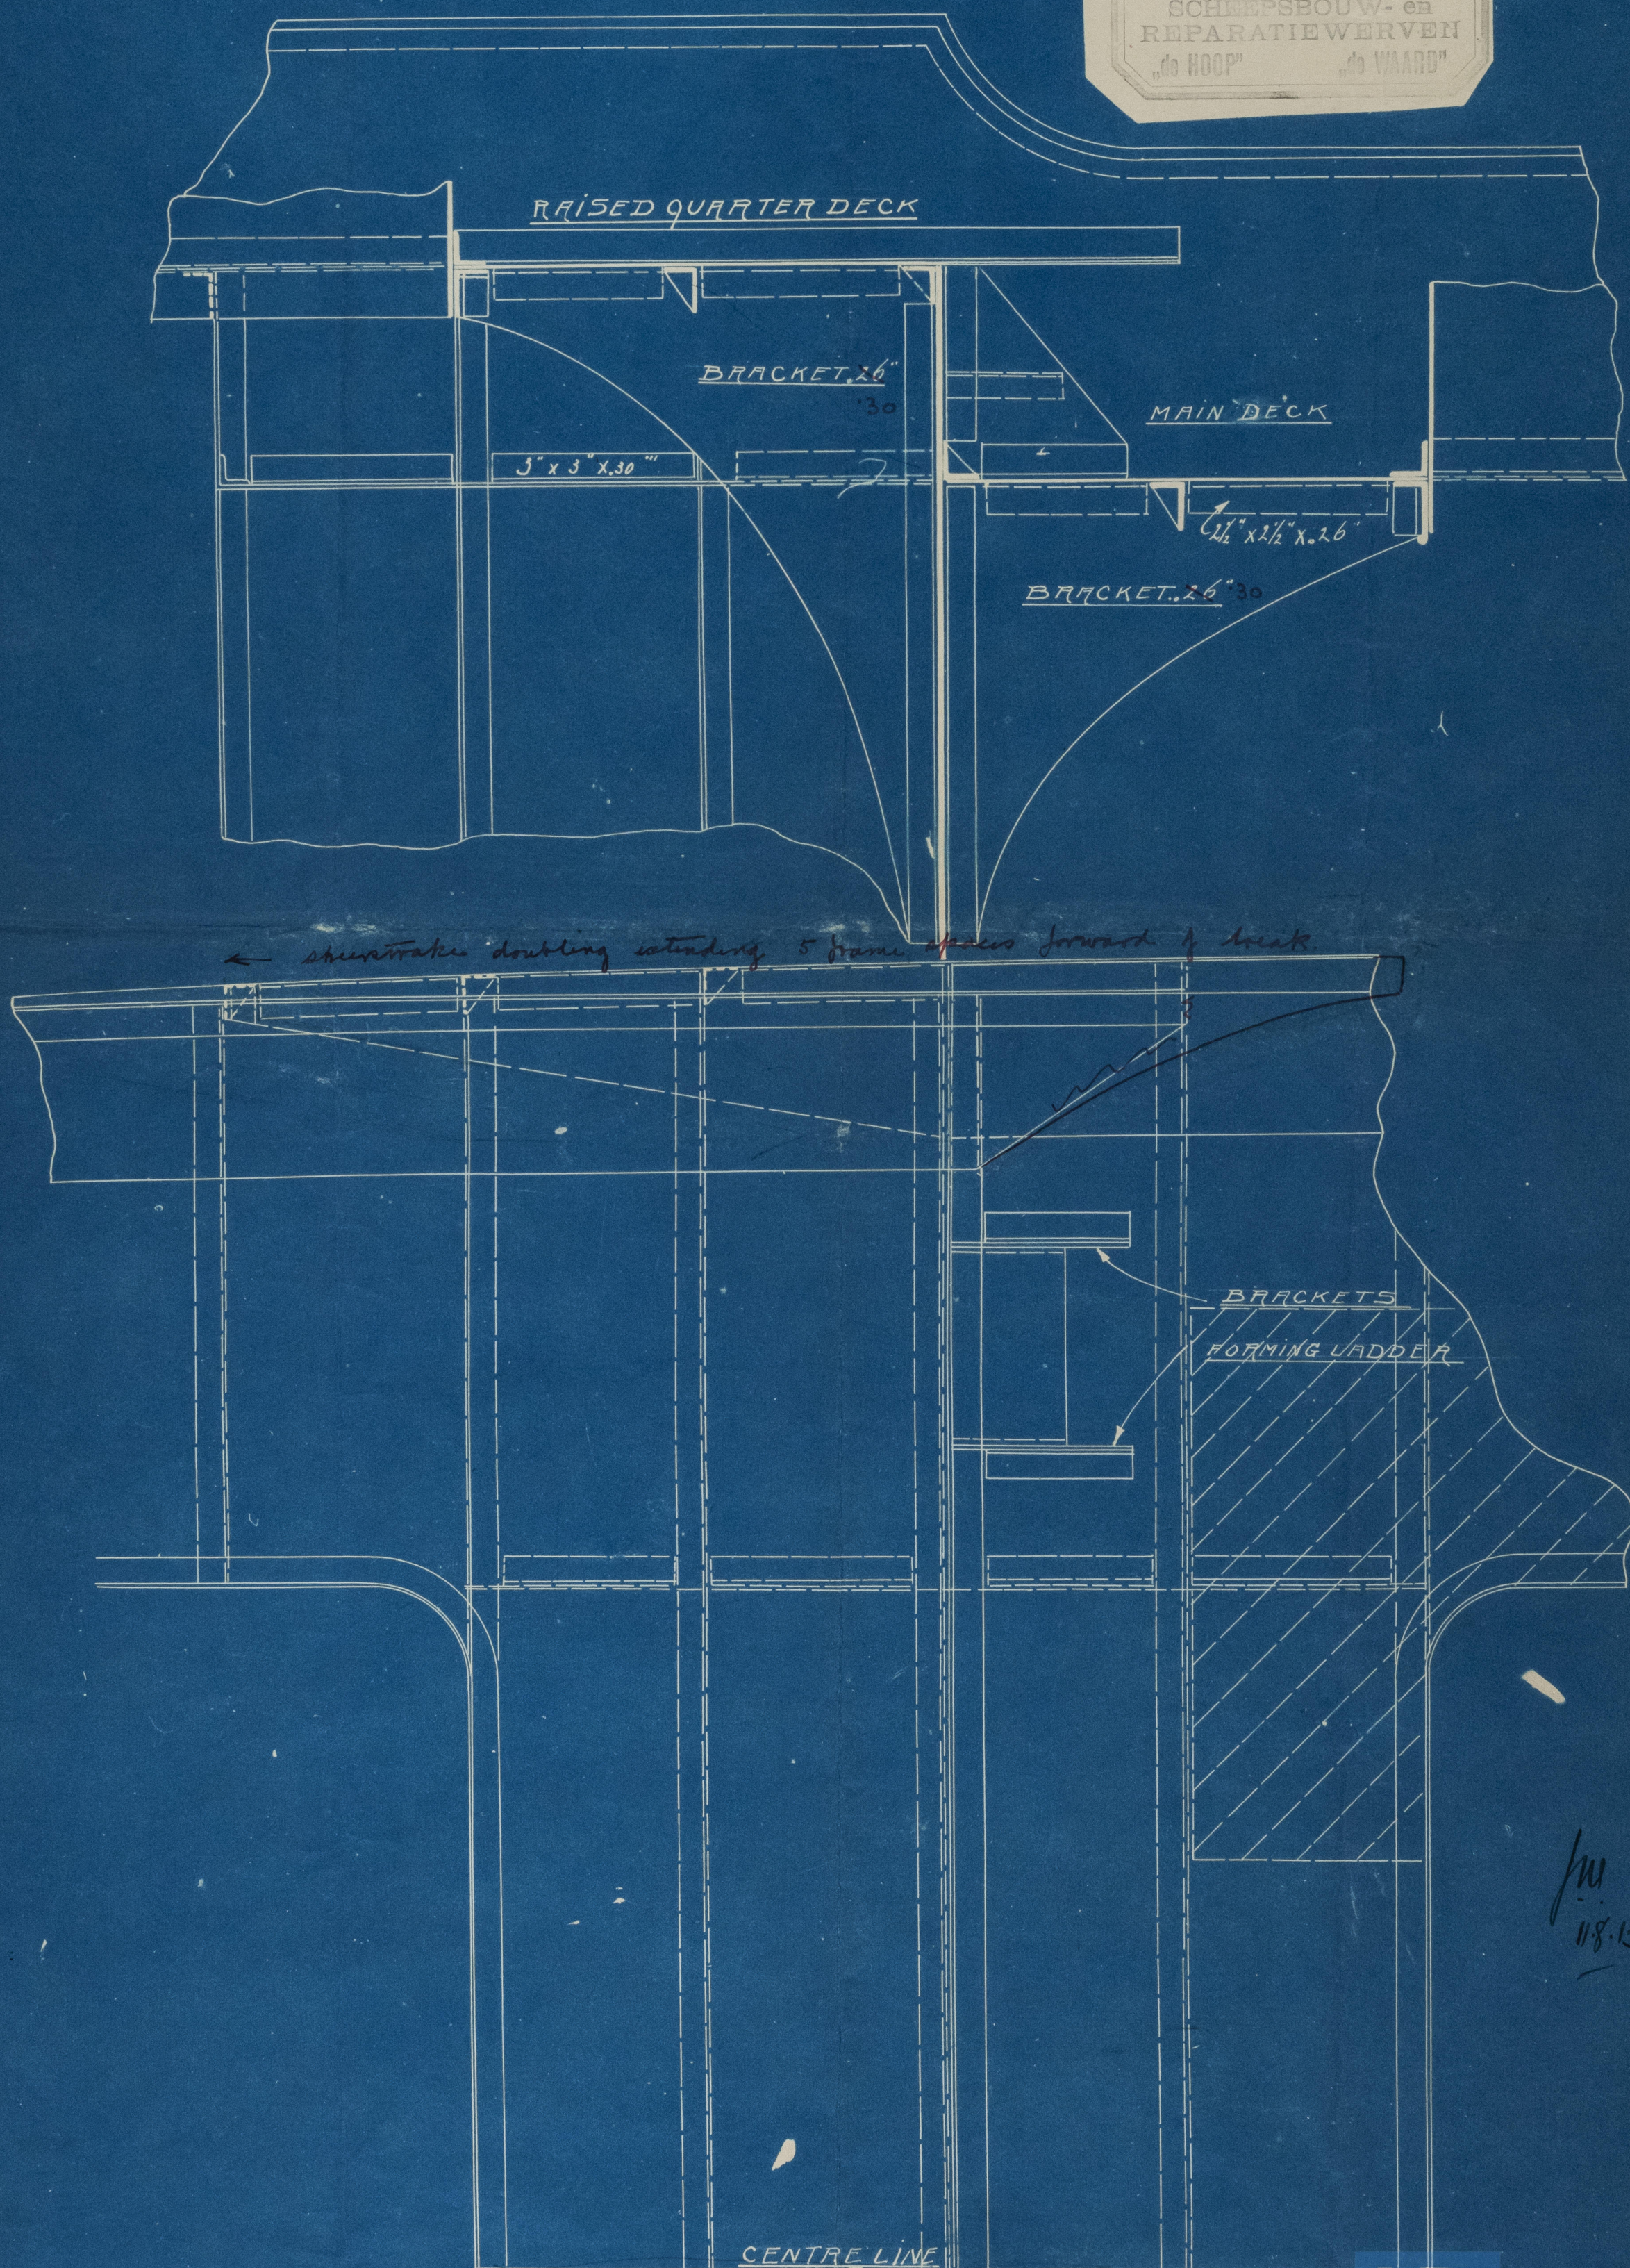

fw
11.8.13




586 Books
Break Shipping

Motor Barge.

"Lewis Castle"

Plan. of Break

Adlam report. no. 9040^a

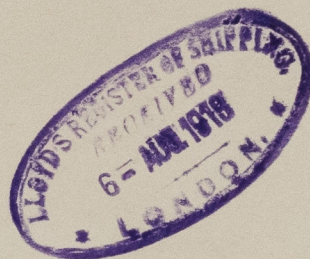

W1503-0060

© 2021

Lloyd's Register
Foundation