


11.7.13
K. 8. 11

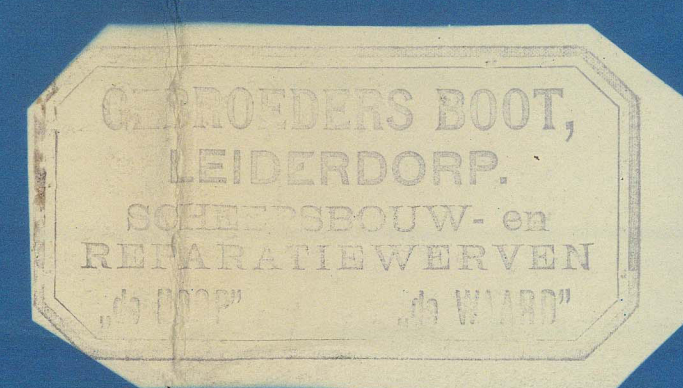

Steel screw Motor Coasting Barge

General Arrangement


Scale $\frac{3}{8}'' = 1'-0''$

TO CLASS AT LLOYDS + 100 A.

DIMENSIONS.

LENGTH BETW. P.P. $97'-0''$
BREADTH MLD $18'-11''$
DEPTH MLD $8'-6''$

TRANSV: $N^\circ = 27.42$
LONGIT: $N^\circ = 2659.$
 $d = 7'-6'' \quad \frac{L}{D} = 11.41$

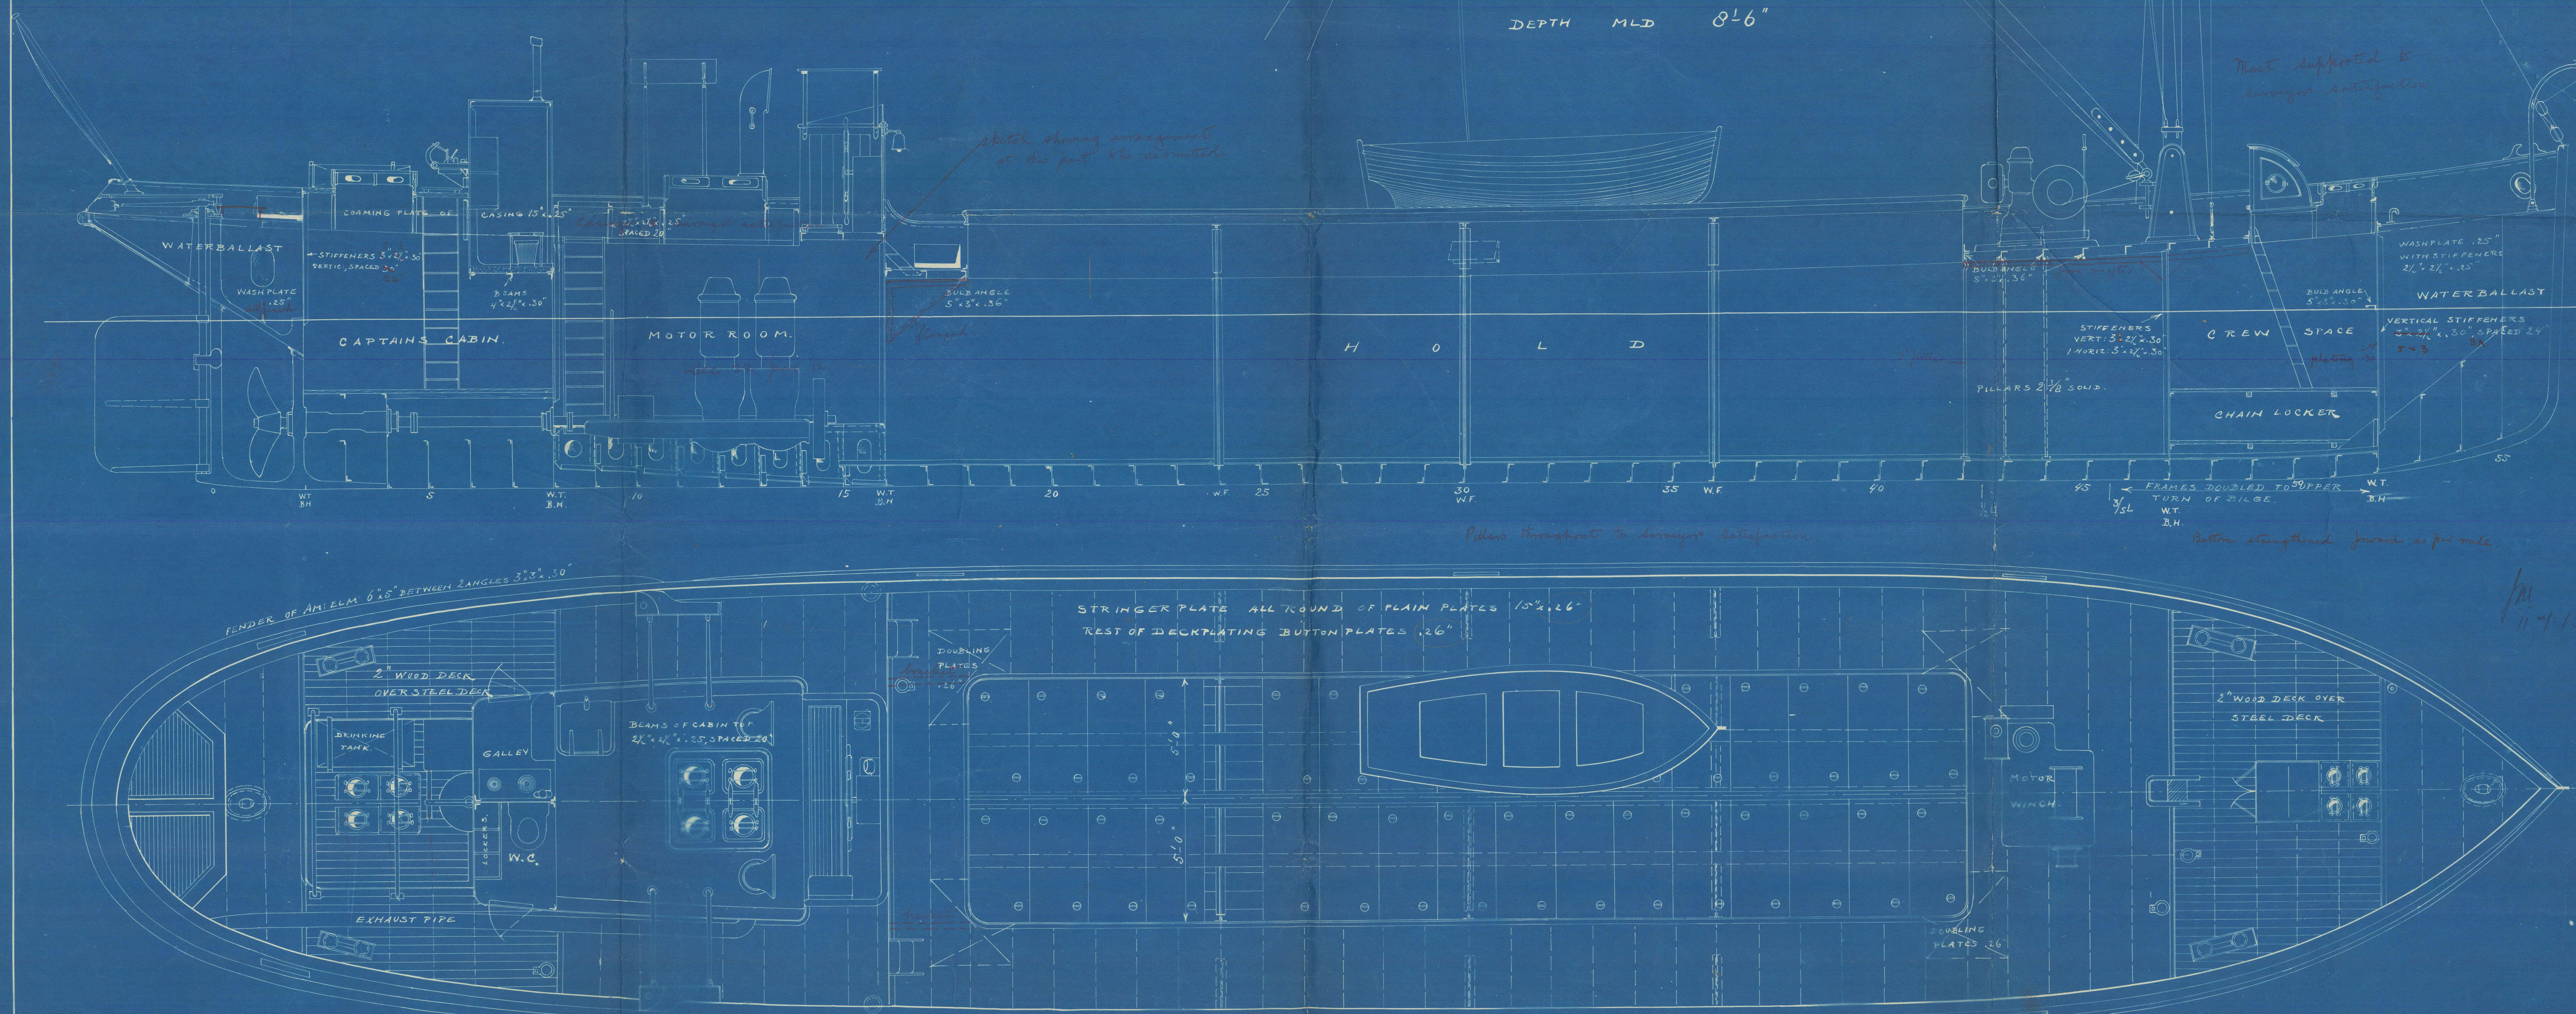

11.7.13

RETAIN




Motor Barge.

Leues Castle

Profile and Deck.

Adam report. no. 9040²

Profile 1200's barge

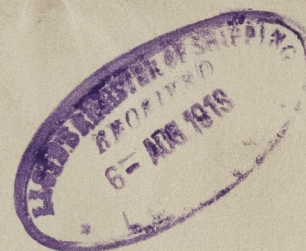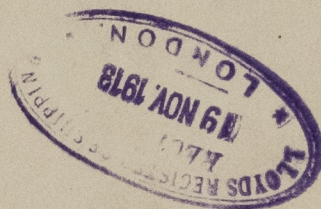
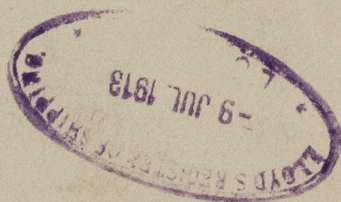


RETHANK

Motor Barge.
Leues Castle
Profile and Deck.

Adam report no. 9048

Profile 10000 barge

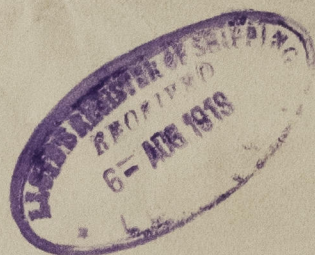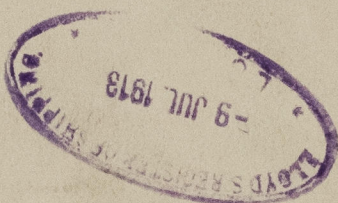

W1503-0061



© 2021

Lloyd's Register
Foundation