

$17-89$
 10.5
 12.33


 $\checkmark 40.72 = 1^{st} 12^{\circ}$
 108.4

 $4431.96 = 2^{nd} 12^{\circ}$

SCALE $\frac{1}{2}" = 1$ FOOT.

$\frac{5}{15}$. N° 333.

✓ 1	Archeor	4 3/4	cutw Ex Stock
✓ 1	"	4 1/4	" " "
✓ 1	"	2 1/2	" " "
✓ 90		13/16	stud Link Cable
✓ 60		5 1/2	Hawser.
✓ 60		4	Warp.

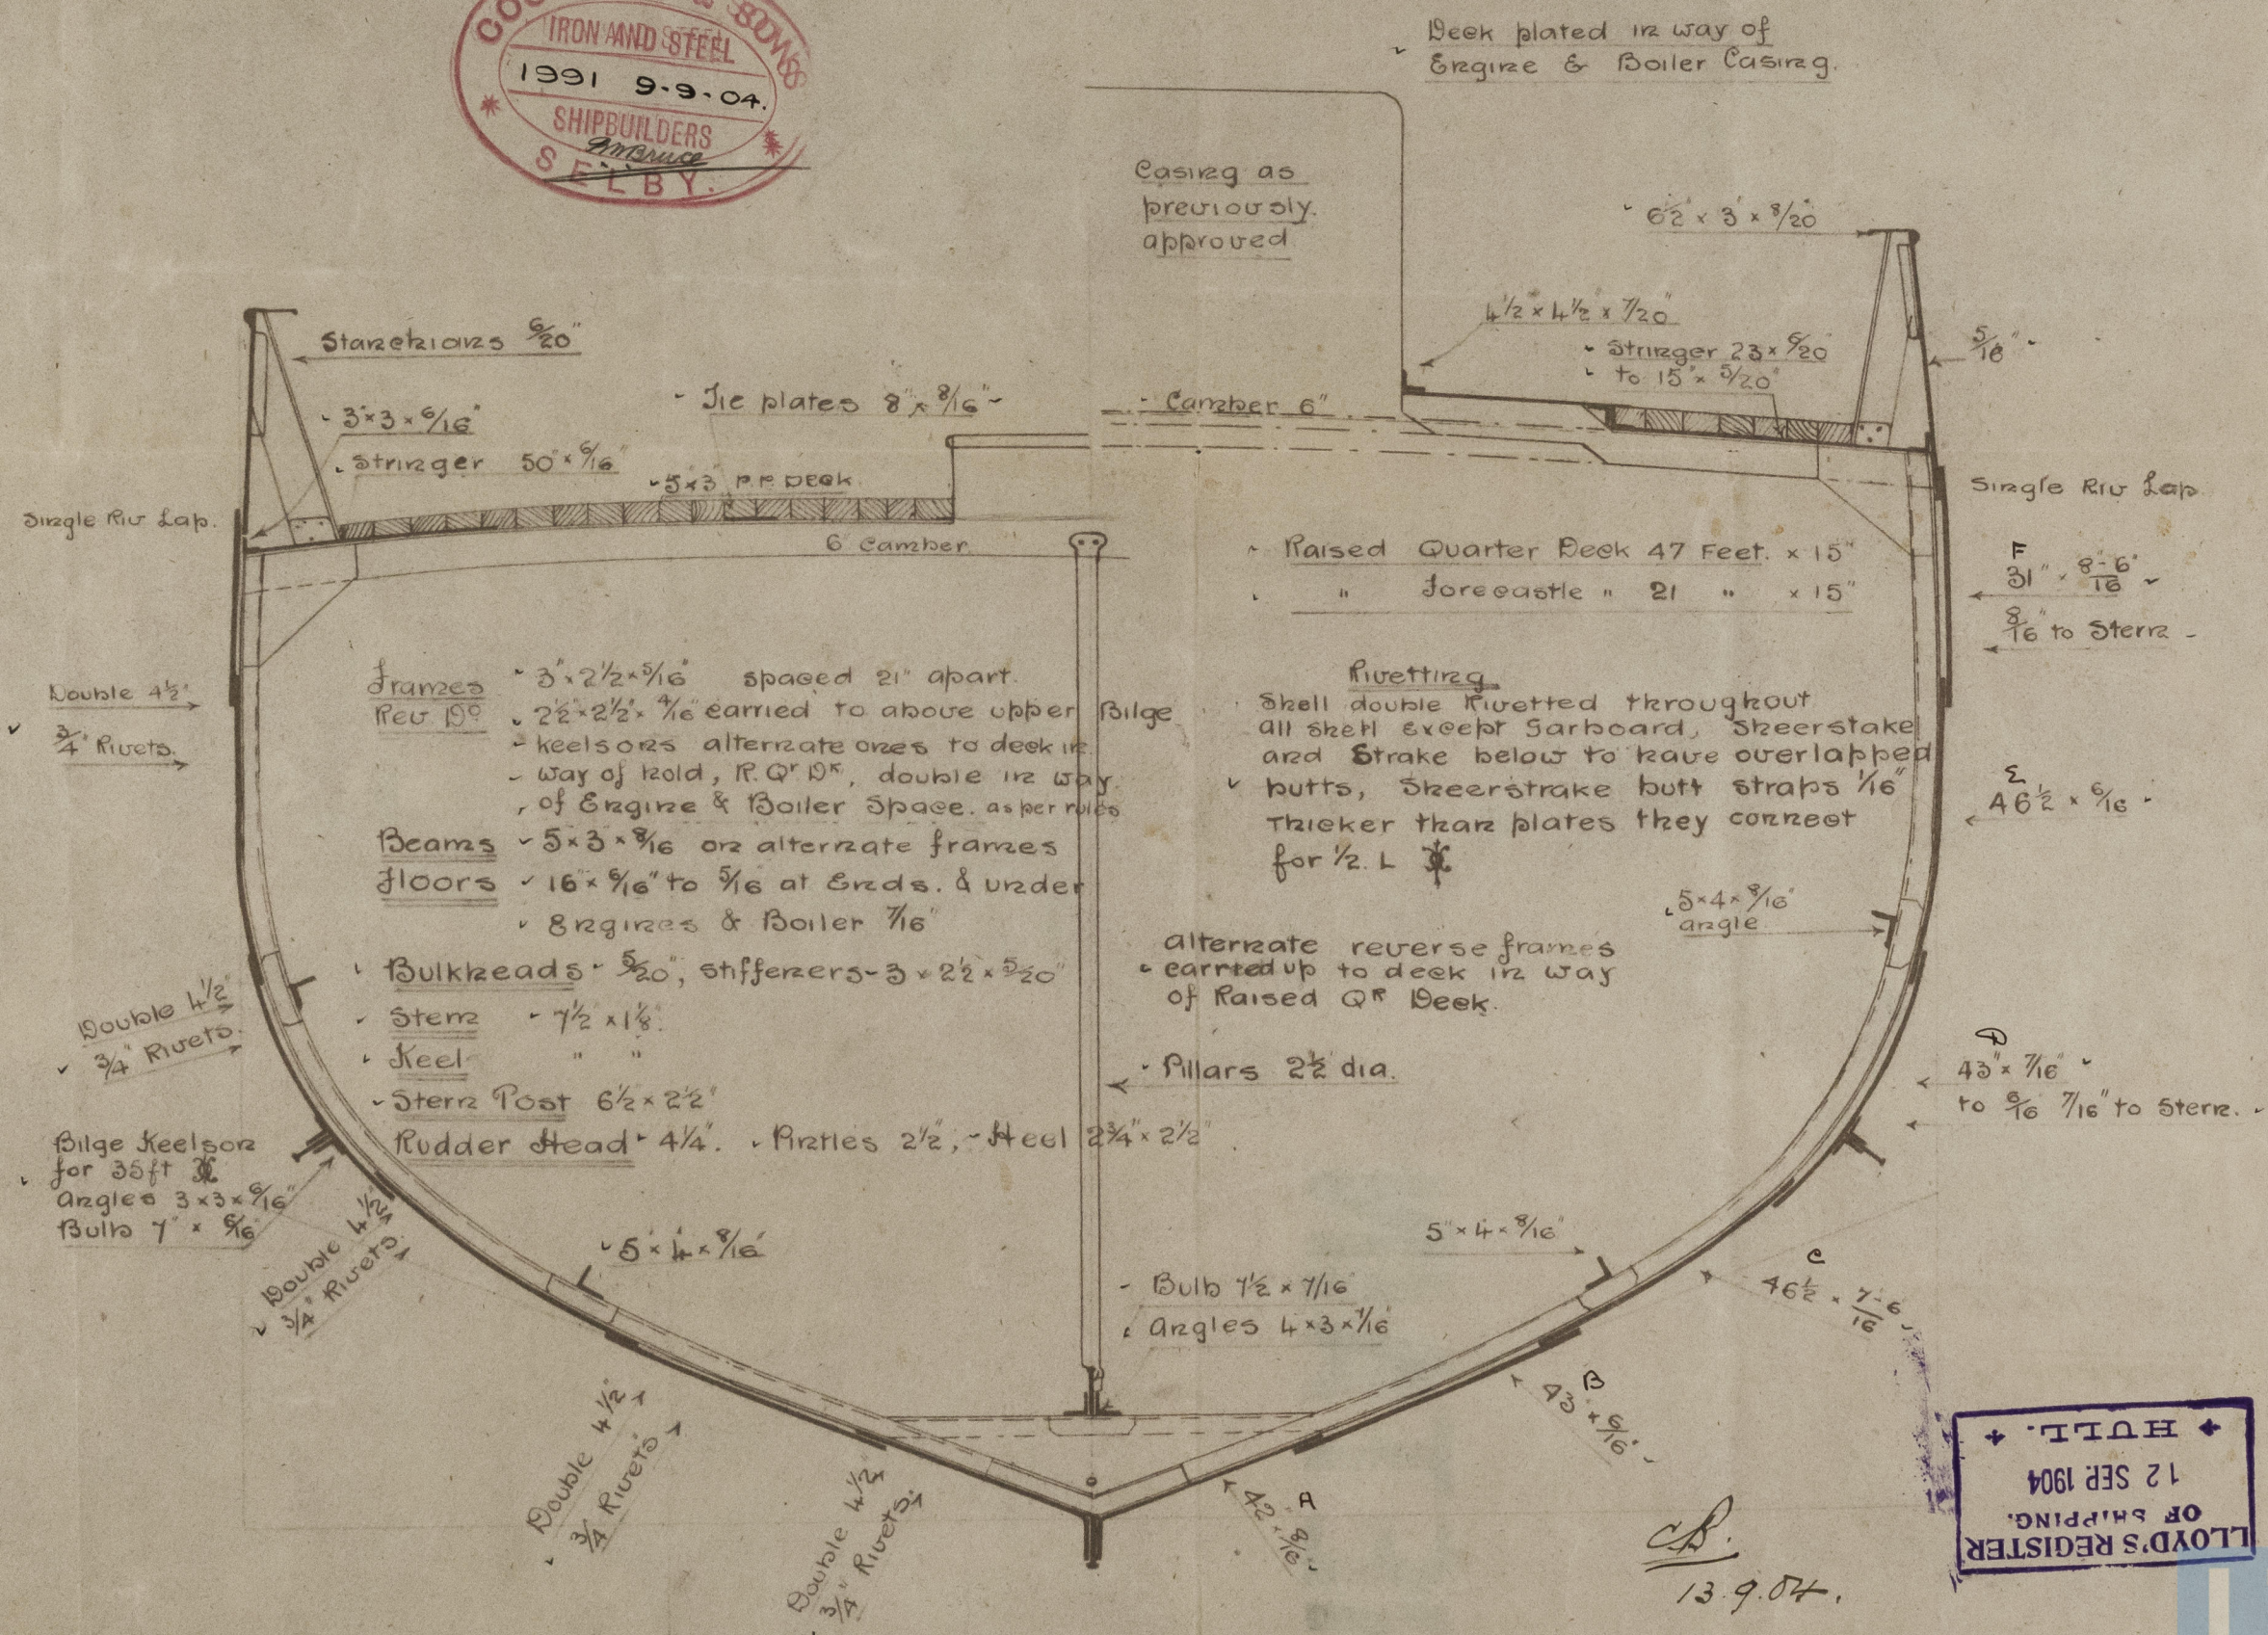

LOYD'S REGISTER
OF SHIPPING.
12 SEP 1904
HULL.
+

AWT
12-9-04


© 2021
Lloyd's Register
Foundation

W1503-017

RETAIN

Midship Section
Messrs Cochran & Sons

N^o 333.

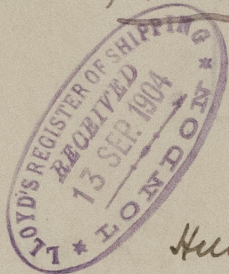

"Leo"
s/s "Despatch"

Hull Rpt. N^o 16472



© 2021

Lloyd's Register
Foundation