

EQUIPMENT.

2	BOWER ANCHORS	STOCKLESS WEIGHT	38 3/4 CWT = 4340 LBS
1	BOWER ANCHORS	"	32 1/2 CWT = 3640 LBS
1	STREAM ANCHOR		12 1/2 CWT = 1400 LBS
1	KEDGE ANCHOR		6 1/4 CWT = 700 LBS
240	FATHOMS	1 1/8" STUD CHAIN CABLE	
75	"	1 1/8	OR 4 1/2" STEEL WIRE ROPE
1	TOW LINE	90 FATHOMS 12" HEMP OR	4" " " "
2	HAWKERS	90 FATHOMS EACH 7" HEMP OR	2 1/2" STEEL WIRE ROPE
2	"	"	6" " 2 1/2"

PRINCIPAL DIMENSIONS.

LENGTH OVERALL	261 ^{FT} 0"	LENGTH AS PER RULE	L = 253.0 ^{FT}
" BETWEEN PERPENDICULARS	253 ^{FT} 0"	BREADTH	B = 43.5 ^{FT}
BREADTH MOULDED	43 ^{FT} 6"	DEPTH	D = 27.5 ^{FT}
DEPTH " TO UPPER D.K.	27 ^{FT} 6"		
" " FOOP D.K.	35 ^{FT} 0"		

TRANSVERSE NUMBER : B+D = 71.
LONGITUDINAL " : L[B+D] = 17963
EQUIPMENT : 17963 + 952 = 18915
L : $\frac{253}{275} = 92$ B : $\frac{253}{435} = 582$

BUILT TO CLASS + 100-A-1-LLOYDS

RIVETING SCHEDULE.

SHELL:
A STRAKE-QUADRUPLE RIV. BUTT STRAPS $\frac{1}{2}$ L AMIDS. TREBLE RIV STRAPS AT EN
B " TREBLE RIV BUTT LAPS $\frac{3}{8}$ RIV. WHERE PLATING 195" AND OVER. $\frac{3}{4}$ RIV AT E

ALL EDGE LAPS DOUBLE RIVETED
SIDE PLATING OF POOP & FORECASTLE DOUBLE RIVETED BUTTLAPS $\frac{3}{4}$ RIVETS
FORECASTLE SGL RIV. EDGE LAPS.
POOP SGL RIV. EDGE LAPS EXCEPT 20'-0" AT POOP BHD
WHERE THEY MUST BE DBL RIVETED

SPACING OF RIVETS IN SHELL.

RIV. SPACED 4" IN QUADRUPLE RIVETED BUTTS.

3/4" RIVETS SPACED 4 1/2"

FRAMES TO SKILL 1/8" RIVETS SPACED 5 1/4" EXCEPT IN
CENT. BOTTOM FRWD. OF 26' L. AMIDS WHERE
THEY ARE 1/4" OR 5 RIV. IN PEAKS 3/4" RIVETS SPACED 3 3/4"
FRAMES TO FLOORS - REV. FRAMES TO FLOORS - SIDE STRINGERS
TO FLOORS 3/4" RIVETS SPACED 5 1/4".
FLOORS TO CENTER VERT. KEEL 3/4" RIV. SPACED 3 3/4"

DECKS, UPPER DECK STRINGER TREBLE RIVETED BUTT LAPS
 2 L AMIDS. DBL RIVETED AT ENDS. $\frac{3}{4}$ " RIV 2 $\frac{1}{2}$ " APART.
 UPPER DK PLATING DBL RIVETED BUTT LAPS $\frac{1}{2}$ L AMIDS
 SINGLE RIVETED AT ENDS. $\frac{3}{4}$ " RIVETS, 3" APART.
 ALL EDGE LAPS SINGLE RIVETED. $\frac{3}{4}$ " RIVETS SPACED 3 $\frac{1}{2}$ "
POOP & FORECASTLE DECK STRINGER PLATES DBL
RIVETED BUTT LAPS. $\frac{3}{4}$ " RIVETS SPACED 2 $\frac{1}{2}$ "
 BALANCE OF PLATING OF POOP DK DOUBLE RIVETED
 BUTT LAPS. SGL RIVETED AT AFT END $\frac{3}{4}$ " RIVETS 3" APART.
 BALANCE OF FORECASTLE PLATING SINGLE RIVETED
 BUTT LAPS. $\frac{3}{4}$ " RIVETS SPACED 3"
 ALL EDGE LAPS SINGLE RIVETED $\frac{3}{4}$ " RIVETS SPACED 3 $\frac{1}{2}$ "
 DECK PLATING TO BEAMS $\frac{3}{4}$ " RIVETS, SPACED 5 $\frac{1}{2}$ ".
 GUNWALE BAR ON UPPER DK $\frac{1}{2}$ " RIV SPACED 4" IN EACH ROW.

WING TANK PLATING SINGLE RIV'D EDGE LAPS, DOUBLE
RIV'D BUTT LAPS. $\frac{3}{4}$ " RIVETS SPACED 3"

WT BULKHEADS WHERE BHD. FLATES ARE RIVETED
TO FLOORS LAP TO BE DOUBLE RIVETED. BUTTS 5QL
RIV'D. EDGE LAPS 5QL RIV'D. $\frac{3}{4}$ RIV. SPACED 3 $\frac{3}{4}$ IN BHD
FRAME SPACED 3 $\frac{3}{4}$ IN BHD STIFF SPACED 5 $\frac{1}{2}$

INNER BOTTOM. CENT. VERT. KEEL TREBLE RIV. BUTT LAP.
RIDER PLATE TREBLE RIVETED BUTT LAPs $\frac{1}{2}$ L AMIDS
DBL RIVETED AT ENDS. EDGE LAPs DBL THROUGHOUT.
MARGIN PLATE DBL RIVETED BUTT LAPs THROUGHOUT.
SINGLE RIVETED FLANGE TO SHELL.
BALANCE OF PLATING DOUBLE RIVETED BUTT LAP $\frac{1}{2}$ L
AMIDS THROUGHOUT. SINGLE RIVETED. EDGE LAPs
SINGLE RIVETED. $\frac{3}{4}$ RIVETS SPACED 3".
ANGLES CONNECTING FLOORS TO CENT KEEL AND FLAT
KEEL ANGLES $\frac{3}{4}$ " RIVETS SPACED 3".
TOP ANGLES AT CENT VERT KEEL $\frac{3}{4}$ " RIVETS SPACED 04".
EXCEPT IN MACHINERY SPACE, WHERE THEY ARE 3" APART.

EXCEPT

Copy
approved
J. French
per [signature]

A circular blue ink stamp from the Lloyds Register of Shipping. The text "LLOYDS REGISTER OF SHIPPING" is curved along the top inner edge. In the center, the date "JUN 18 1916" is stamped. Below the date, the words "NEW YORK" are stamped. There are small decorative star-like symbols on the left and right sides of the stamp.

HULLS No. ~~10-11-12~~ 165
MIDSHIP SECTION

Great Lakes Engineering Works

Lloyd's Register
Foundation

W1505-006

RETURN


GREAT LAKES ENG WKS

No 165

MIDSHIP SECTION

S/S "Bequa"

Chr. Rkt. No. 75

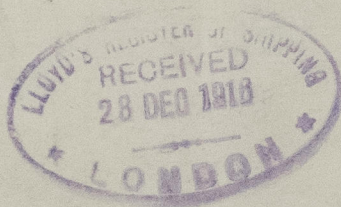

© 2021

Lloyd's Register
Foundation

W1505-0062



PLATES COME
TO HAVE SAME
FOR SAME ST

Mr. True

W1505-0062

Hull 165-
1/15
1/15

22.5
16

43" x 23"

DOUBLED F
AT POOP E



© 2021
Lloyd's Register
Foundation