

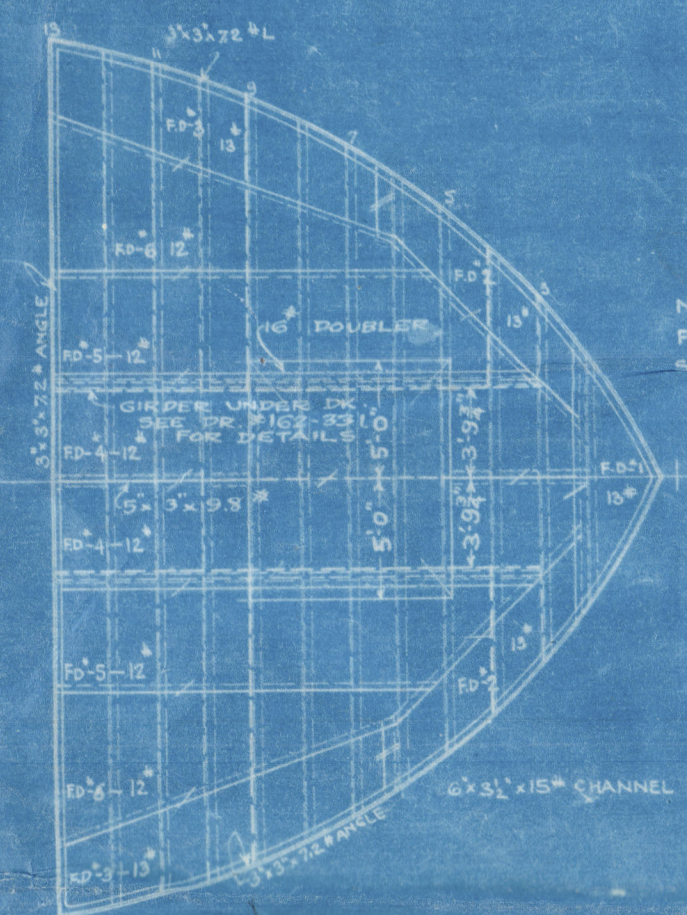


DATE	ITEM
APRIL 25-16	ANGLE AT UPPER DECK HATCHES UNDER POOP CHANGED TO 4" x 4" x 1/2"
" "	DOUBLING PLATES AT UPPER DECK HATCH NO. 5 ADDED
MAY 6-16	MAIN MAST SHIFTED 4" FORWARD
MAY 18-16	NEW SKETCH OF 21" x 21" SCUTTLE AT ENDS & 15" x 30" SCUTTLE AMIDSHIP
" "	SCUTTLE IN STEERING ENG. ROOM CHANGED TO W.T. MANHOLE
" "	GIRDERS & LIGHT CABINETS UNDER POOP DECK ADDED

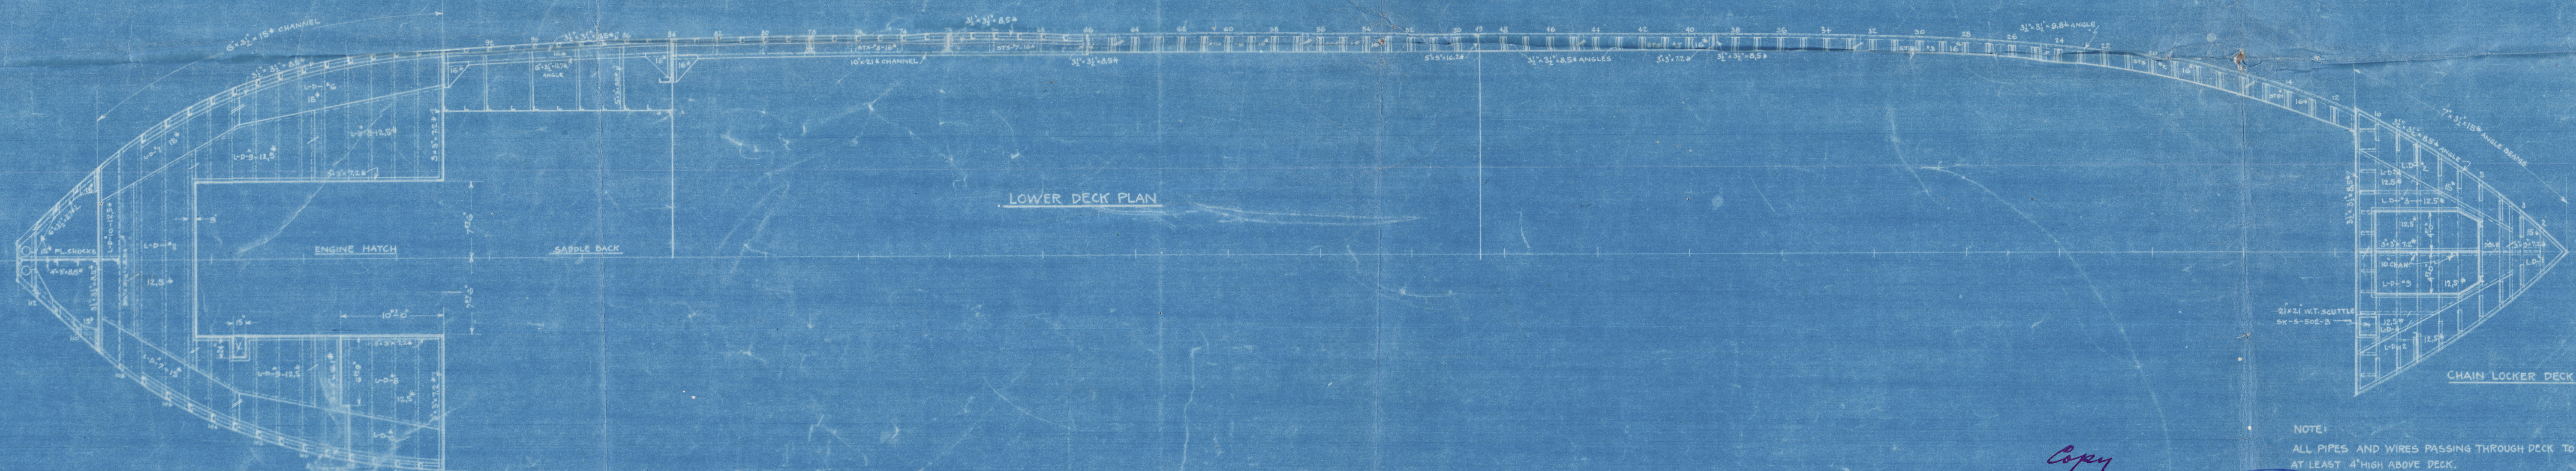

NOTE: FORECASTLE DECK TO BE FLATTENED IN W.T. OF WINDLASS SEE OUTLINE FOUNDATION PLAN DR. # 162-353

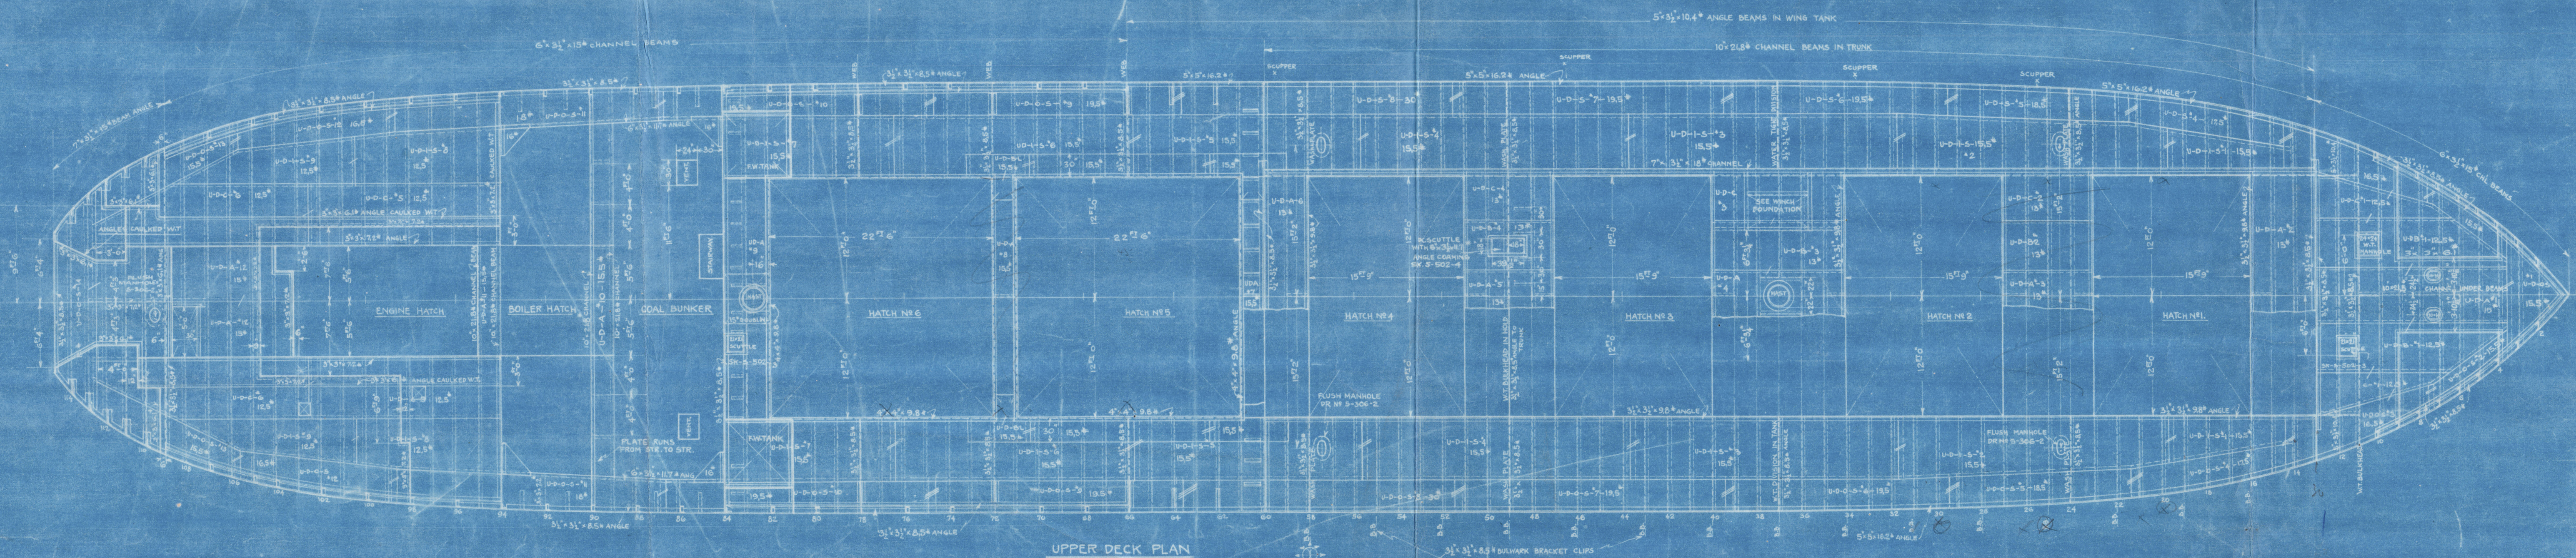

NOTE: ALL PIPES AND WIRES PASSING THROUGH DECK TO HAVE NIPPLES AT LEAST 4" HIGH ABOVE DECK.

Copy Approved  
J. French  
per J. G.

RECORDS REGISTER OF SHIPBUILDING  
MAY 18 1916  
NEW YORK

HULL NO. 165  
DECK PLANS

Great Lakes Engineering Works


DETROIT, MICH.  
HULL DEPT. 10 2021  
THOMAS E. D. 1916  
MAY 18 1916



REF  
GREAT LAKES END WKS  
No 165  
DECK PLANS

S/S "Bequa"

cler. Rpt. no. 75.

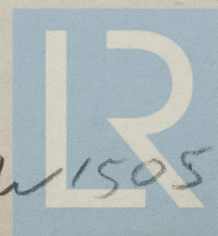

© 2021

Lloyd's Register  
Foundation

W1505-0063





W1508-0063



© 2021

Lloyd's Register  
Foundation