


	TUBES	1732
	FURNACES	126
HEATING SURFACE	COMB CHIM	222
	TOTAL	2080
DRAFT AREA THRU TUBES		98
GRATE SURFACE 5" x 5" BARS		52
RATIO HEAT SURF	2080	40
GRATE	52	
RATIO GRATE SURF.	52	53
DRAFT AREA	98	

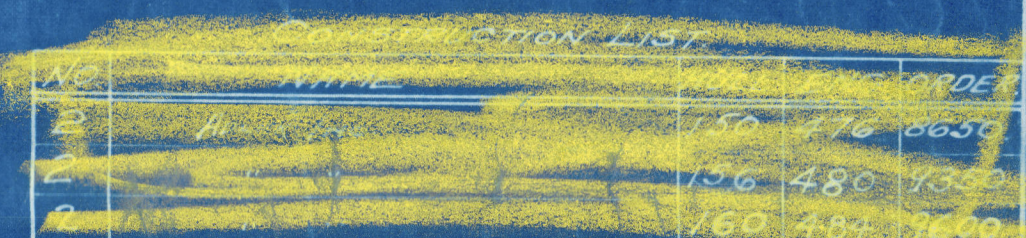




TO PASS U.S. GOV'T AND BRITISH LLOYD'S REQUIREMENTS FOR A WORKING PRESSURE OF 175 PER. <sup>0</sup> TENSILE STRENGTH OF PLATE AT LEAST 68,120. <sup>F</sup> ALL STAYS TO BE TESTED STEEL ALL RIVETS TO BE OF GOOD CHARCOAL STEEL AND TO MEET WITH REQUIREMENTS OF TESTS FOR U.S. GOV'T. & BRITISH LLOYD'S.

**BOILER**  
13<sup>ft</sup> 6" INSIDE DIA. 11<sup>ft</sup> 0" OVERALL.  
175# WORKING PRESSURE.

Great Lakes Engineering Works.

Drawn by HMV .....  
Traced by HMV-DM.H. .....  
Scale 1" = 3" .....  
Date JUNE 18 1957 .....

55



Great Lakes Eng Mks  
Main Balers

N<sup>o</sup> 165

175 lbs. W.D.

Duplicate N<sup>o</sup> 156.

2 off. 5/8 "Begna"  
blv. R.H. Jr. 75

Credit Salant

1/3 for 7  
\$12.00 expenses



© 2021

W 1505-0054

Lloyd's Register  
Foundation