


# MIDSHIP SECTION

Nos 1036-7

TURBINE STEAMER 380'x45'x18'-6" (TO MAIN DECK)

SCALE 1/2" = 1 FOOT.

CLASS:- LLOYDS A IRISH CHANNEL SERVICE.  
DRAUGHT: 13'-2 1/2" MOULDED.

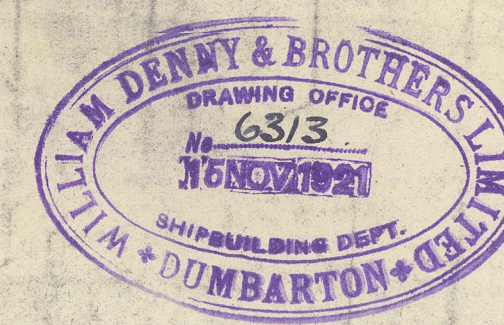

T.S.S. 'CAMBRIA' & 'SCOTIA'


**RIVETING**  
SHELL BUTTS OF CARBOARD STRAKE SINGLE STRAPPED & 3R. FORE & AFT.  
BUTTS OF SHEERSTRAKE OVERLAPPED 1/4" FOR 1/2" L. TO 3/4" & 2R AT ENDS.  
REMAINDER OVERLAPPED & 3R FOR 1/2" L. 3/4" 2R AT ENDS.  
DECK ANNING OR BUTTS OF STRINGER 3R FOR 1/2" L. 2R AT ENDS.  
BUTTS OF DECK PLATING 2R FOR 1/2" L. IR AT ENDS. TIES 2R.  
MAIN & LOWER DECK BUTTS OF STRINGER PLATE 2R BUTTS.  
OF PLATING 2R FOR 1/2" L. IR AT ENDS. TIES 2R.  
EDGES OF ALL DECK PLATING SINGLE RIVETED.  
ON KEELSON BUTTS 3R FOR 1/2" L. 2R AT ENDS.

**EQUIPMENT**  
2 BOWER ANCHORS EACH 38 1/2 CMTS STOCKLESS  
1 STEER ANCHOR 17 1/2 CMTS EX STOCK  
2 AT 120 FMS 1 1/2" STUD CHAIN CABLE  
2 AT 75 FMS 4 1/2" SWR IN SUE-OF-SPEER-CHAIN  
1 AT 90 FMS 4" FLEXIBLE S.W.R.  
70 FMS 3/4" " " IN TWO LENGTHS  
100 FMS 3" " " IN FOUR LENGTHS  
100 FMS 6" MANILA HAWSER  
6 AT 120 FMS 5" MANILA ROPE  
4 AT 15 FMS HEAVING LINES

STRINGER PLATE 48"x52" to 30"x30"  
STRINGER ANGLE 4 1/2"x5 1/2" to 3"x3"x30"  
GUTTER ANGLE 3"x2 1/2"x30"

STEEL DECK 3/4" TO 26" FROM AFTER  
CARO HATCH TO FORE END  
TIE PLATES AFT 15'x32"

5"x2 1/2" COLUMBIAN PINE OUTSIDE HOUSES  
5"x2 1/2" INSIDE  
TEAK ON PASSENGER GANGWAYS

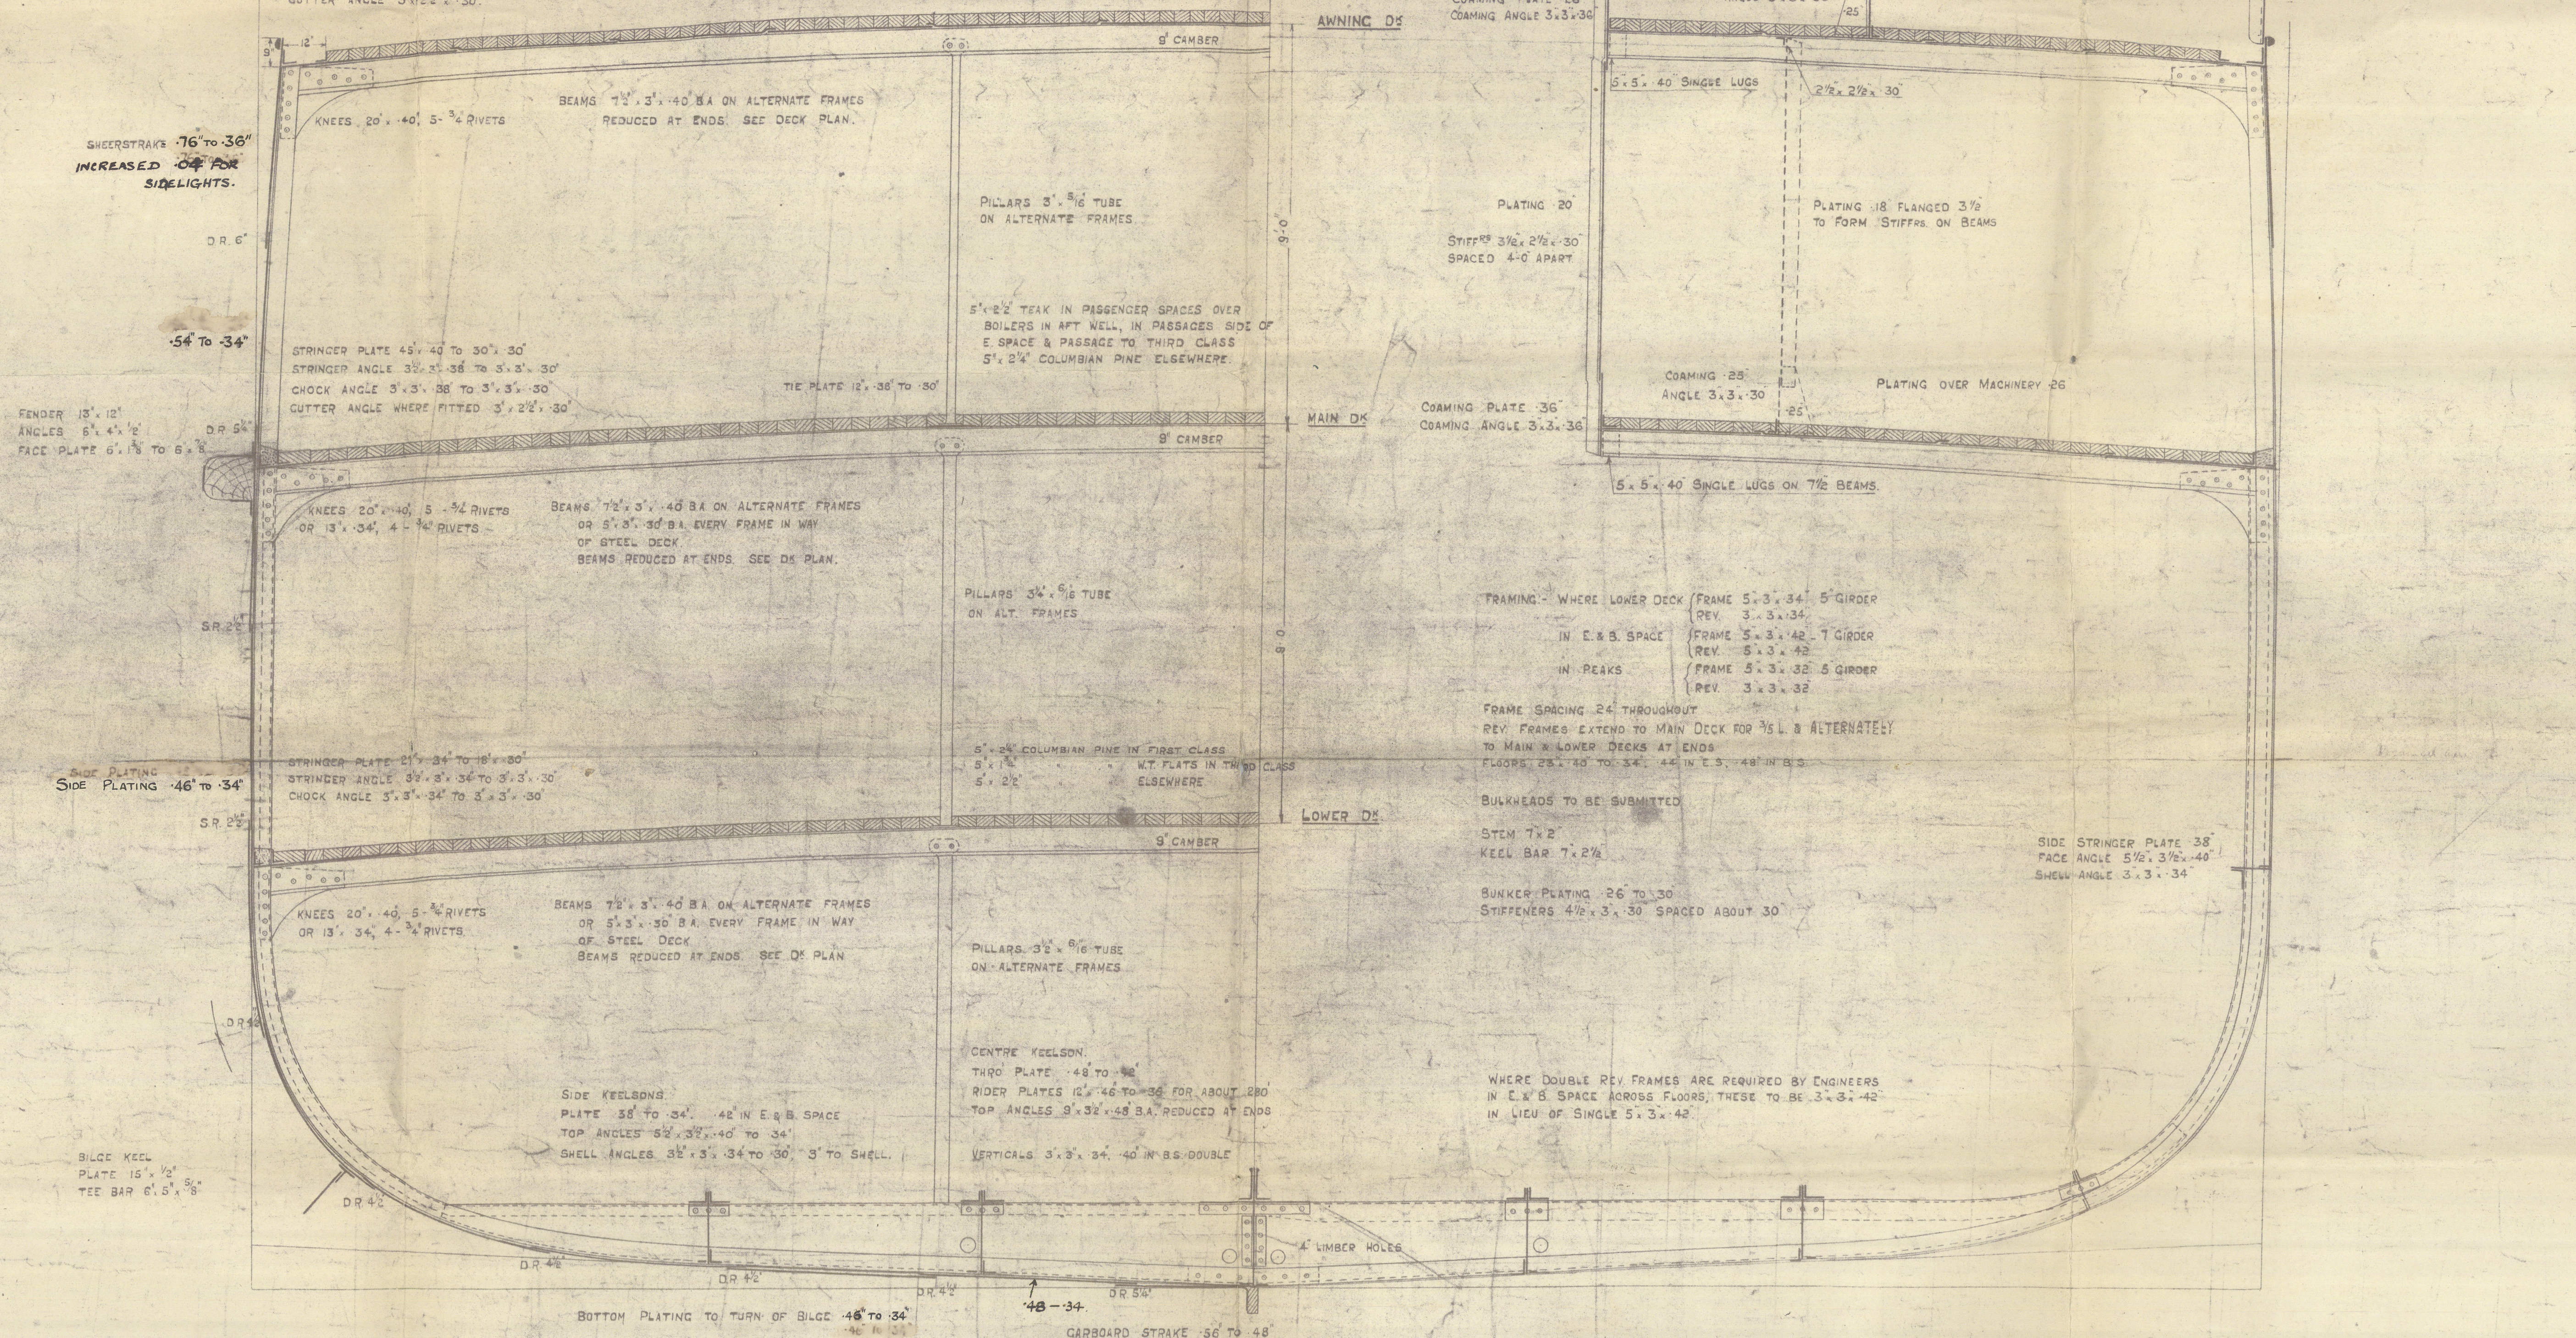

FRAMING: WHERE LOWER DECK (FRAME 5'x3'x34" 5" GIRDER  
REV. 3'x3'x34"  
IN E & B SPACE (FRAME 5'x3'x42" 7" GIRDER  
REV. 5'x3'x42"  
IN PEAKS (FRAME 5'x3'x32" 5" GIRDER  
REV. 3'x3'x32"

FRAME SPACING 24" THROUGHOUT  
REV. FRAMES EXTEND TO MAIN DECK FOR 1/2" L. & ALTERNATELY  
TO MAIN & LOWER DECKS AT ENDS  
FLOORS 28'x40" to 34'x42" IN E & B. 48" IN B.S.

BULKHEADS TO BE SUBMITTED

STEM 7'x2"  
KEEL BAR 7'x2 1/2"

BUNKER PLATING 26" TO 30"  
STIFFENERS 4 1/2"x3'x30" SPACED ABOUT 30"

WHERE DOUBLE REV. FRAMES ARE REQUIRED BY ENGINEERS  
IN E & B SPACE ACROSS FLOORS, THESE TO BE 3'x5'x42"  
IN LIEU OF SINGLE 5'x3'x42"



W. Denny Bros. Ltd.

No. 1036.

T.S.S. "Cambria"

GLASGOW REPORT No. 41541

M/S

RETAIN



© 2021

Lloyd's Register  
Foundation

W4506-0212