

propeller boss M16

If the liner is in more than one length are the junctions made by fusion through the whole thickness.

IRINGIA.

C.P.N. 8227.

It is submitted that
Does not appear to be
any objection to the
construction of the
liners.


total 4.30

oil requires 4.5C. 5A.

H.C.G. 24¹³/₁₆ - 51³/₁₆. 827 N.H.P.

cl. 08. 90th 2019

Burneister & Wain Cpa.

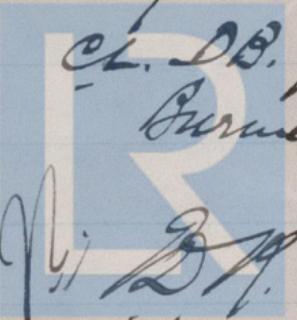

Lloyd's Register
Foundation

14/15/2020 0062

Holds, &c. on N.H.P. 1 off 6" diam. 1 off 8" diam. 2 off 3" diam.

Independent Power Pump Direct Suctions to the Engine Room Bilges, No. and size 1 off 6" diam. 1 off 8" diam. 2 off 3" diam.

~~zero~~ 5-0.

$$\begin{array}{r} 10 \\ - 5 \\ \hline 10 \\ \hline 7-0 \end{array}$$



© 2019

Lloyd's Register
Foundation