

BUILDING № 560.

— DIMENSIONS. —

LENGTH BETWEEN A.P.	425'-0"
BREADTH MOULDED	57'-0"
DEPTH	36'-0"
	SECOND DECK
	THIRD DECK

- SCANTLING'S NUMBERS AS COMPLETE SUPERSTRUCTURE VESSEL. -

$$\begin{aligned} D &= 28.0 + 81.0 = 36.0 \\ L \times D &= 425 \cdot 36 = 15300 \\ L \cdot [D + 3] &= 425 \cdot (36 + 57) = 39525. \\ \frac{3}{2} &= \frac{425}{36} = 11.8 \\ d_1 &= 28 - 3.62 = 24.38 \\ d_2 &= 18 - 3.62 = 14.38 \end{aligned}$$

-EQUIPMENT-

— RIVETING TABLE.—

— ANGLES IN DOUBLE BOTTOM

[illegible]

— PLATES IN DOUBLE BOTTOM. —



manholes in floors
intercostals in way of pillars

KEELPL. 52. 3 50c 3/5L

A 40.75
- 60.58 FOR 1/2 L TO
- 50 AT ENDS

B 40. 78
 .60 56 For 1/2 L To
 .50 17 ENDS

C. Ab 73
.60. 50 For 2 L To
 .50 47 ENDS.

D = 78"

60 - 78 = 18 1/2" = 18"

50" AT ENDS

STRAKE A. 3. C. TO MAINTAIN THE MODER THICKNESS
TO FORWARD COLLISION BULKHEAD.

BOSS PLATES

Bottom strengthened forward
as per Rules

THIS DRAWING IS STRICTLY CONFIDENTIAL
AND MUST ON NO ACCOUNT BE COPIED OR
DISCLOSED FOR ANY THIRD PERSON.
COPENHAGEN. DATE: 8/5-29.

AKTIESELSKABET
BURMEISTER & WAIN'S MASKIN- OG SKIBSBYGGERI

© 2019

MRSH. P. SECTION.

-oundation


0151-0072

Baum. & Wais

No. 560.

(Design 13128.)

Midship section

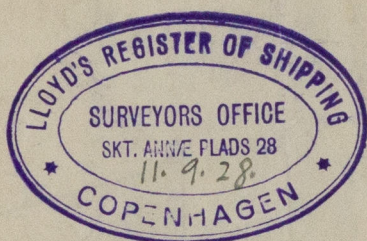

M. S. "Bouingia"

Copenhagen Repat N° 8227.

X1151-0072

MIDSHIP SECTION

X151-0072



© 2019

Lloyd's Register
Foundation