


727
96536

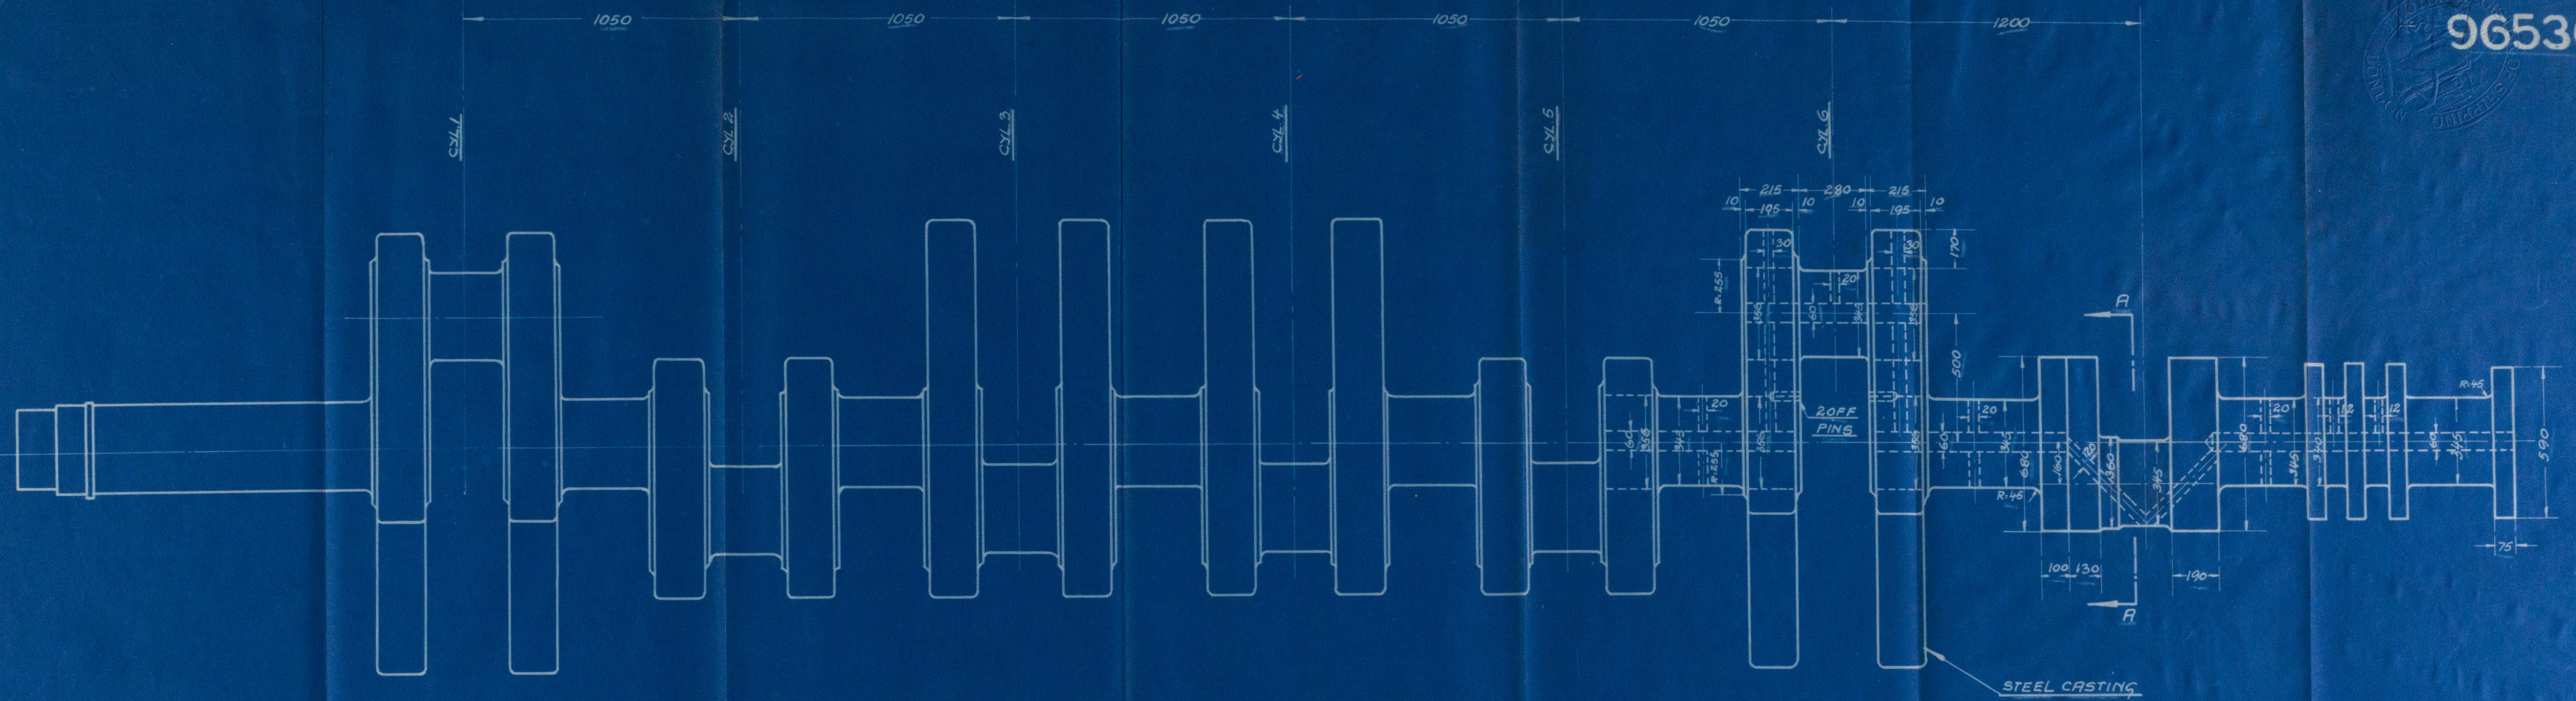


CRANK SHAFT FOR YARD N°

ODENSE 30

6 CYLINDER FOUR CYCLE DIESEL ENGINE

CYL. DIAM. 550 M/M STROKE 1000 M/M

THIS DRAWING AND THE DESIGN SHOWN THEREIN, IS THE PROPERTY OF BURMEISTER & WAIN LIMITED, AND IS ONLY ALLOWED TO BE USED BY EXPRESS PERMISSION AND LICENSE FROM BURMEISTER & WAIN LIMITED COPENHAGEN

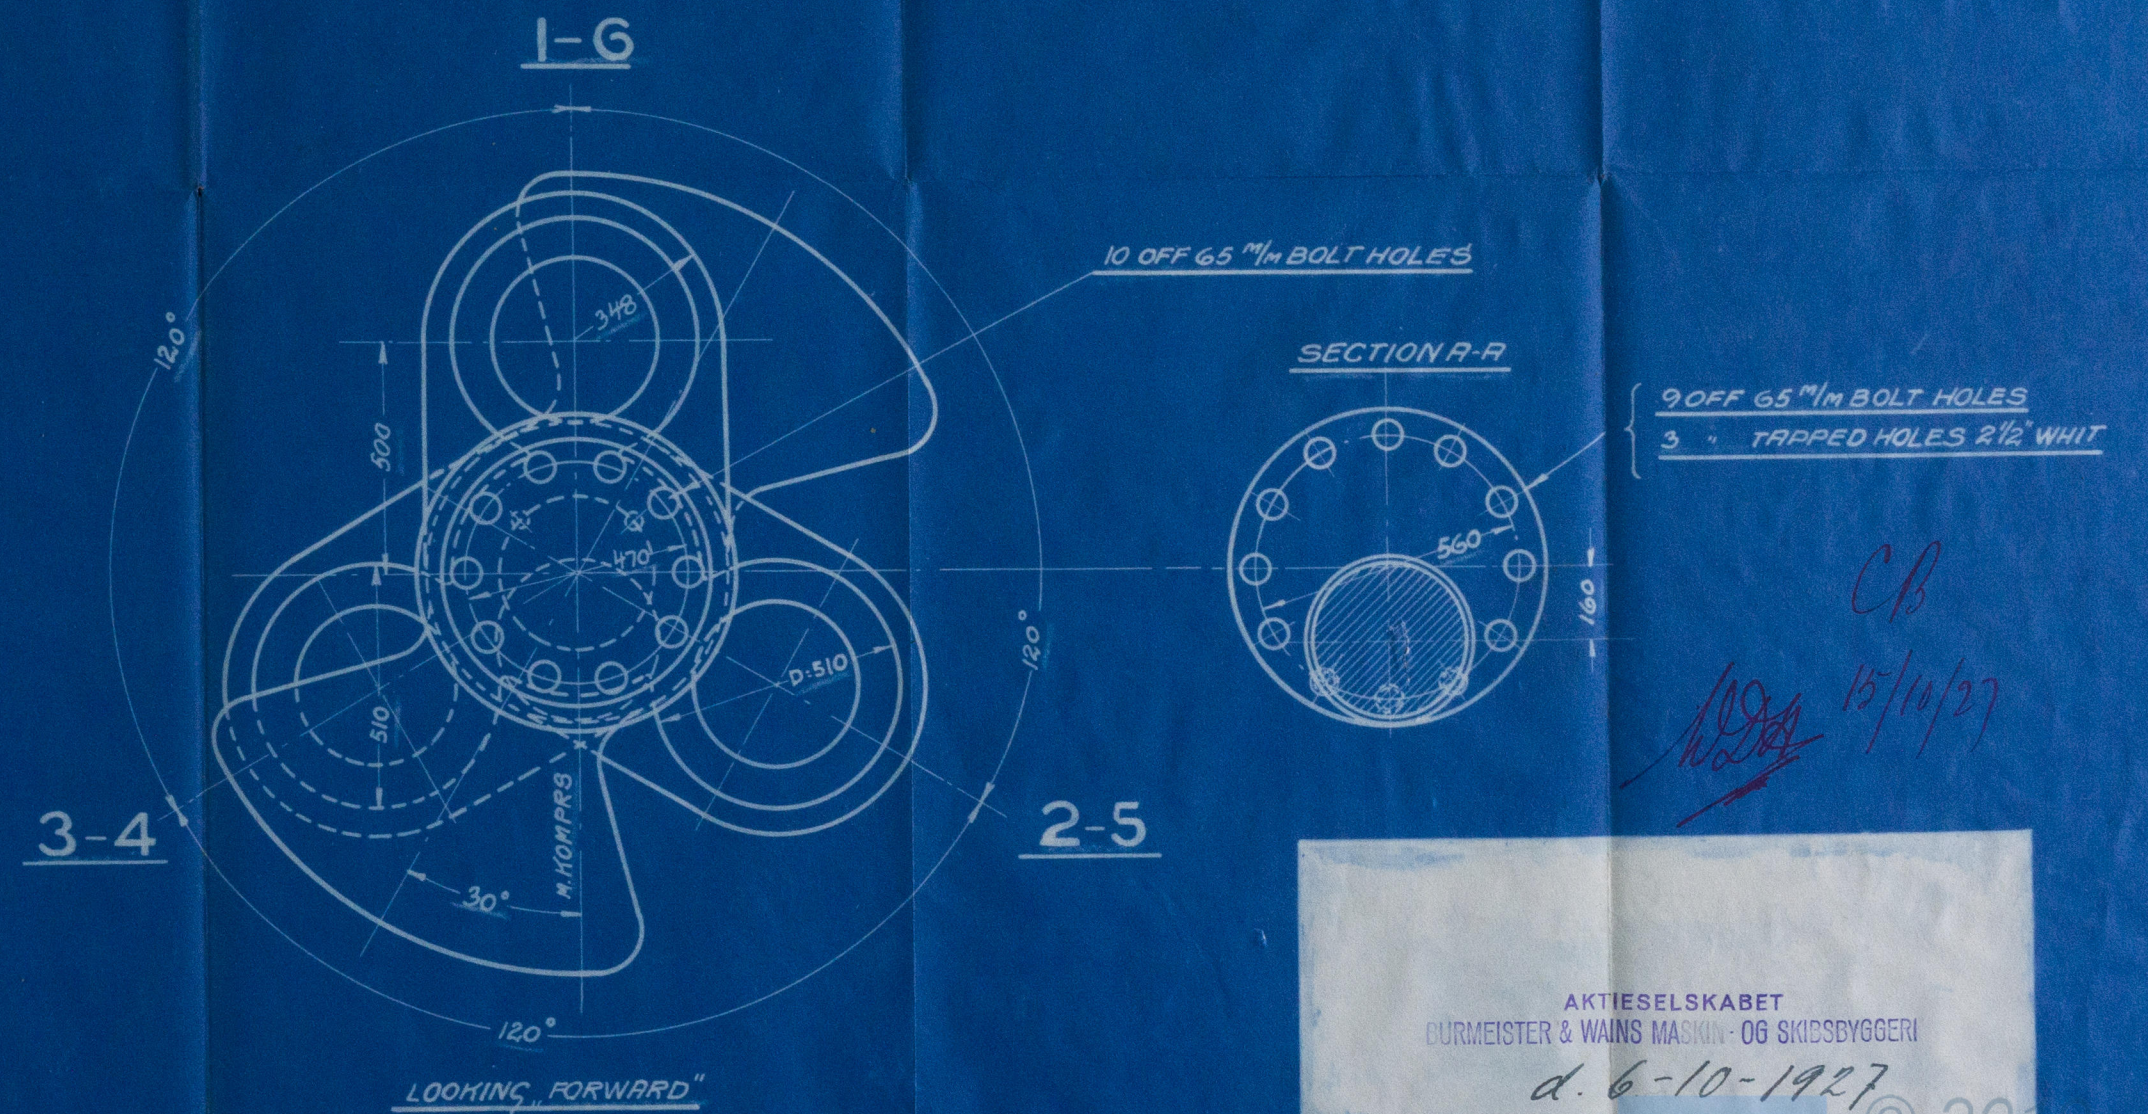


AKTIESELSKABET
BURMEISTER & WAIN MASKIN- OG SKIBSBYGGERI

d. 6-10-1927

E. Volmer

1010-151

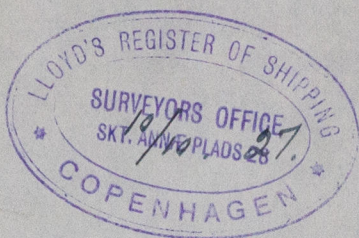

Plan of
CRANK AND THRUST SHAFTS
for the Main Diesel Oil Engines
to be constructed by

AKTIESELSKABET
DURMEISTER & WAINS MASKIN- OG SKIBSDYGGERI

Copenhagen
for the Twin Screw Motor Tank Vessel

Yard N^o 30

being built by

Odense Staalskibsværft
ved A. P. Möller.

Odense.
Ben Brush ex.

M/S Caroline Mærsk

A. Fredericia
© 2019
cop. Rpt. V- 7845.

Lloyd's Register
Foundation

W151-0104