

Midship Section
with engine
for 1400

14. 12. 06
 16. 1. 07.

S. S. N^o 399 & 400.


MIDSHIP SECTION.

DIMENSIONS 82'0" x 18'3" x 9'0" ML

SCALE $\frac{1}{2}$ " = 1 FOOT

TO CLASS 100 A1 FOR FISHING PURPOSES.

DECK PLATED OVER IN WAY OF MACHINERY SPACE

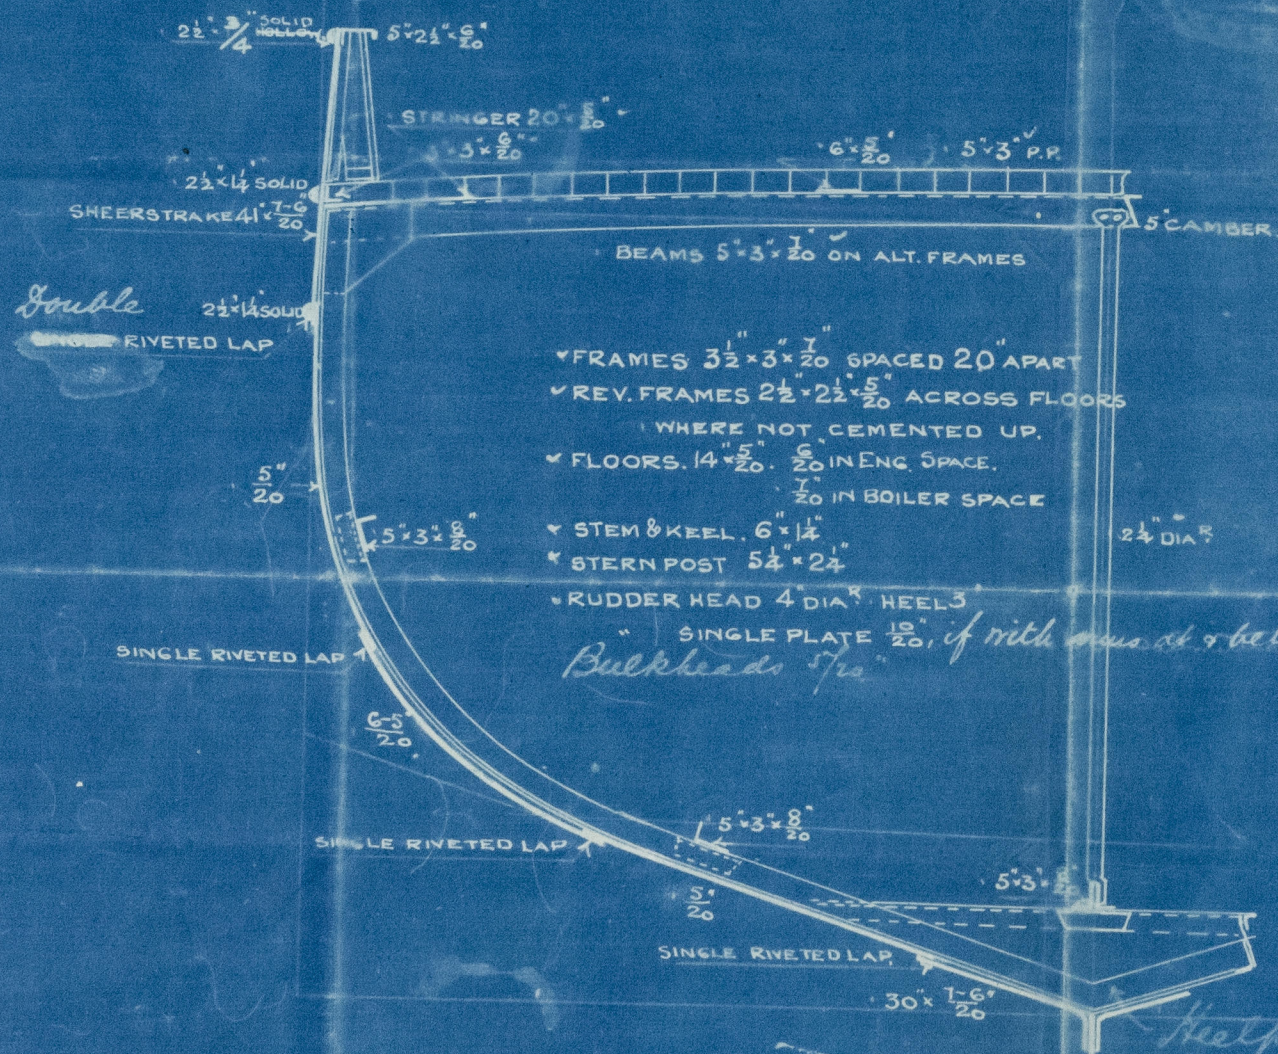

NUMERALS

$\frac{1}{2}B = 9.08$
 $\frac{1}{2}G = 14.63$
 $D = 9.37$
 $1^{st} N^o = 33.08$
 RULE LEN. 81.06
 $2^{nd} N^o = 2681.46$

PROPORTIONS

$\frac{L}{D} = 8.65$
 $\frac{L}{B} = 4.46$

EQUIPMENT

2 BOWER ANCHORS 3 CWT EACH EX. STOCK
 1 " " " " " "
 60 FATHOMS $\frac{12}{16}$ CHAIN CABLE
 60 " 5" HAWSER
 60 " 2 1/2" WARP

Keelpiece
Ch.

14. 12. 06.

ORAS
 12. 12. 06

Midship Seehor
Cochrane & Son No 400
of Lord Charles Beresford
Hull Rep. No. 18959

REMAIN

W1513-0114



© 2021

Lloyd's Register
Foundation