

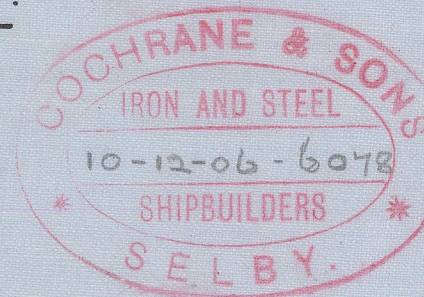


14.12.06
16.1.07

PROFILE & DECK PLAN
STEEL SCREW DRIFTER
No 399 & 400
DIM. 82'-0" x 18'-3" x 9'-0" MOULDED.
SCALE $\frac{1}{4}$ " = ONE FOOT.

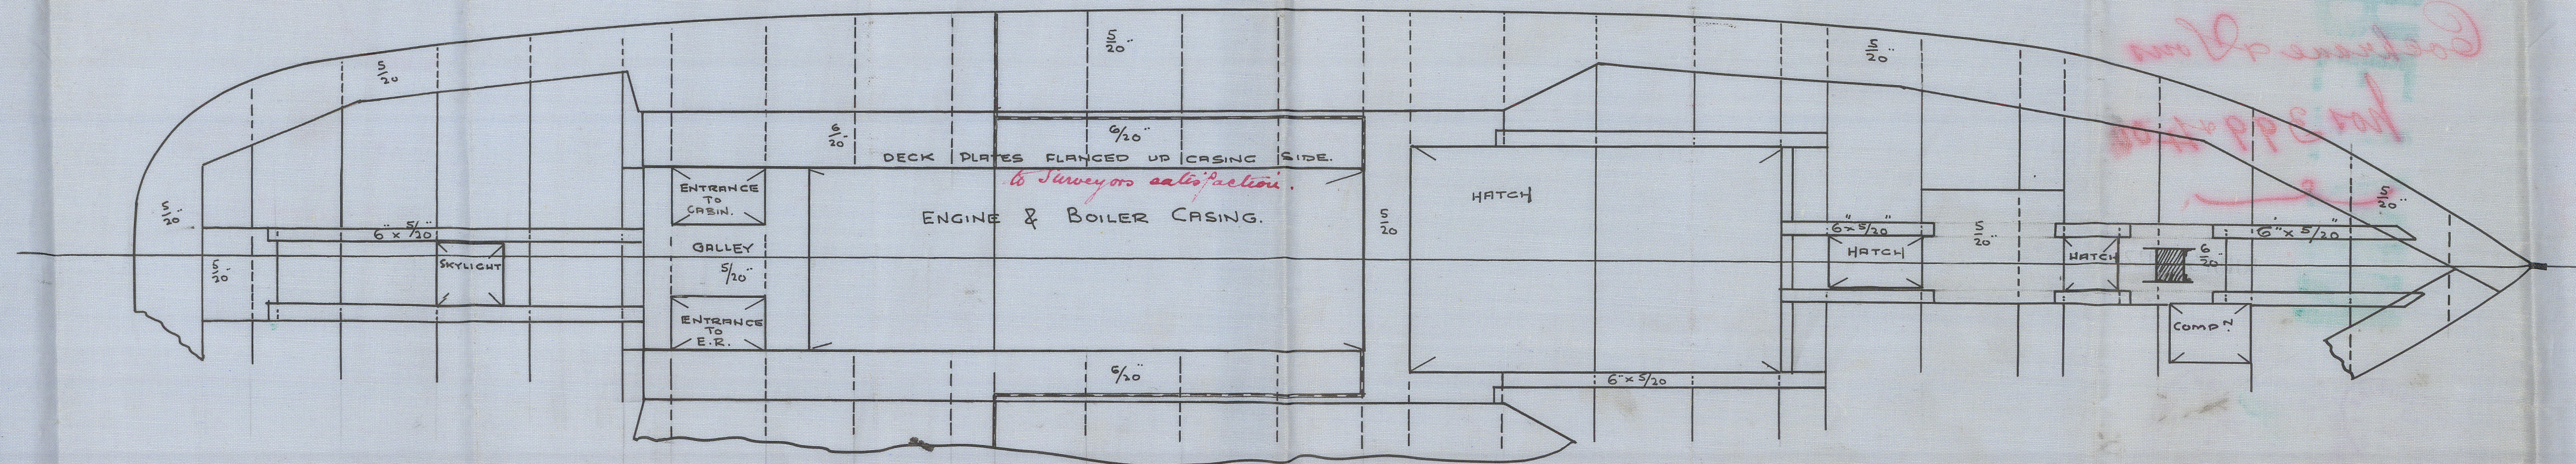

*machinery shifted one
frame space up as shown
in red*

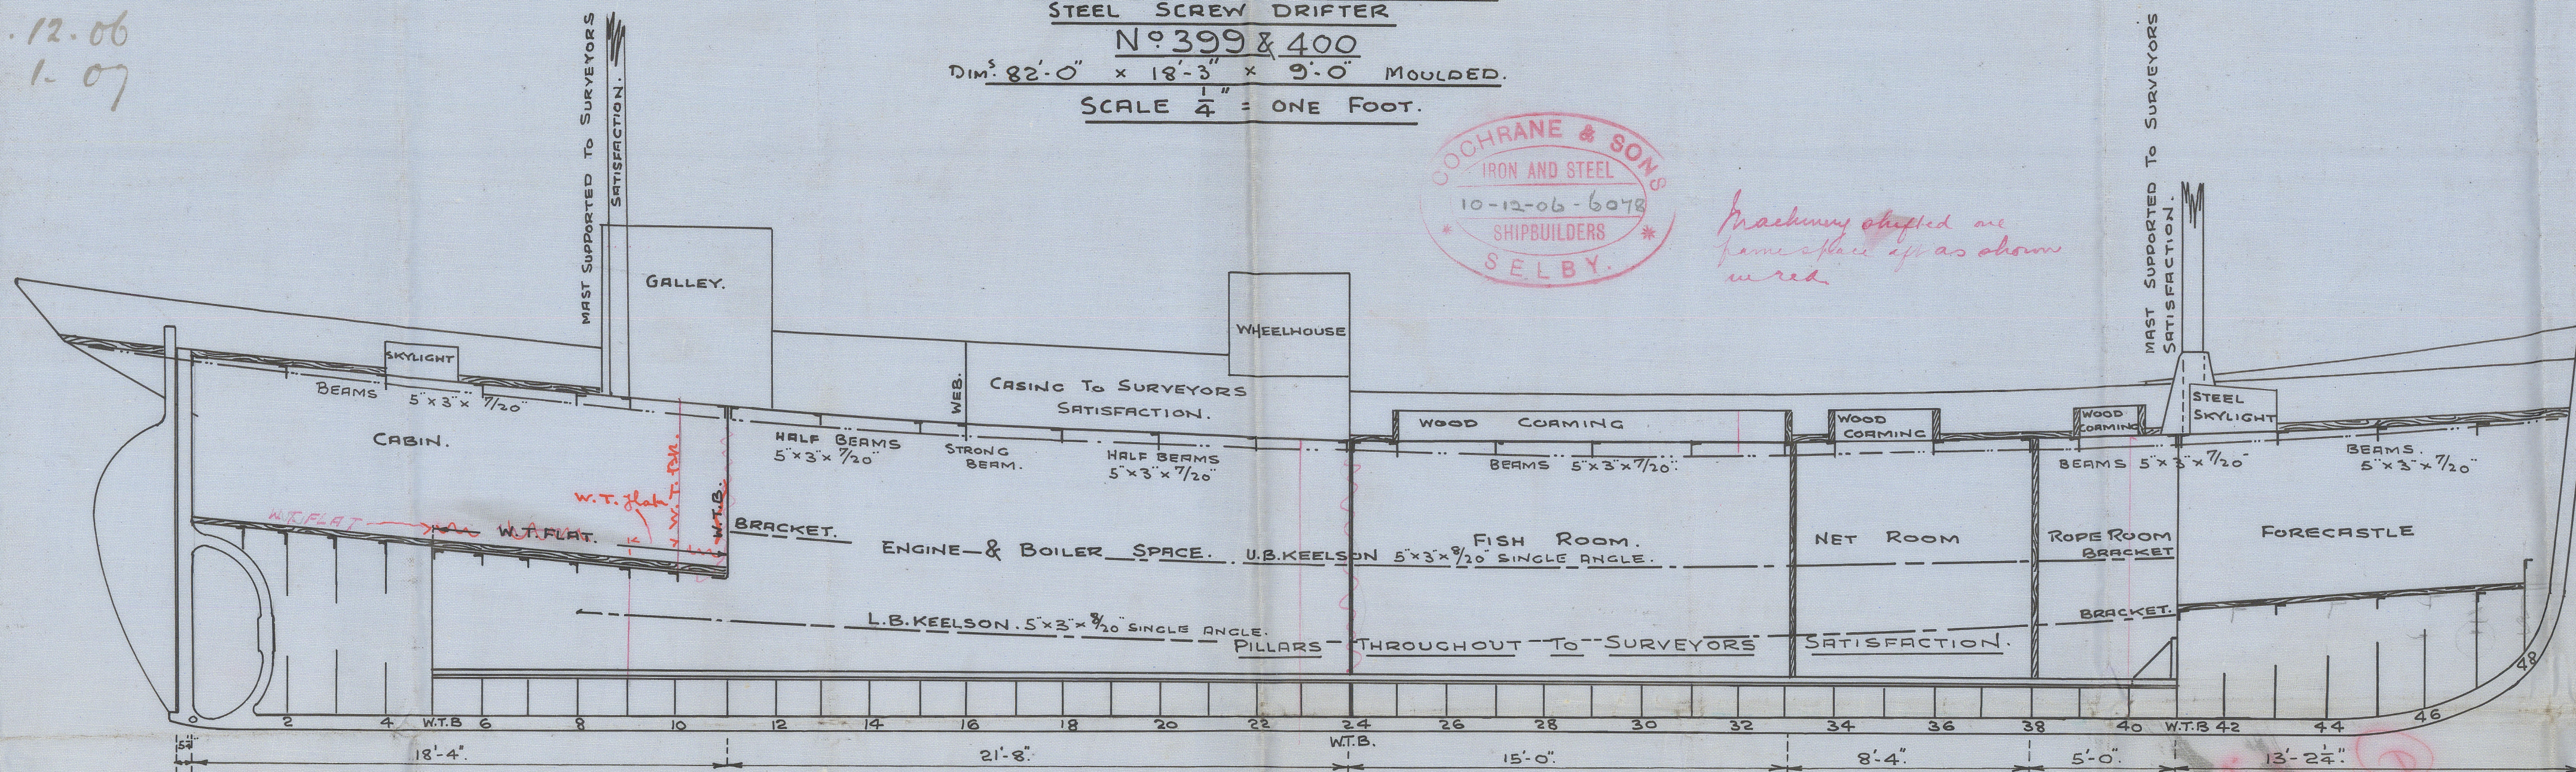

C.B.
14.12.06.

COCHRANE & SONS
SHIPBUILDERS
SELBY.
14.12.06

3/5 Nordland Hamilton Ave R4th 18958
- Nordland Hamilton - - - 18959