

15.6.05
19.6.05
4.7.05
31.8.05
27.9.05
8.11.05

MIDSHIP SECTION.

T.S.S. No 519.

DIMENSIONS.
420'0" B.P. x 51'0" EXT. x 30'9" M.L.G. L.P. x 31'2" AT Q.

CLASS 100 A.I. SPAR Dk LLOYDS.

SCALE 1/2" = 1 FOOT.


THREE DECK		SPAR DECK	
1/2 BREADTH	25'37"	1/2 BREADTH	25'37"
1/2 GIRTH	53'54"	1/2 GIRTH	45'56"
DEPTH	32'20"	DEPTH	24'22"
	111'11"	FRAME No	95'15"
	7'00"		418
FRAME No	104'11"	PLATING No	39772
PLATING No	43517.98		
DEPTHS TO LENGTH	418' = 12'98"	DEPTHS TO LENGTH	418' = 17'25"

FRAMES: 6" x 3 1/2" x 7/8" SPACED 24" APART, TO FORM 7" GIRDER.
IN CELLULAR BOTTOM 3 1/2" x 3 1/2" x 7/8"
ON BULKHEADS 6" x 6" x 7/8" x 1/2"

REVERSE FRAMES: 4" x 3 1/2" x 7/8" ALL TO SPAR DECK FORE & AFT.
(IN FORECASTLE TO SPAR & POLE DKS ALTERNATELY)
IN CELLULAR BOTTOM 3 1/2" x 3 1/2" x 7/8" UNDER BOILERS 1 1/2"
DOUBLE IN ENGINE SPACE UNDER BOILER BEARERS.
4 1/2" x 7/8" 4 1/2" x 7/8"

FLOORS AT ENDS: 7/8"
2 KEEL SLABS 12" x 1 1/2"
STEM 12" x 2 1/2"
STEER POST 11" x 7/8"
RUDDER HEAD 10 1/4" DIA TO FORMULA

4" x 4" x 10" x 3" IN BOILER SPACE
CENTRE GIRDER 4" x 10" x 3" x 11"
TOP OF KEEL x 11"
1/2" IN BOILER SPACE
TREBLE RIVETED OVERLAPS

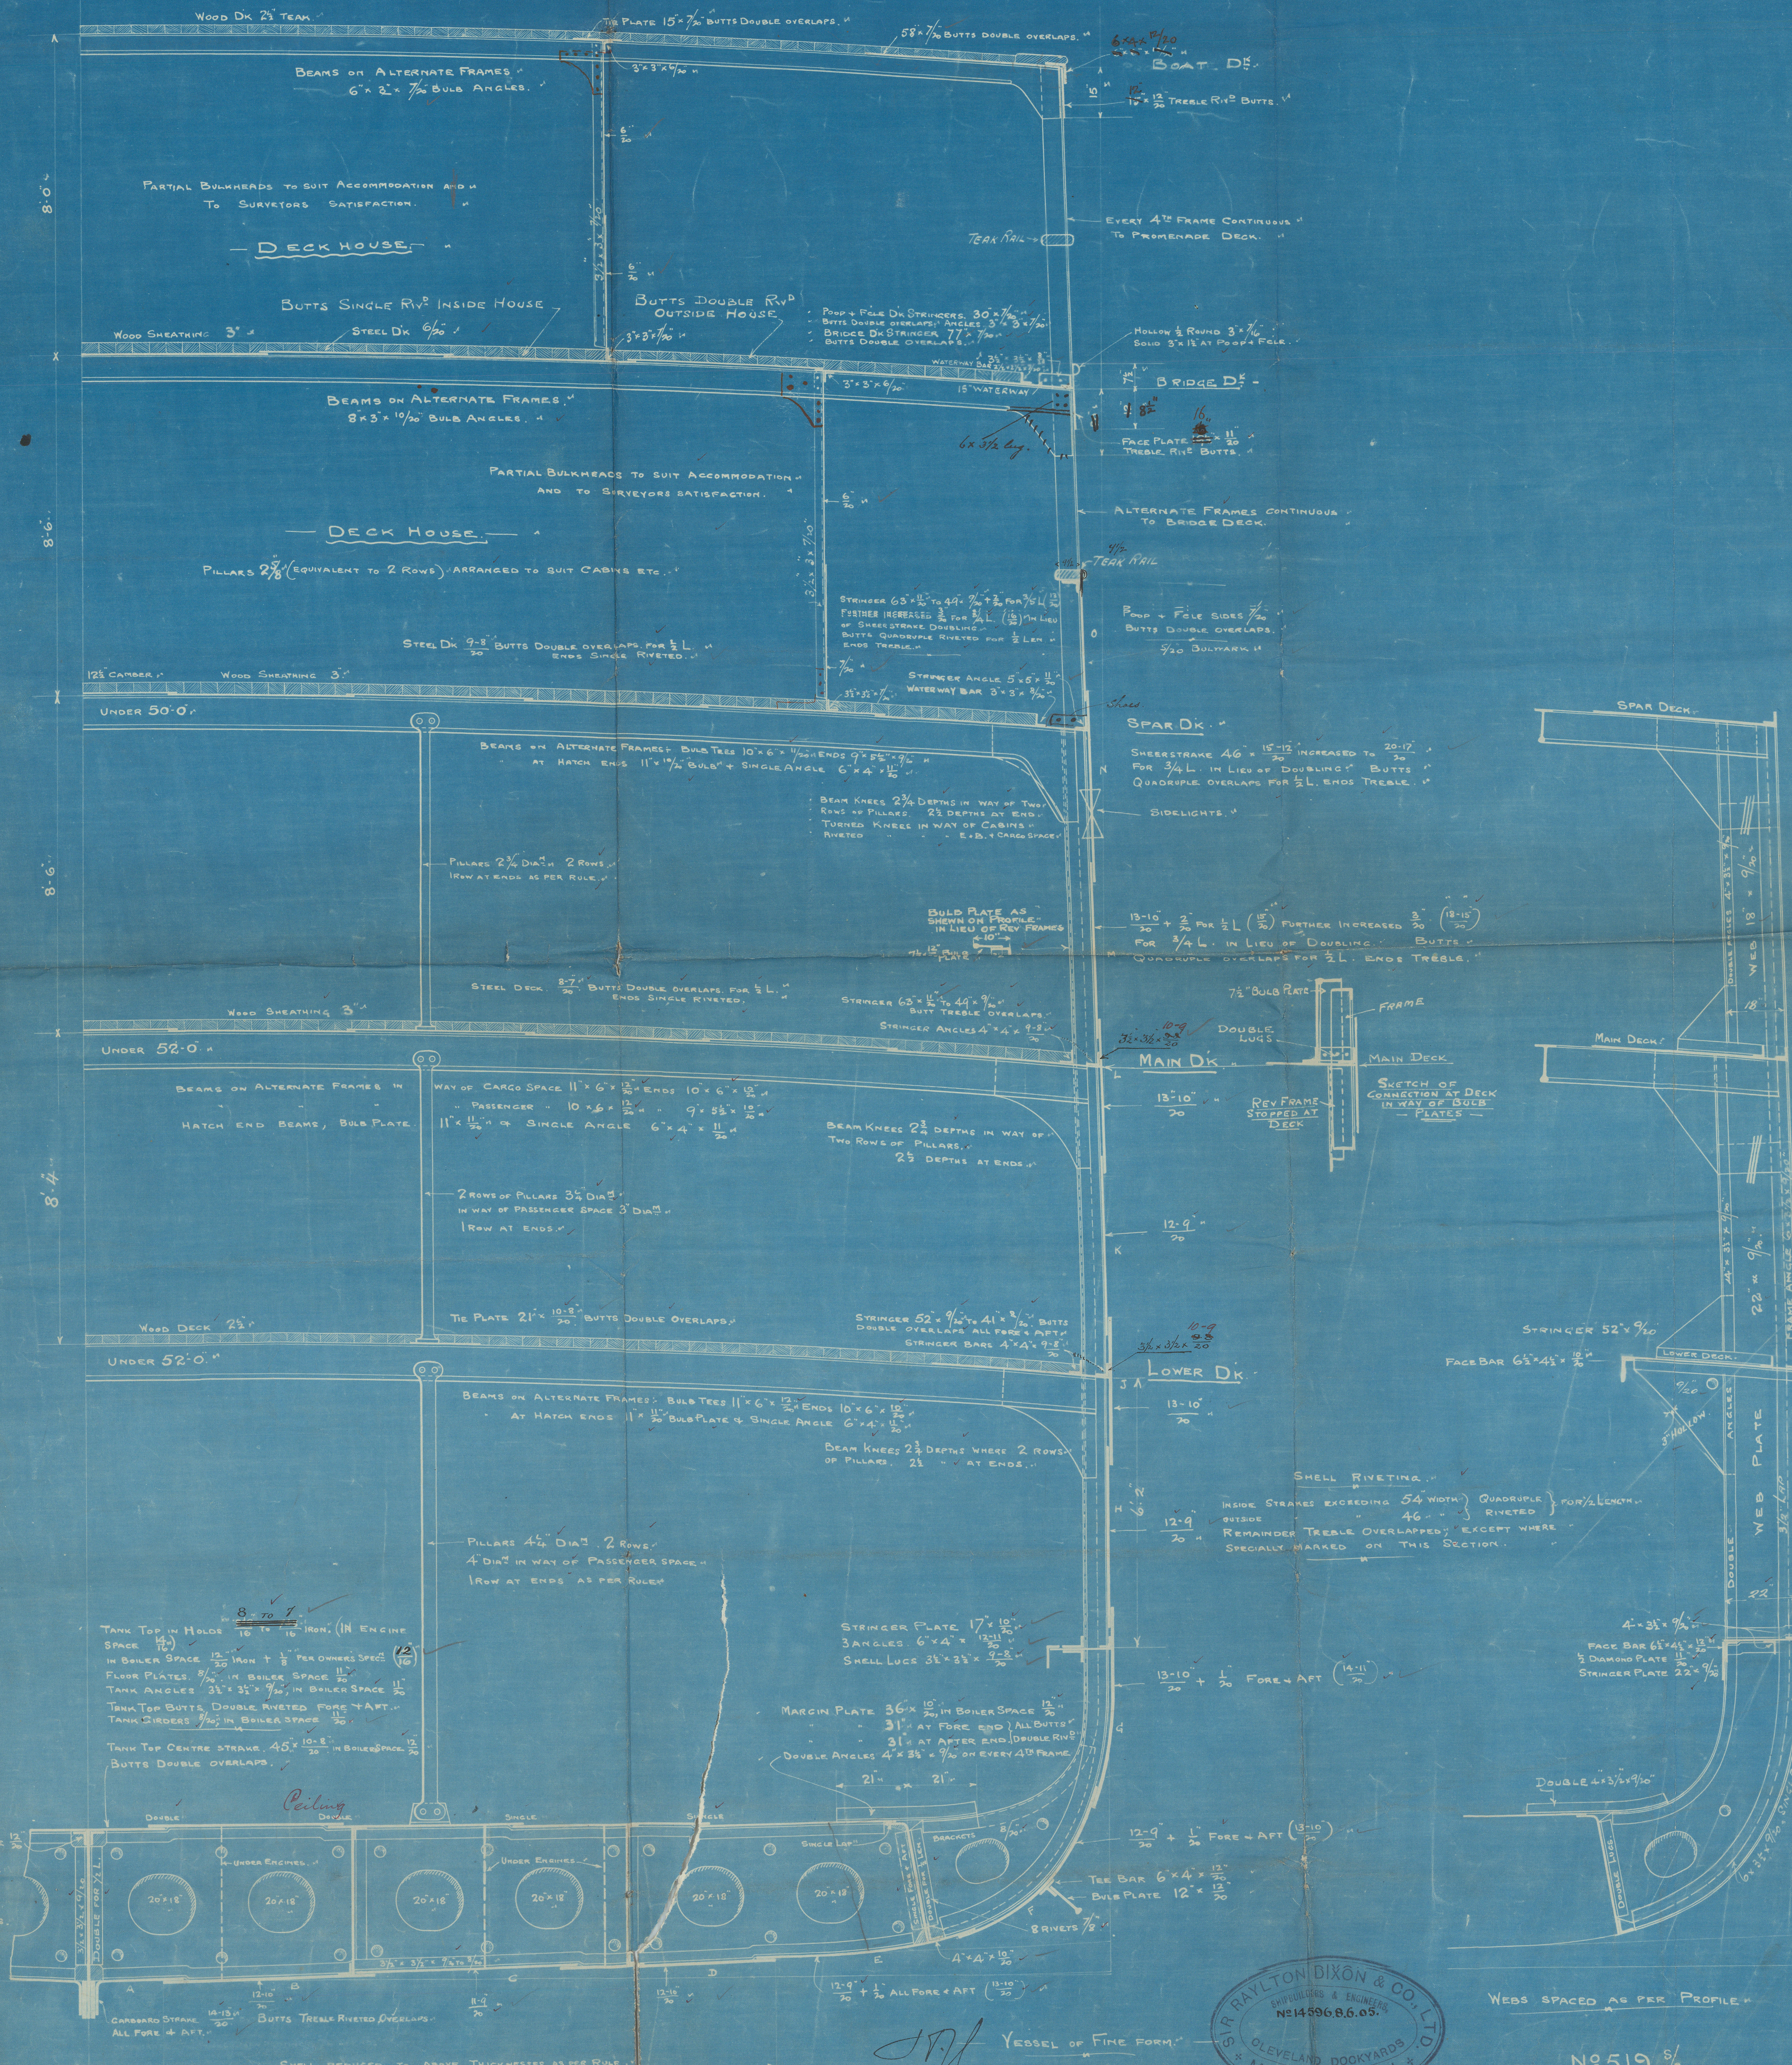

SIR RAYLTON DIXON & CO. LTD.
ENGINEERS & ARCHITECTS
14, 15, 16,100

No 519.5

Sir R. Dixon & Co.





T. S. S. No 519.

Midship Section.

Sp. 'Lusitania'

Indt. report No. 4588

Lusitania

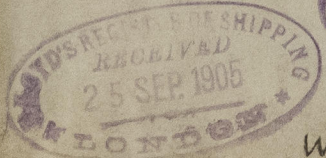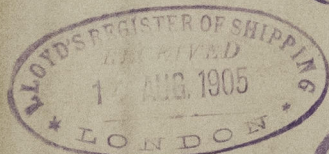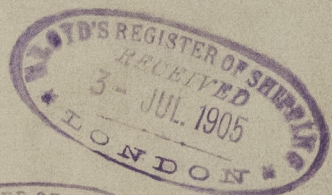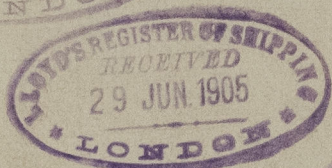

W1514 - 0012



© 2021

Lloyd's Register
Foundation