

844 R. Sept 20th 05


27.9.05

T.S.S. N^o 519


PLAN OF SPAR & MAIN DECKS

SCALE 1/8" = 1 FOOT

SPAR DECK

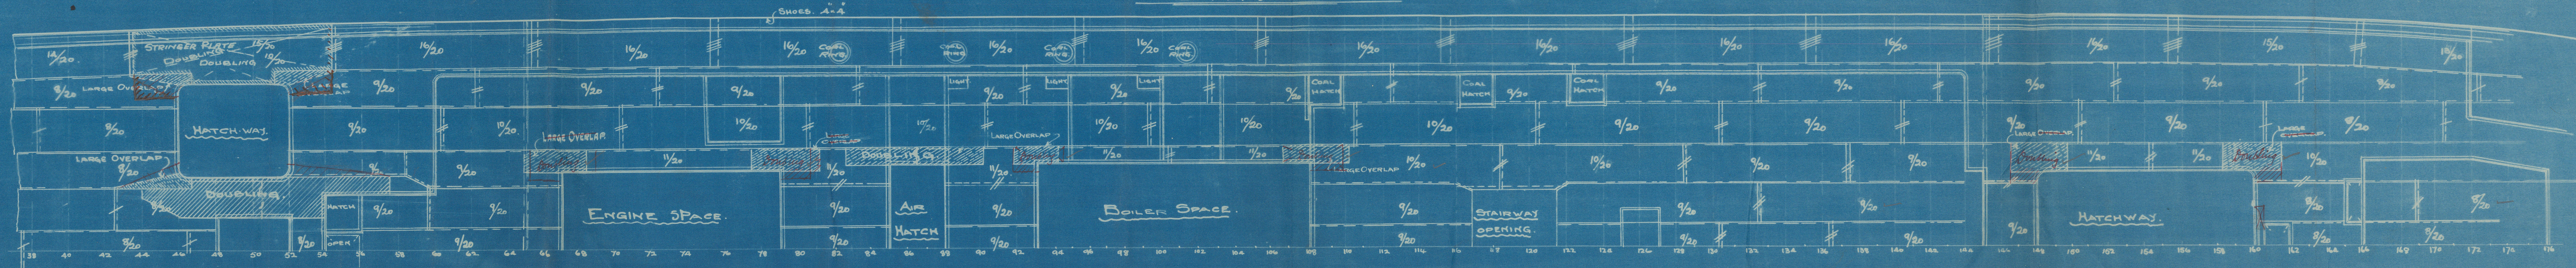

MAIN DECK

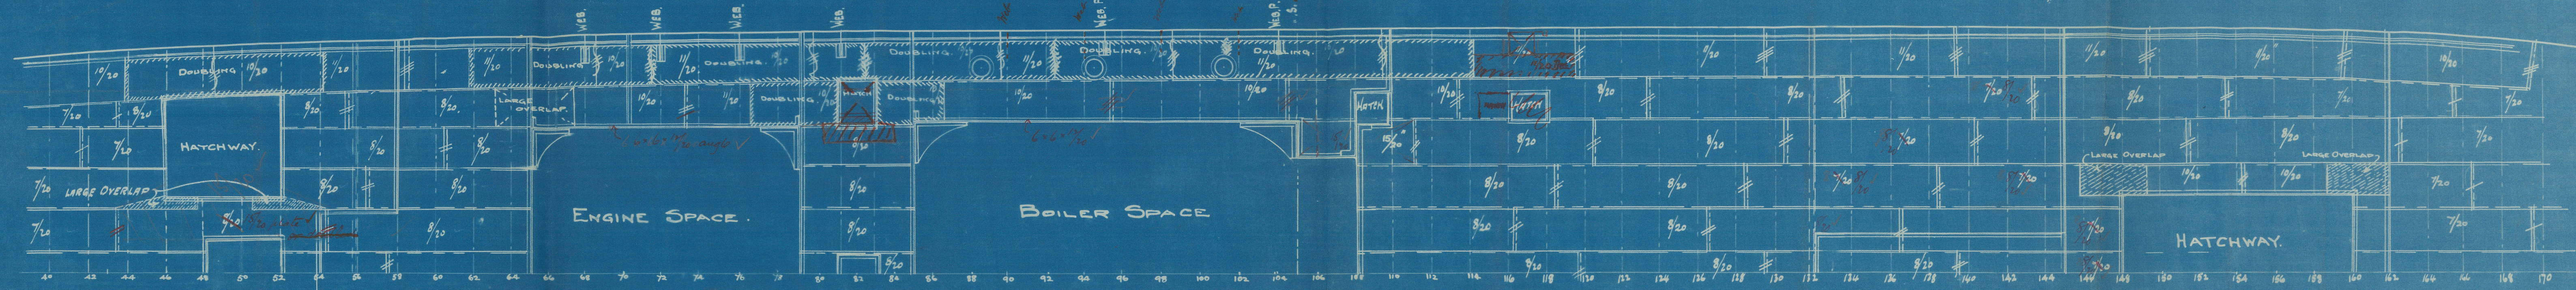

C.B.
27.9.05.

© 2021
FROM SIR RAYLTON DIXON & Co., LD., MIDDLESBROUGH.

ENCLOSURE FOR

Messrs Lloyds Surveyors

Oct. 5th 1905.

0014(2)
31

Sir Raylton Dixon & Co.
T. S. S. No 519.

Spar & Main Deck
Plating Plan.

2/2 Lusitania

Mdb report No 4588



RETAIN



© 2021

Lloyd's Register
Foundation
W1514-0014

579



© 2021

Lloyd's Register
Foundation