

PROFILE & DECK PLAN

SCALE $\frac{1}{4} \text{ IN} = 1 \text{ FT}$


SCALE $\frac{1}{4}$ IN = 1 FT

A. M.
17/12/12

NORWAY PINE MAS
TO LOWER AFT.

Masts supported to
surveyors satisfaction.

1877-78
 1878-79
 1879-80

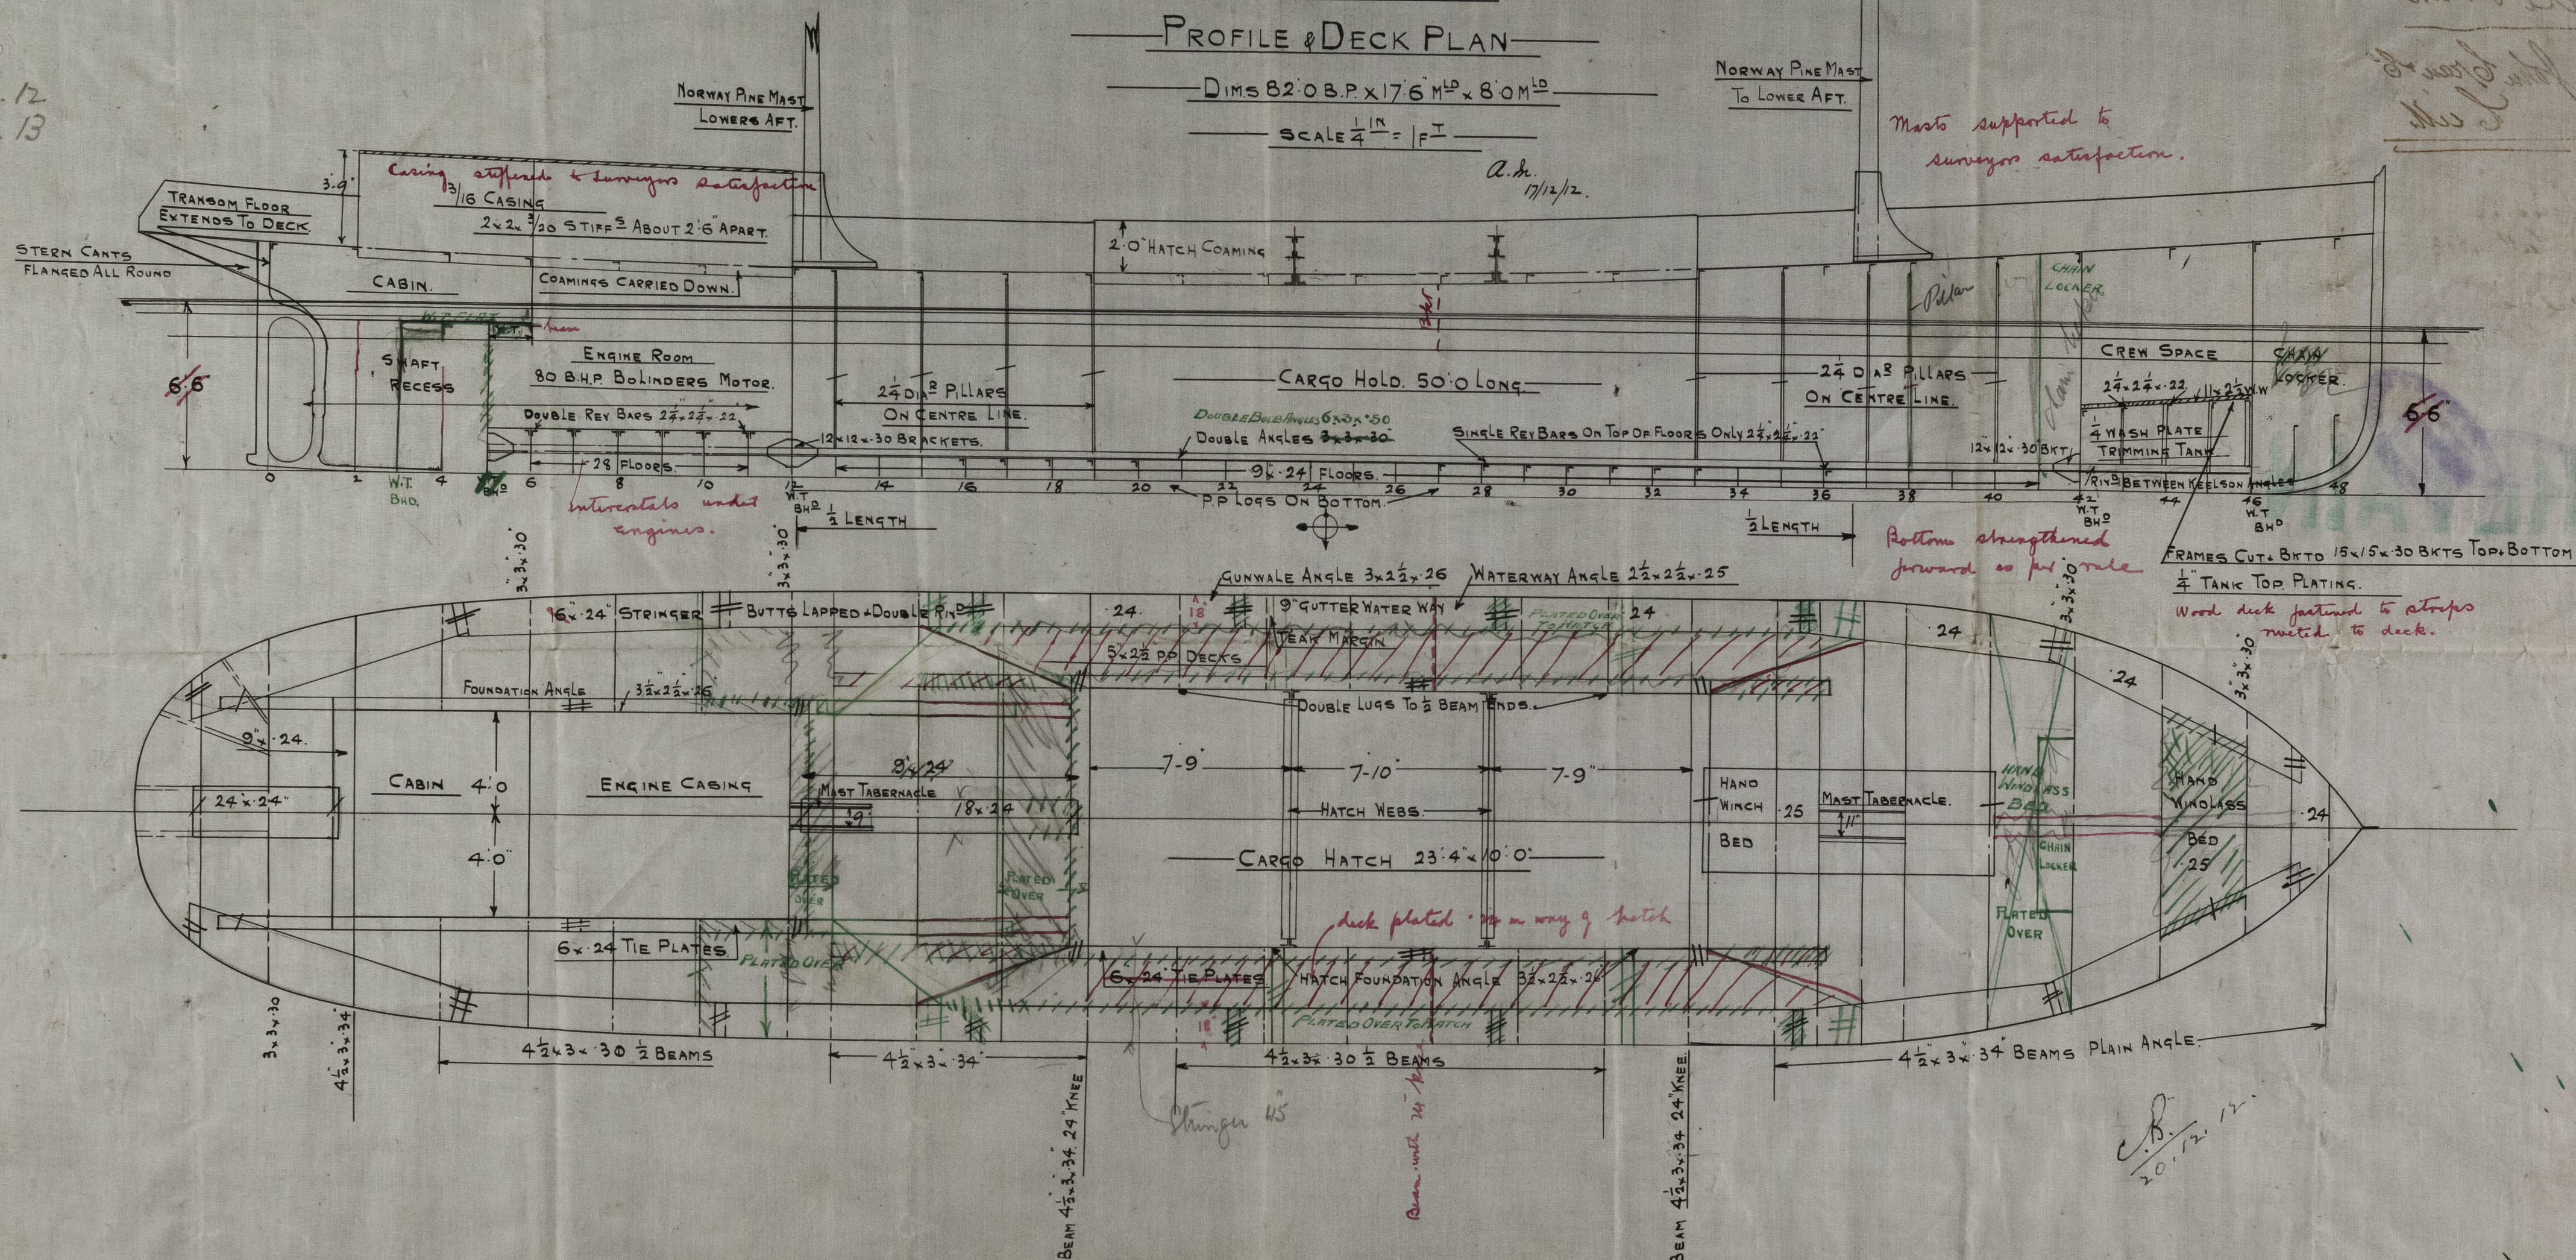

C.B. 12.
20.12.12.


No 94-98

Profile Plan

Geno John Cran & Co
Lith

St. Louis
Lith 14213

St. Louis
Lith 14214

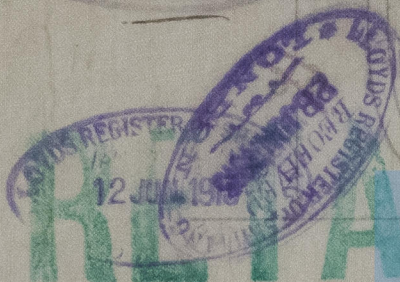

© 2021

Lloyd's Register
Foundation

W1516-0088