

70-11-05

- 363 & 4

MIDSHIP SECTION

STEEL SCREW TRAWLER

LENGTH 127'0. BREADTH 22'0 DEPTH HOLD 11'6 MLD 12'4

TO CLASS 100A1 STEAM TRAWLER

SCALE 1/2" = 1 FOOT

NUMERALS AS PER RULES


BREADTH 10'95
GIRTH 13'62
DEPTH 12'80
43'37-1ST NO
125 79 RULE LENGTH
- 5456 5123 2ND NO

PROPORTIONS

DEPTH TO LENGTH 9'8
BREADTH 5'7


EQUIPMENT

1ST BOWER 5 1/2 CWTs EX STOCK
2ND BOWER 5
3RD BOWER 2 3/4
105 FATH 1 1/2 DIA CABLE
60 " 6 HAWSER
60 " 4 1/2 WARD

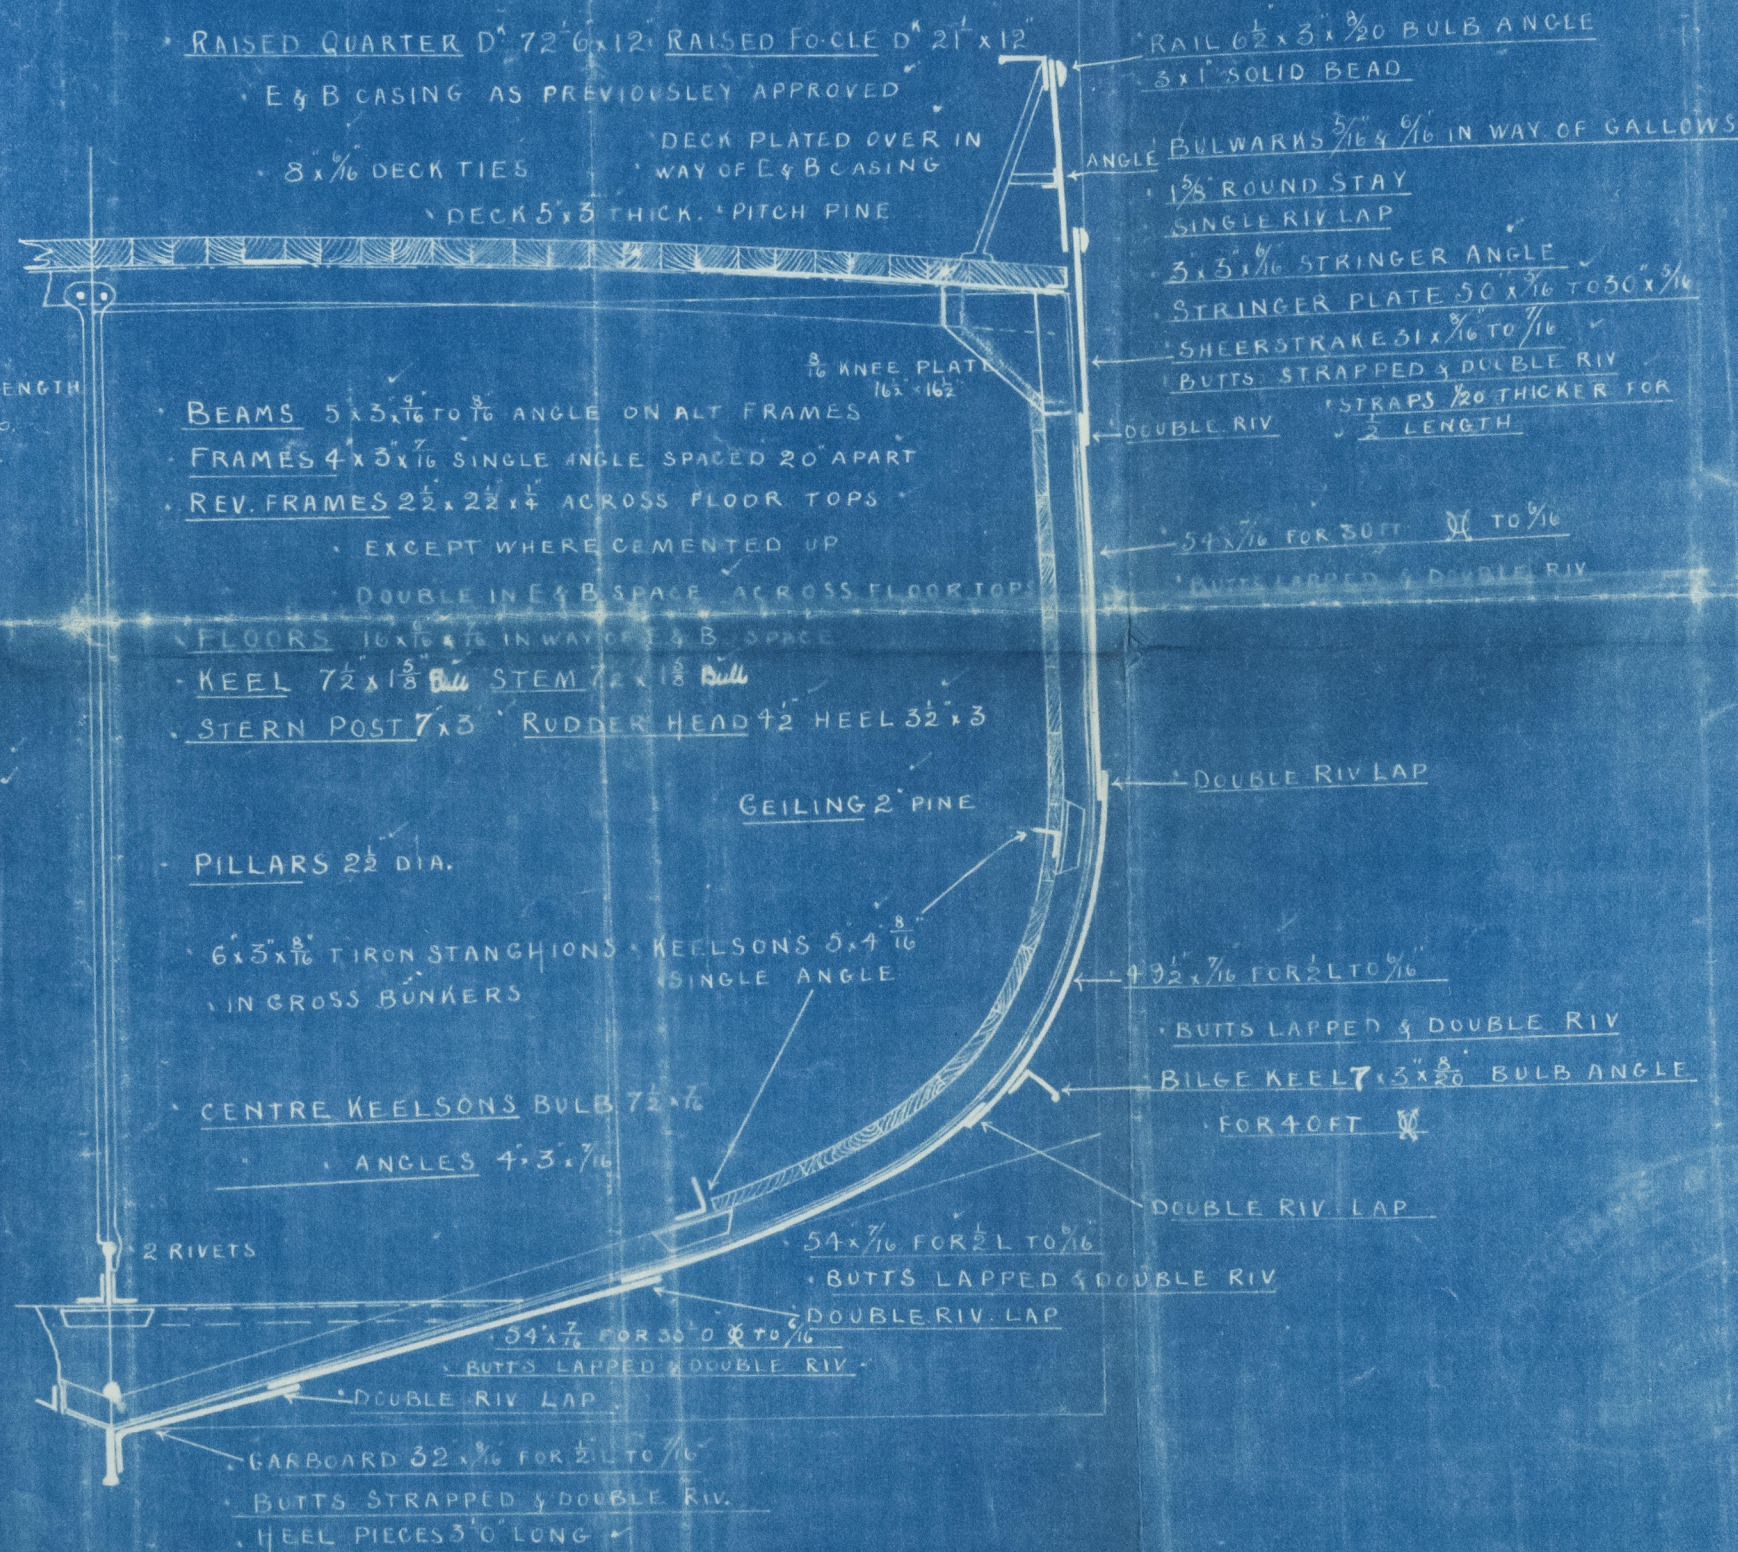

W 302-304
C. J.
20/11/05

W 1518-0180

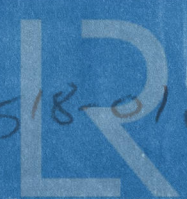

Lloyd's Register Foundation

Lynx II Cochrane's
364.

Stul Rpt 17945.

Midship Section.

RETAIN



© 2021

Lloyd's Register
Foundation

W 1518-0180