

MIDSHIP SECTION

Steel Screw ^{OF} Steam Drifter

Class 100 AT at Lloyds

S.S. N^o 339 354, 355, 359

DIMENSIONS

| | | |
|---------|---|--------|
| Length | L | 86'-0" |
| Breadth | B | 18'-6" |
| Depth | D | 9'-6" |
| Depth | d | 8'-34 |


Transverse N^o B+D = 28'-0"

Longitudinal N^o L x (B+D) = 2408

Depths in Length 9.05

EQUIPMENT


| | | | |
|--------------------------------|----------------------|----------------|------------------------|
| 1 st ANCHOR | 3 1/2 cwt | EX Stock | Black |
| 2 nd D ^o | 3 1/2 D ^o | D ^o | |
| 3 rd D ^o | 2 D ^o | D ^o | |
| 60 FATHOMS | 1 1/2 | stud link | chain galvanized |
| 60 D ^o | 5 1/2 | Hawser | and 60 Fathoms 3" Warp |

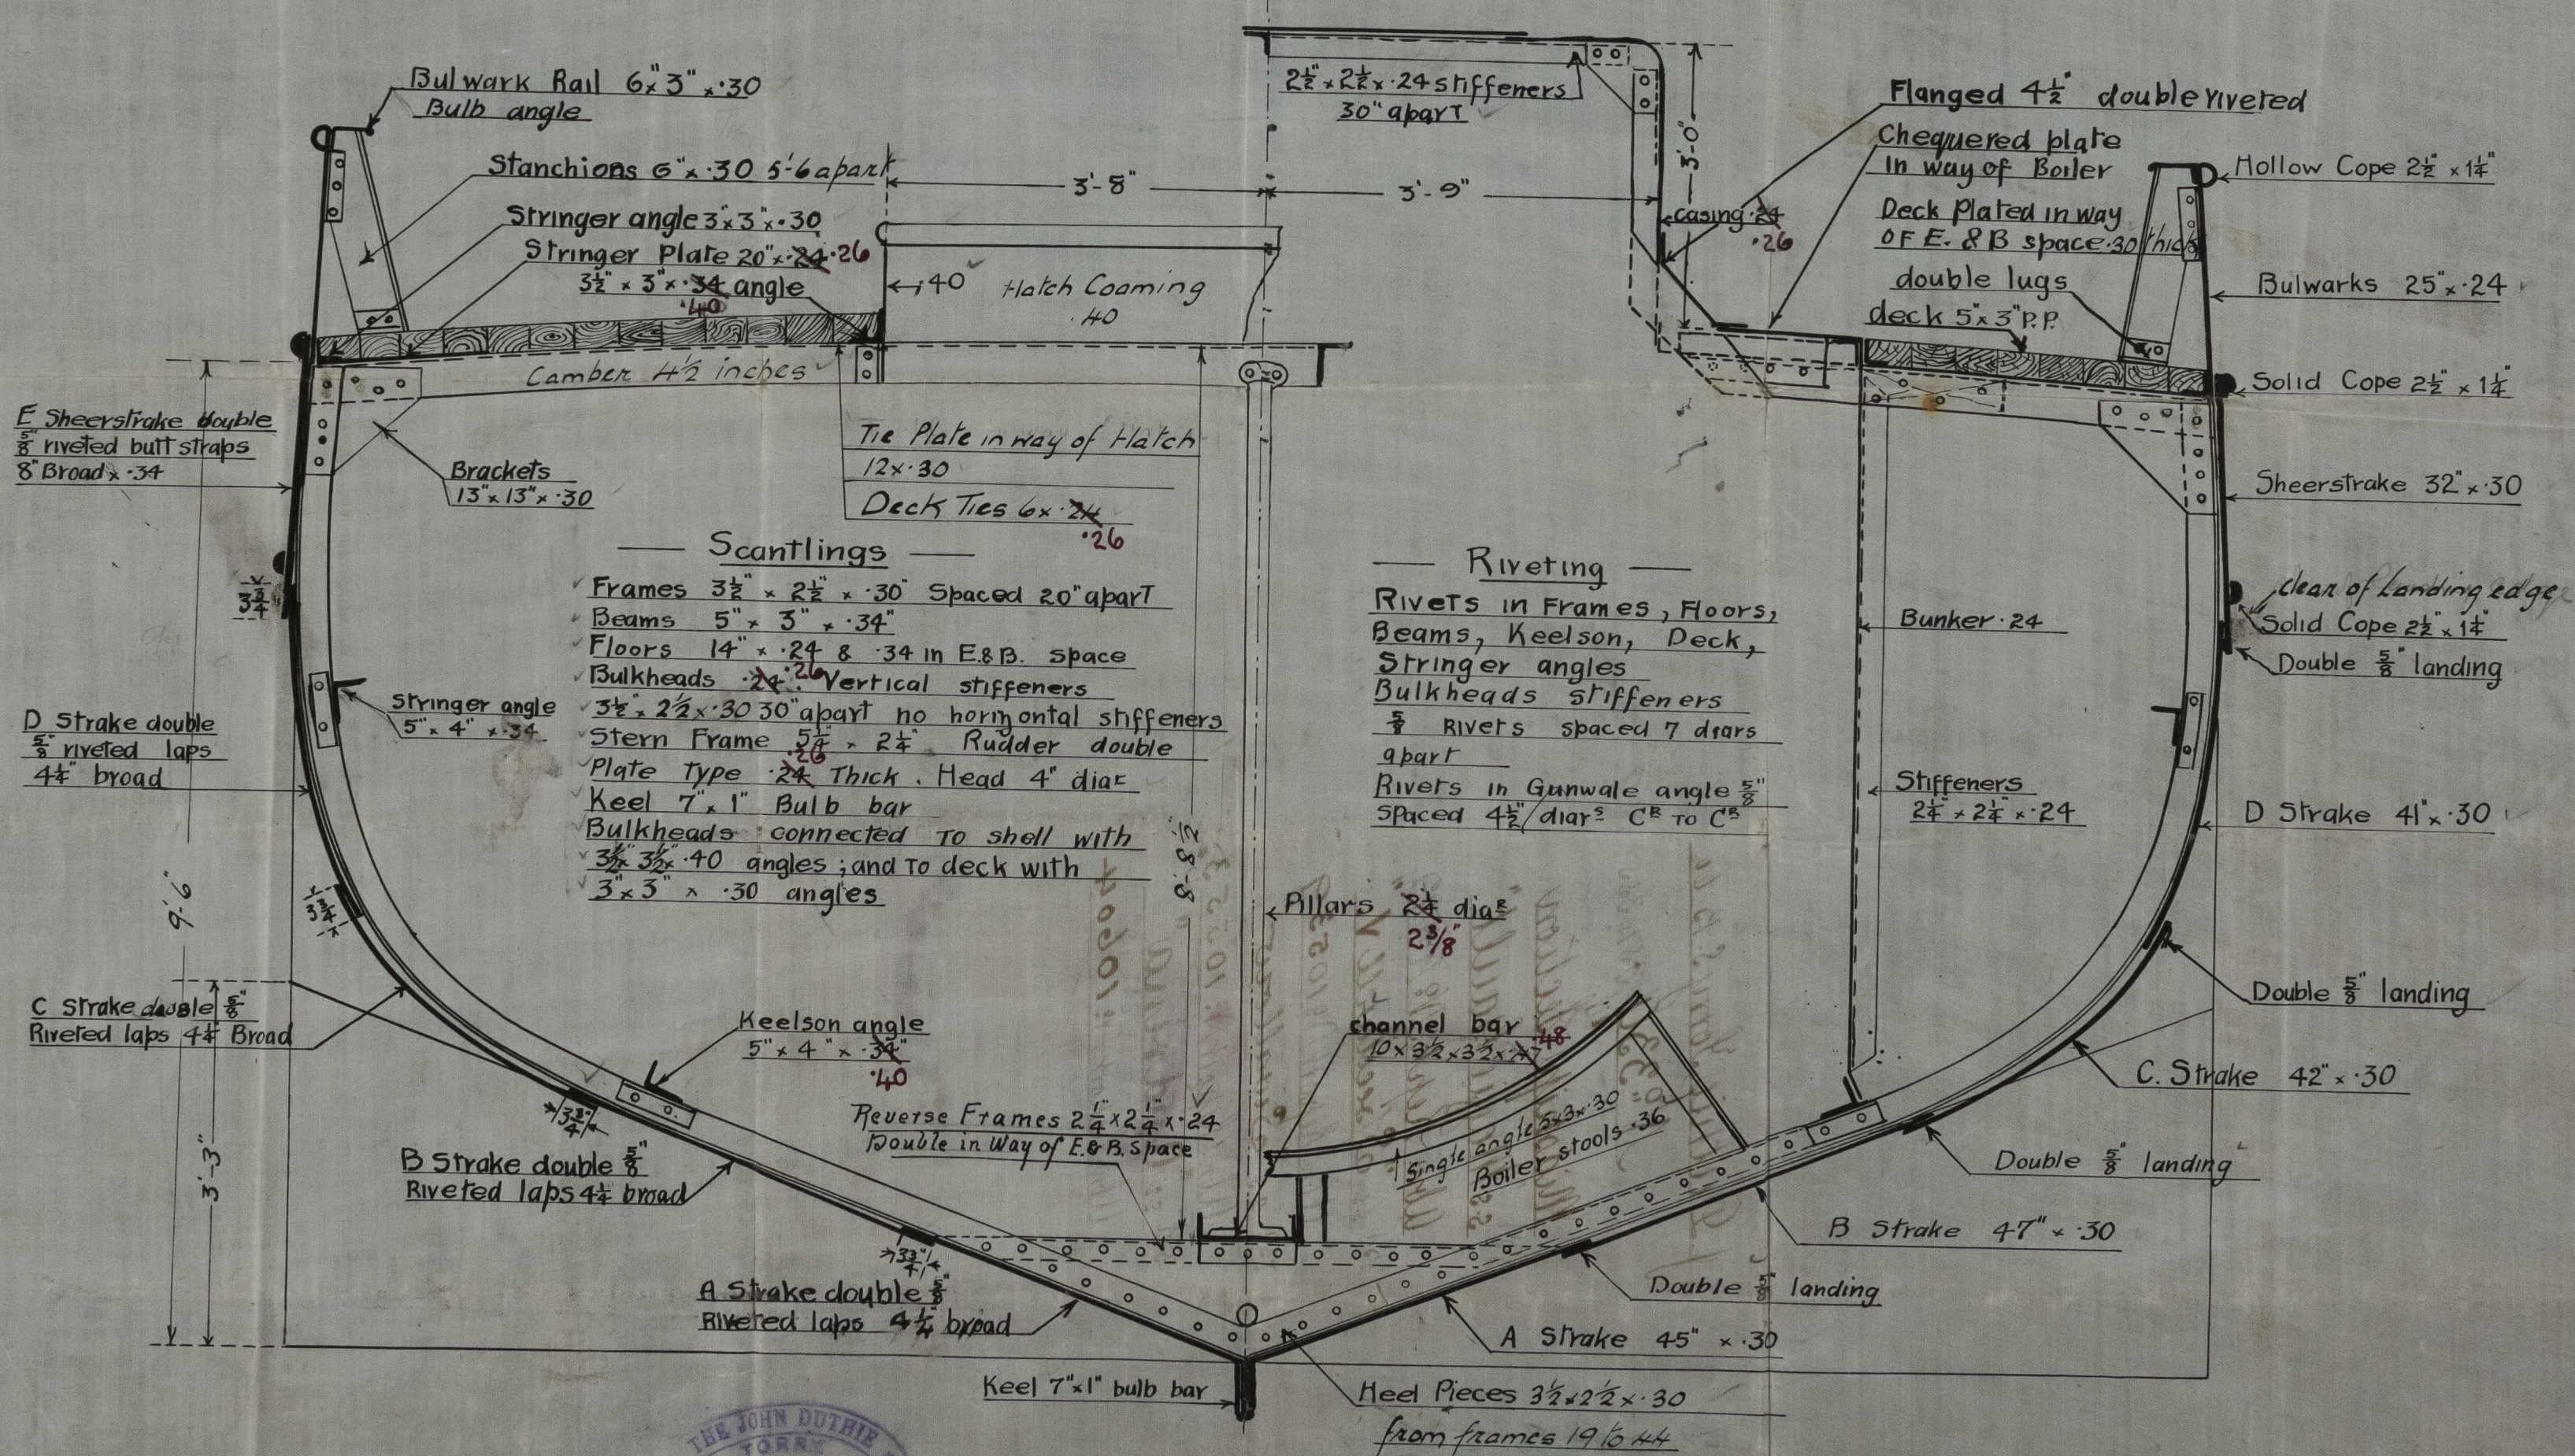

SCALE 3/4" = 1 FOOT



C7.
28/2/10

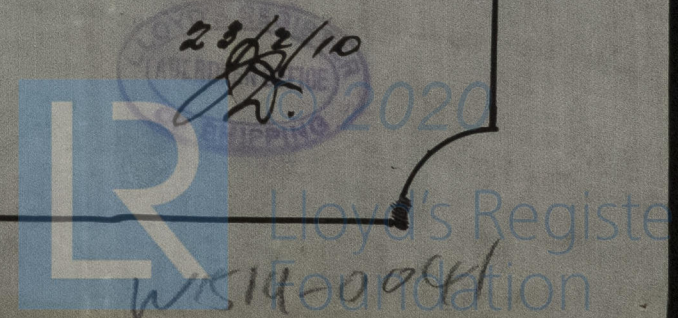

J. Guthrie, Torry S. B. Co.

N^o 339, 354, 355.

Midship Section
339 ss. "Maggie Gault"

Abn. Rept. N^o 10242

354 ss. "S. Sedwell V."

Abn. Report N^o 10539

355 ss. "Swallow"

Abn. Report N^o 10553.

359 ss. "Andrina"

Abn. Report N^o 10604


Foundation