

FROM
DUBLIN DOCKYARD CO.,
FOR ENCLOSURE TO
J. Mac William Esq.

— MIDSHIP SECTION. —

— FISHERY-S.S. N^o 80 AND 81 —

9.12.12

— Equipment —

2 BOWER ANCHORS EACH 12/0CMTS STOCKLESS
1 " " 10 1/2 " " "
1 STREAM " 4 " EX STOCK
1 KEDGE " 1 3/4 " " "
195 FRAYS 1 7/16 DIA^s STUD CHAIN CABLE
60 " 2 3/4 " STEEL WIRE
45 " 2 3/4 " TONLINE
90 " 6 " MANILLA

DIMENSIONS 16'-10" B.P. x 26'-10" M.D. x 13'-11" M.D.

SCALE 1/2" = ONE FOOT.

TO CLASS 100A.1. LLOYDS SPECIAL SURVEY.


— LLOYDS NUMERALS —

B 26.83
D 13.92
L 40.75 1st No
161.83 2nd No
6594.57 2nd No
Erections 446.09
4040.66 EQUIPMENT N^o

— ERECTIONS —

BRIDGE DECK 11'-0" x 4'-5" x 45 61.83
" HOUSE 35'-66" x 4'-5" x 3 219.94
FIDE DECK 34'-0" x 4'-0" x 45 194.25
446.09
6594.57
4040.66



d = 12 1/4" ORD FLOORS
d = 10.92 TANK 4/0 = 11.63
d = 3.21 LOWER DECK

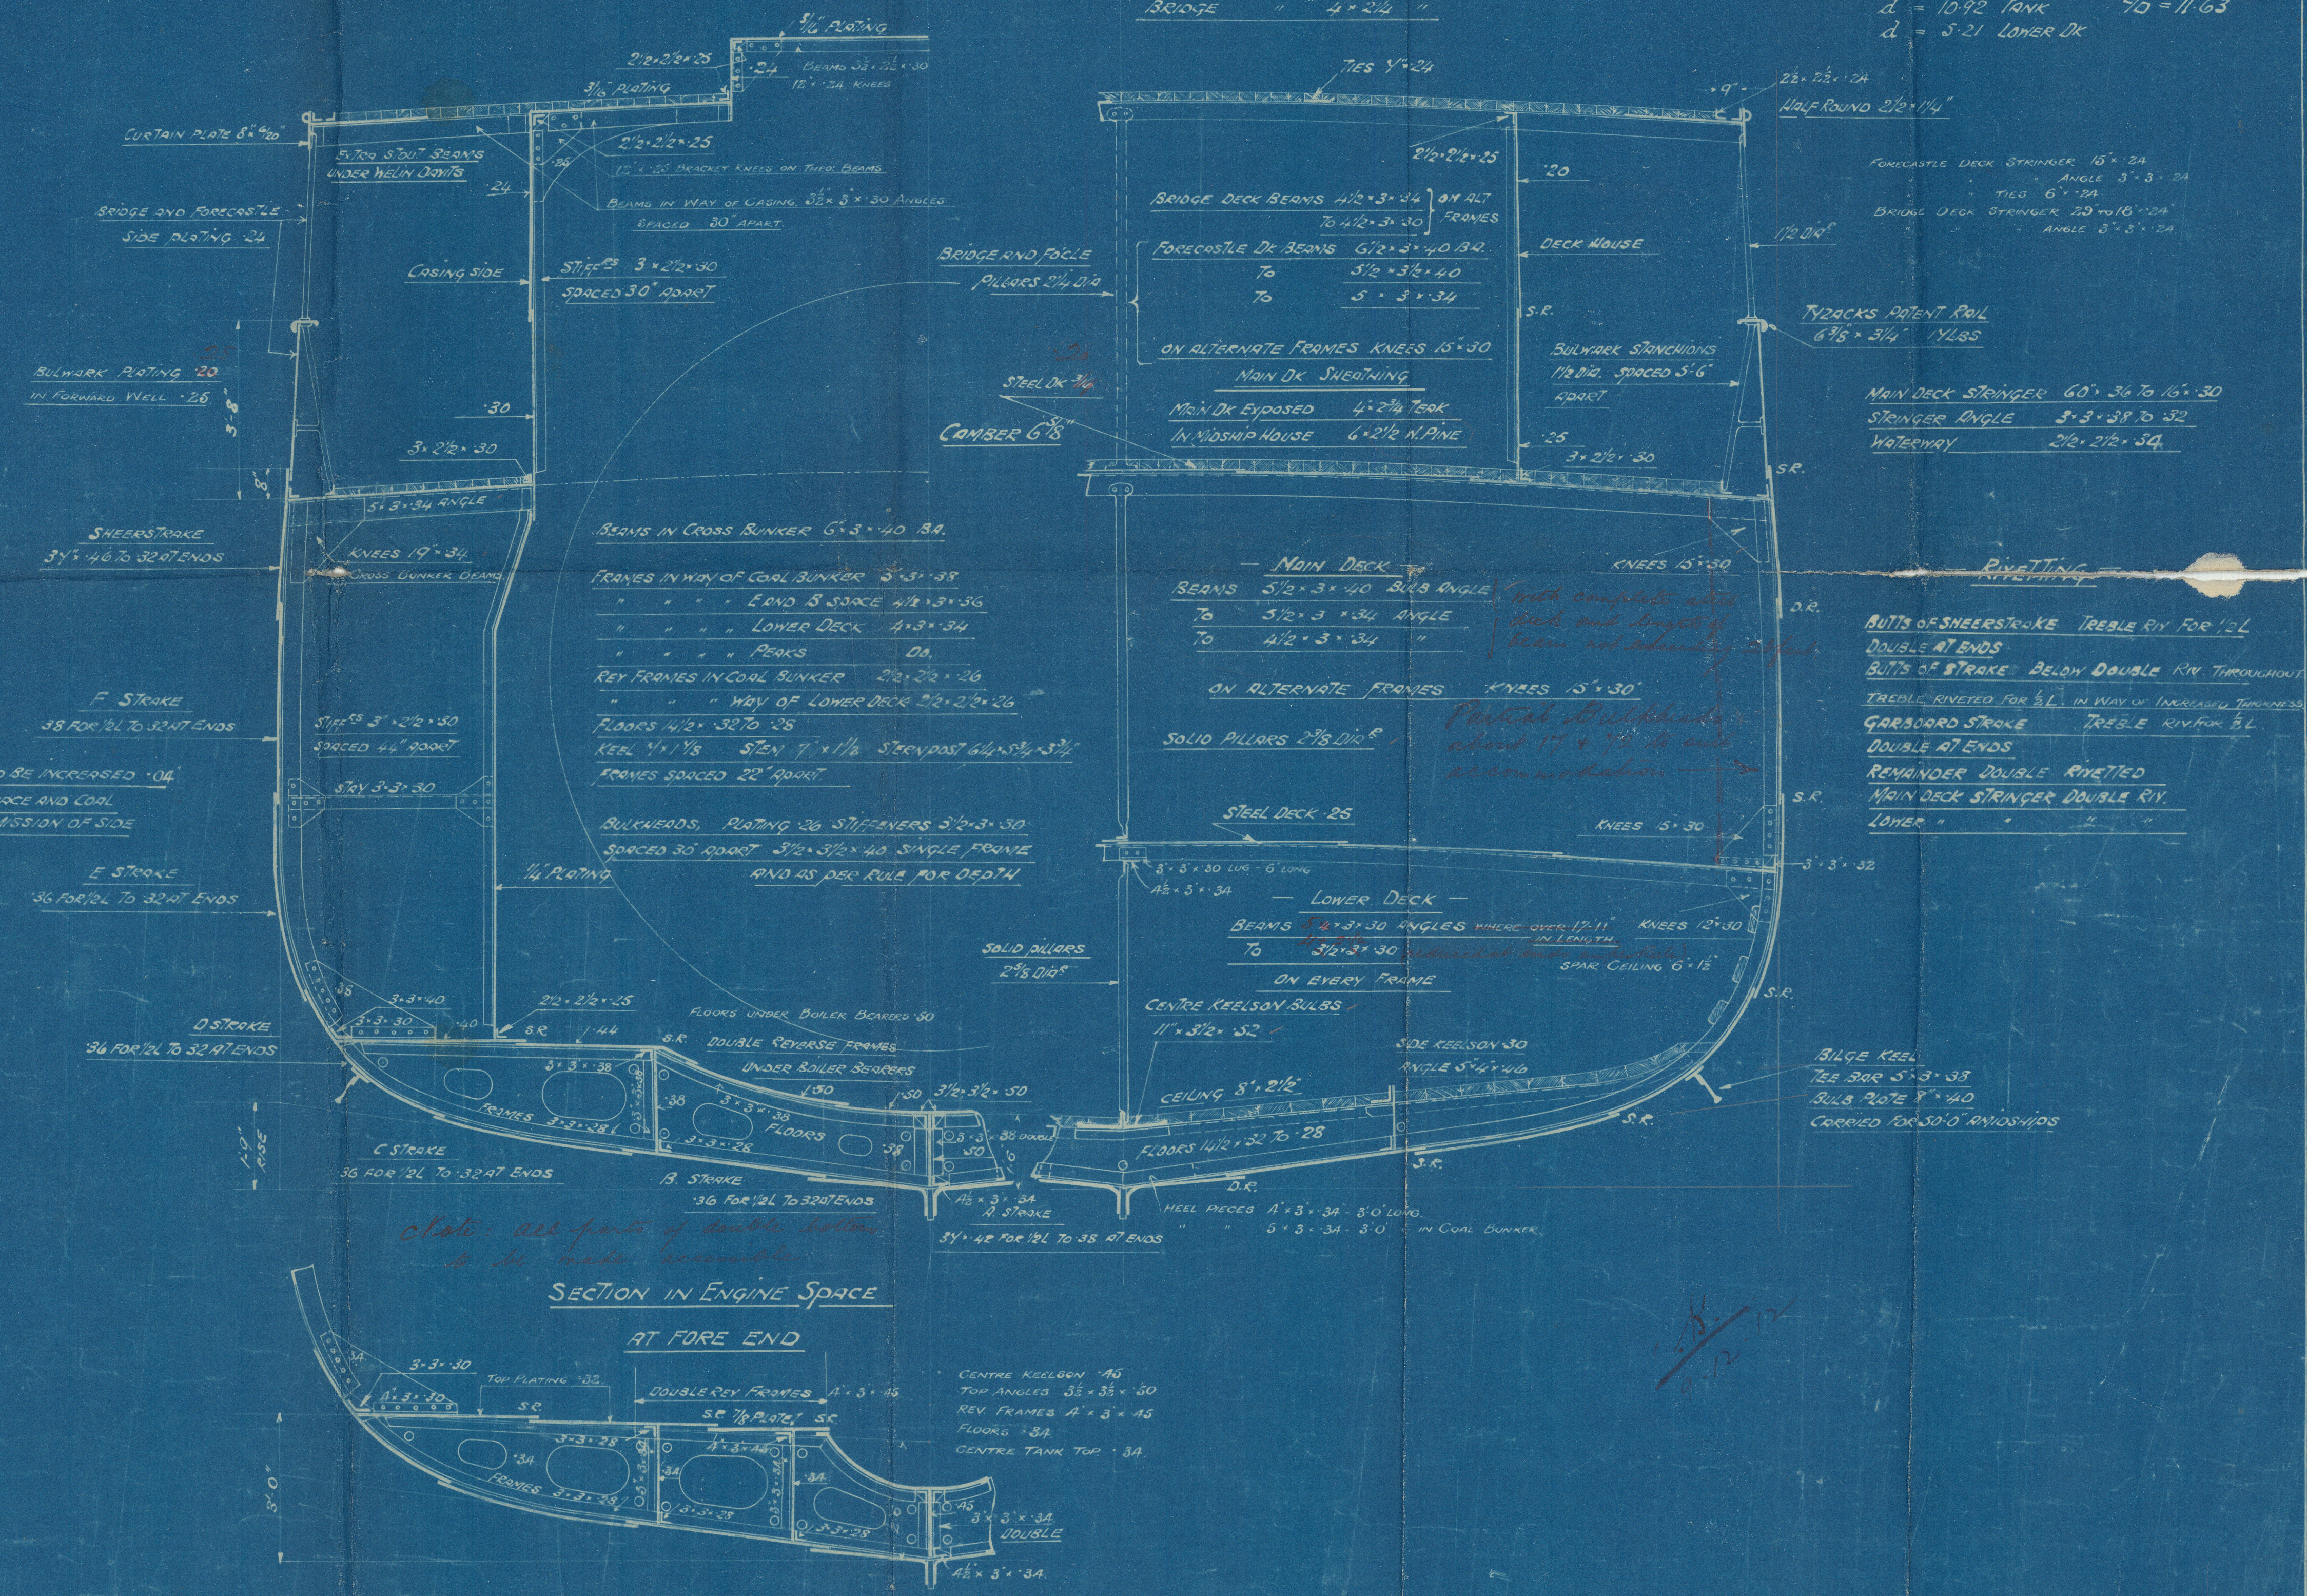

(Second) Amended
Midship Section
Dublin Dockyard Cos
80. + 81.

Lower Deck a
W.T. Flt.

Sh. 'Malipina' Dub 3/12/12
Jm
4-DEC 1912
Dub 5287.

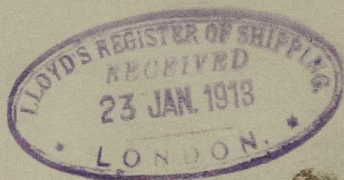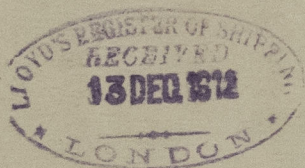

REMAIN



© 2010

Lloyd's Register
Foundation

W 1504-0140