


TENSILE OF SHELL PLATES		28.5 TO 32.5 TONS
"	" FLANGE "	26.0 " 30.0 "
"	" FURNACES	26.0 " 28.0 "
"	" MAIN STAYS	28.0 " 32.0 "
"	" SCREW "	26.0 " 30.0 "
"	" RIVET BARS	26.0 " 30.0 "

28/5/69

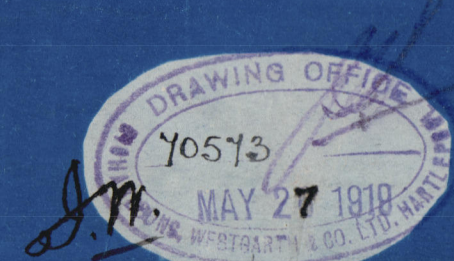



Mar. Charles Hill Lane 137-8

Rvt Lr. 2614-2615

No 137

No 3548  
Lloyd's Tent  
360 <sup>th</sup>  
WP 180 <sup>th</sup>  
7/11/19 A.B.

West Hartlepool  
Report No. 15717

"Blink"  
Ex  
Arlette

No 138.

No 3560  
Lloyd's Tent  
360 <sup>th</sup>  
WP 180 <sup>th</sup>  
30/6/20 A.B.

West Hartlepool  
Report No. 15748.



© 2019

Lloyd's Register  
Foundation

W152-0060