

T.S.S. MACQUARIE.

N<sup>o</sup>. 551.

## MIDSHIP SECTION

PRINCIPAL DIMENSIONS 160'-0" B.P. x 29'-0" EX. x 9'-6" MLE

$\frac{1}{2}$  = ONE FOOT.

CLASS. A.I. LLOYDS FOR AUSTRALIAN COASTING SERVICE  
"RICHMOND RIVER TO EDEN" WITH FREEBOARD.

## LLOYD'S NUMERALS

1/2 BEAM 14.46

DEPTH 10.10

1/2 GIRTH 22.34

46.90 = FRAME №.

159 = LENGTH.

4221

2345

469

7457.1 = PLATING N°

PLATING N<sup>o</sup> = 7457

POOP  $86 \times 7.12 \times 1.5 = 920$

$$F'_{CLE} = 26.25 \times 7.12 \times 1.5 = 280$$

8657 = EQUIPMENT №

### EQUIPMENT.

2 BOWER ANCHORS EACH 10 $\frac{1}{4}$  CWT. STOCKLESS.

1 " ANCHOR 8 3/4 " "

1 STREAM " 3 1/2 " Ex. STOCK.


1 KEDGE	1 1/2	"	"	"
---------	-------	---	---	---

165 FATHOMS  $1\frac{1}{16}$ " STUD LINK CABLE.

60      2 $\frac{3}{4}$ " STREAM WIRE HAWSER.

75 " 2 1/2" STEEL " TOWLINE.

90 " 5  $\frac{1}{2}$ " MANILLA HAWSER.

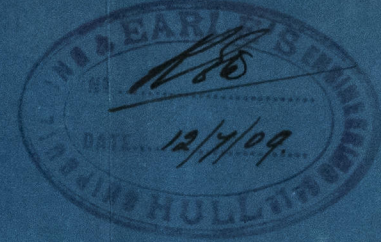



Earle's Co.  
No 551.  
Amended  
Midship Section.

s/s Macquarie  
Hull Report No.



Marie Muller

RETAIN



© 2021

Lloyd's Register  
Foundation

W1520-0146