



Profile  
 Boonville  
 Pa  
 of  
 1888

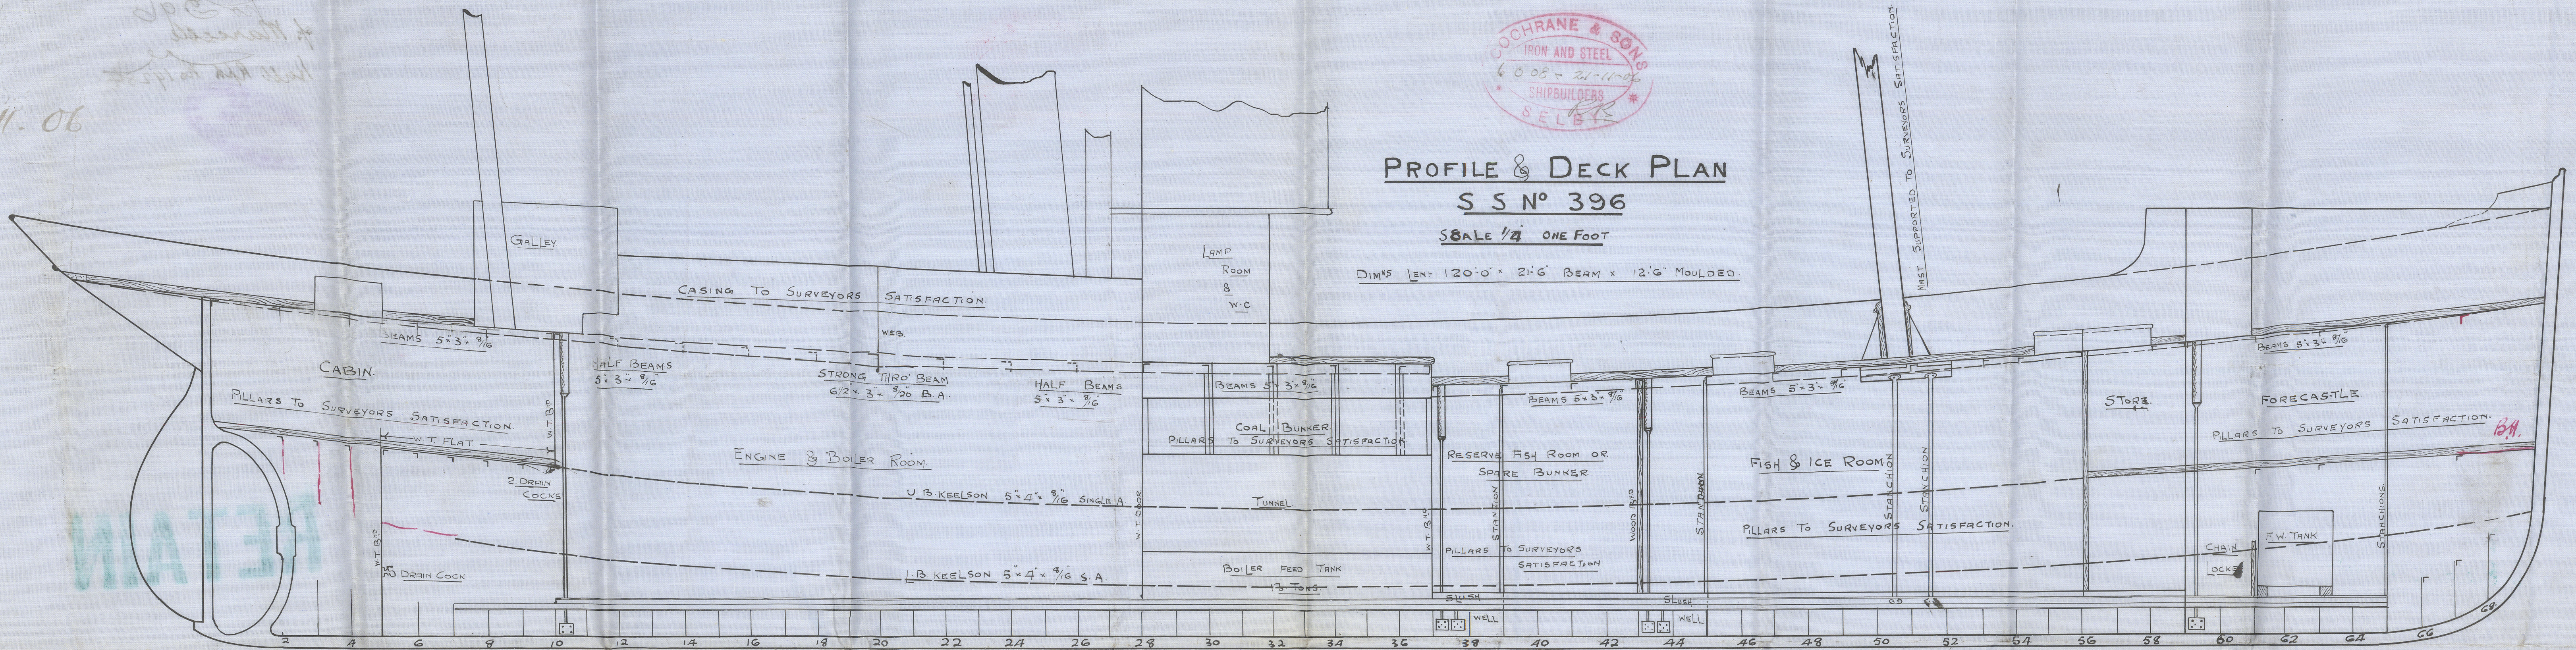

Pillars throughout to Satisfaction  
of surveyor.

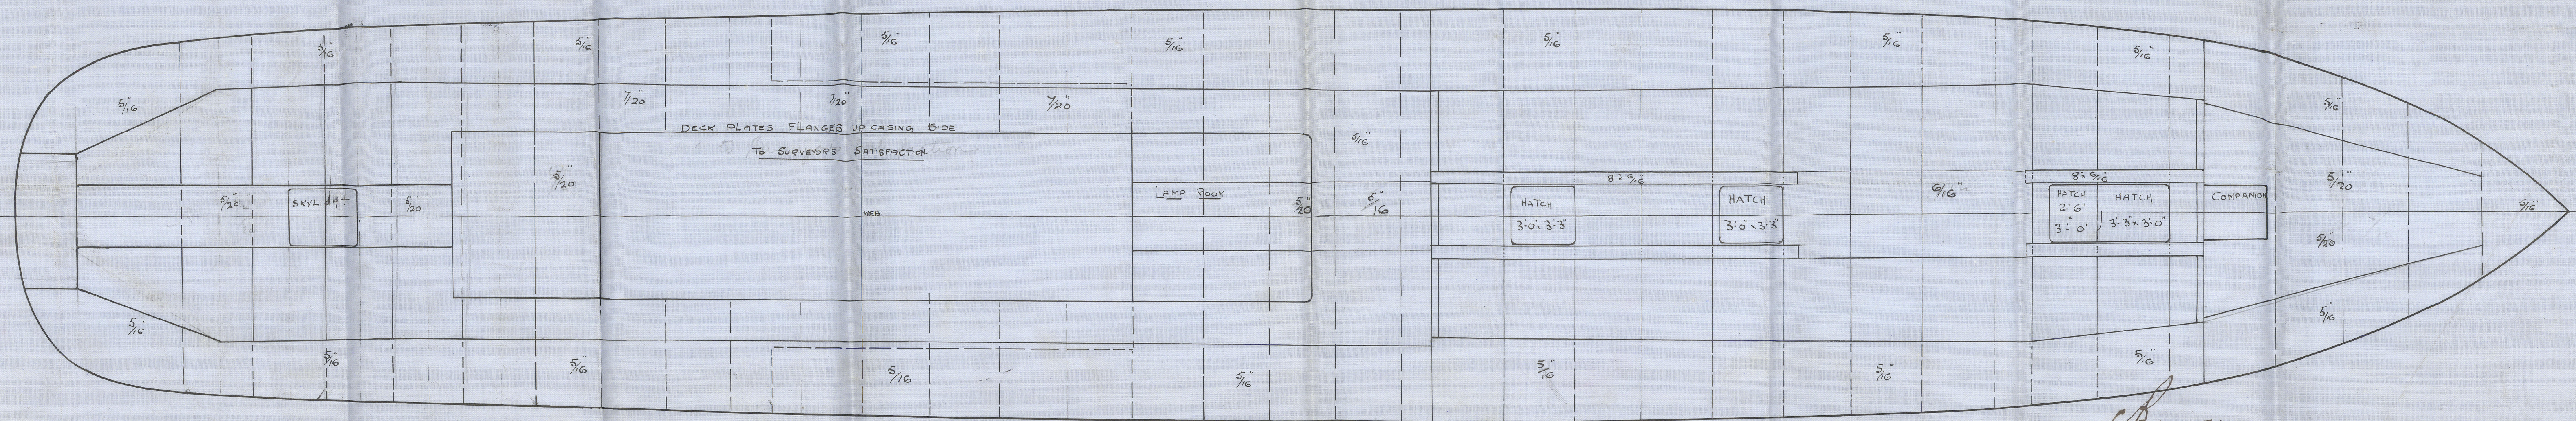

С.Д.  
26. 11. 06.



Profile

Cochrane & Sons

No 396  
of Marcell

Hull Rph No 19284

RETAIN



© 2021

Lloyd's Register  
Foundation

W1521-0011