

76-11-06

MIDSHIP SECTION.

STEEL SCREW TRAWLER.

Nº 396.


DIM^S 120'-0" B.P. x 21'-6" EX x 12'-6" DEPTH MOULDED.

To CLASS 100.A.I. AT LLOYD'S FOR FISHING PURPOSES.

ENGINE & BOILER CASING AS PREVIOUSLY APPROVED.

SCALE $\frac{1}{2}$ " = 1 FOOT.

DECK PLATED AT SIDES OF E & B. CASING.

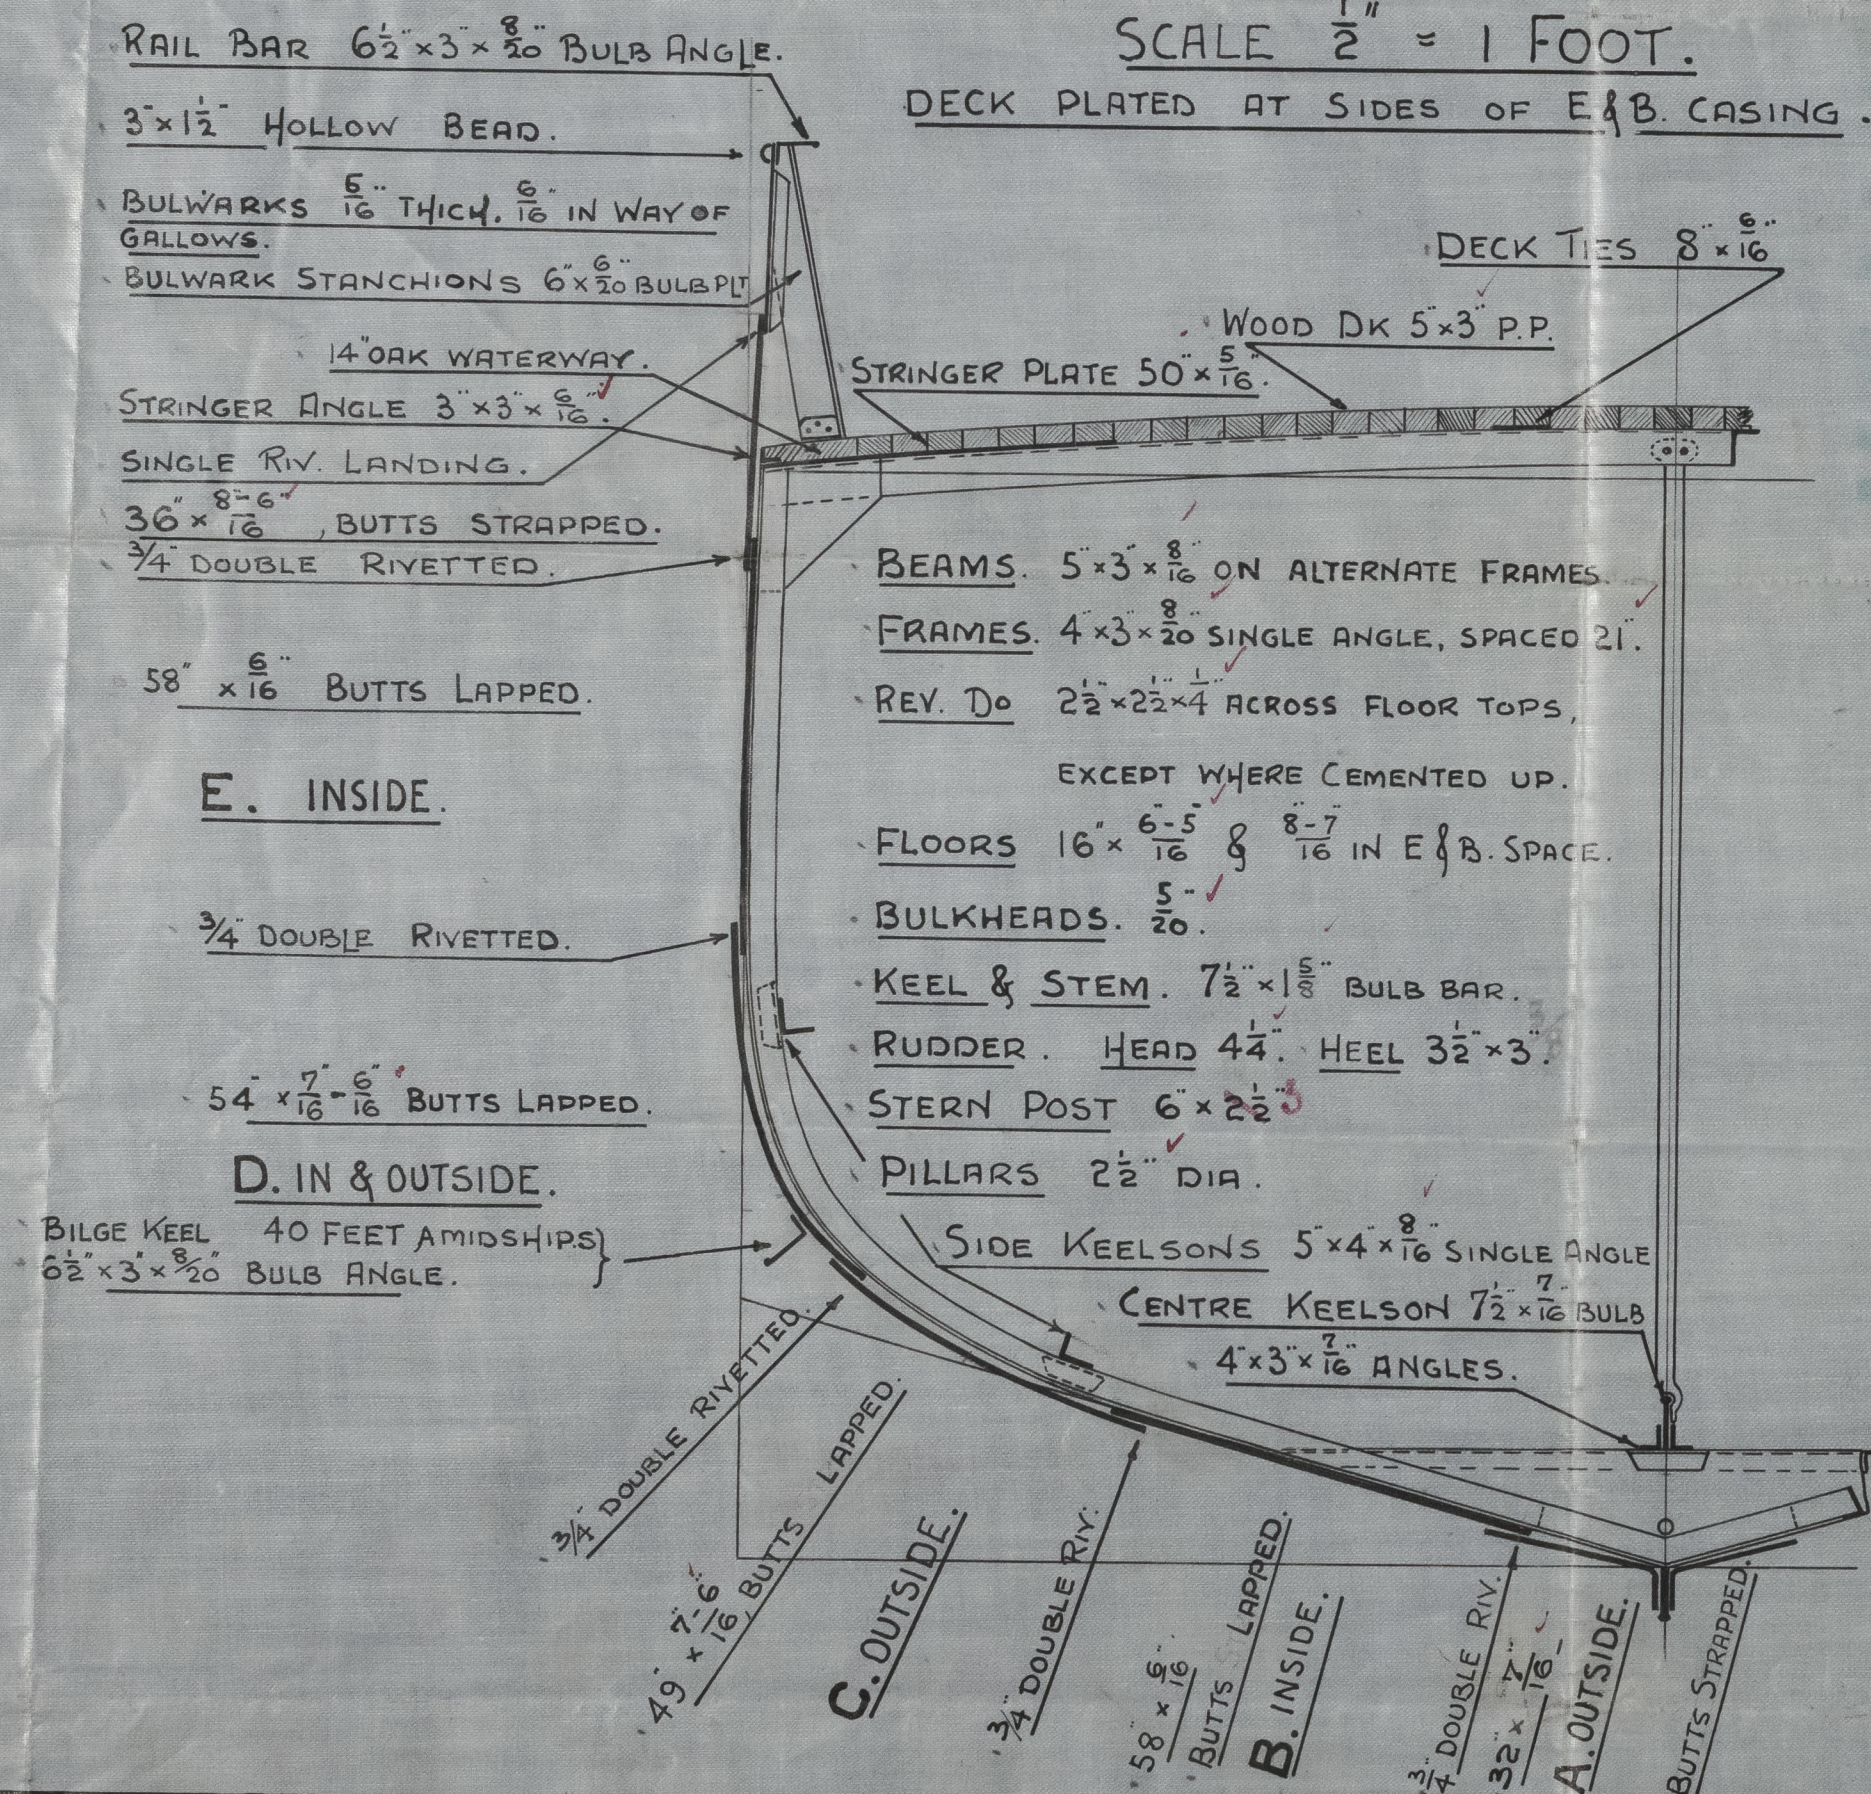

PROPORTIONS.


DEPTH	To	LENGTH	9.1.
BREADTH	To	"	5.5.

LLOYDS NUMERALS

$\frac{1}{2}$ GIRTH	19.63	✓
$\frac{1}{2}$ BREADTH	10.70	✓
DEPTH	12.94	✓
	43.27	1st No.
LENGTH AS PER RULE	119.0	✓
	5149.13	2nd No.

EQUIPMENT.

1 STOCKLESS ANCHOR	6 1/2 CWTs	
2 ND BOWER	4 3/4	EX STOCK
3 RD "	2 1/2	"
90 FATHOMS	1"	CABLE
60 "	6"	HAWSER
60 "	4 1/2	WARP.

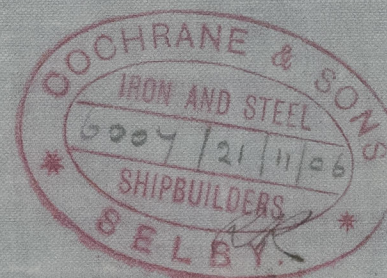

COCHRANE & SONS
SHIPBUILDERS.
SELBY.



© 2021

Lloyd's Register
Foundation

11521-002

Midship Section
Cochrane & Sons
No 396
s/s Marcelle
Hall Rpt No. 19284



RETAIN



NO. 396
MIDSHIP SECTION

W1521-0012