

# Suction Dredger 96: 313.





118-10

SCALE 1:20

J MEYER'S SHIPBUILDING CO. P.C.

ZALT-BOMMEL

HOLLAND

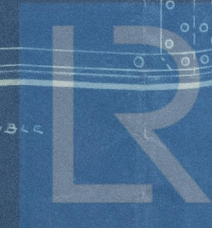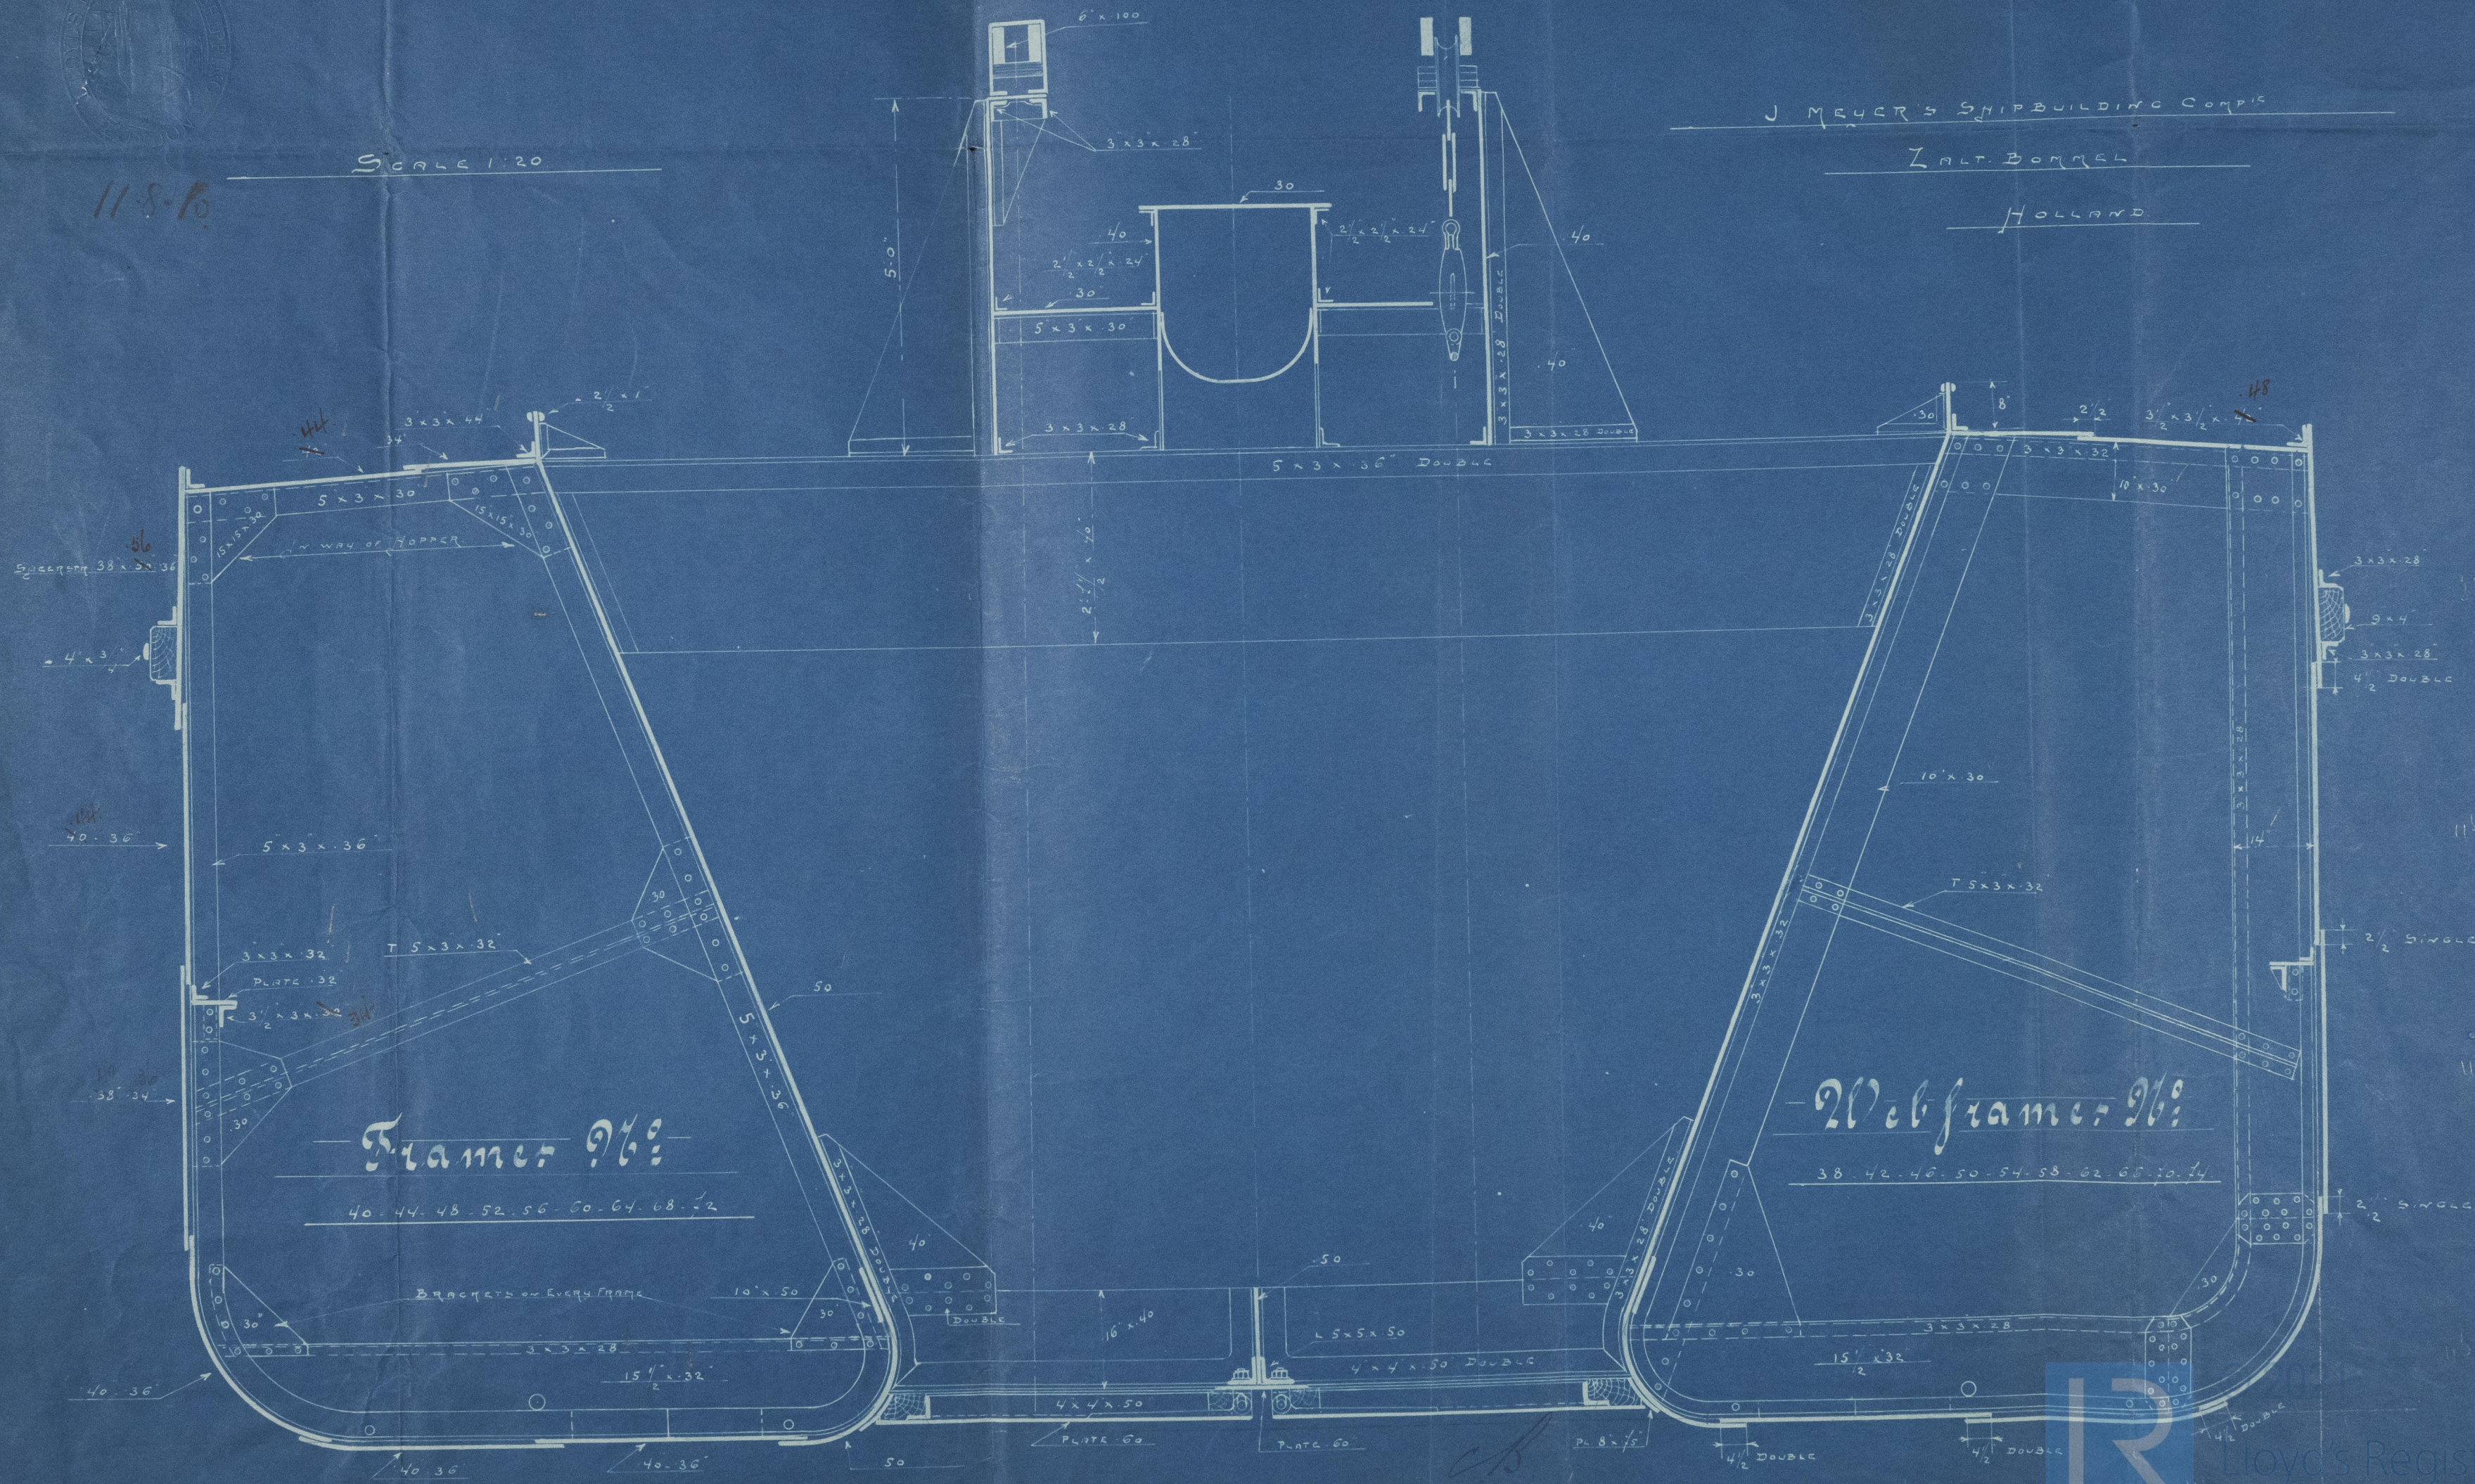

Lloyd's Register  
Foundation





J. Meyer & Co. 87313

Middlesex

H. H. D. "Maranhão"

Aug 49 31

RETAIN



© 2021

Lloyd's Register  
Foundation

W1521-0066