



1st sheet of 9 sheets  
 will not be used  
 15-11 x 0.05 x 0.05  
 25.7.02  
 28.8.02  
 4.9.02

— PLAN OF MAIN AND QUARTER DECKS. —  
 — S. S. 250-6 x 36-0 x 17-2. —

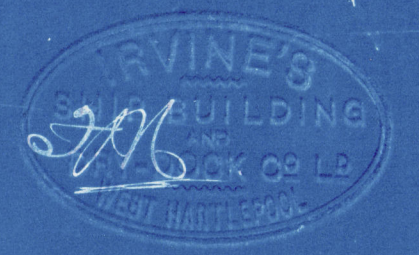

JPL  
 25/11/02

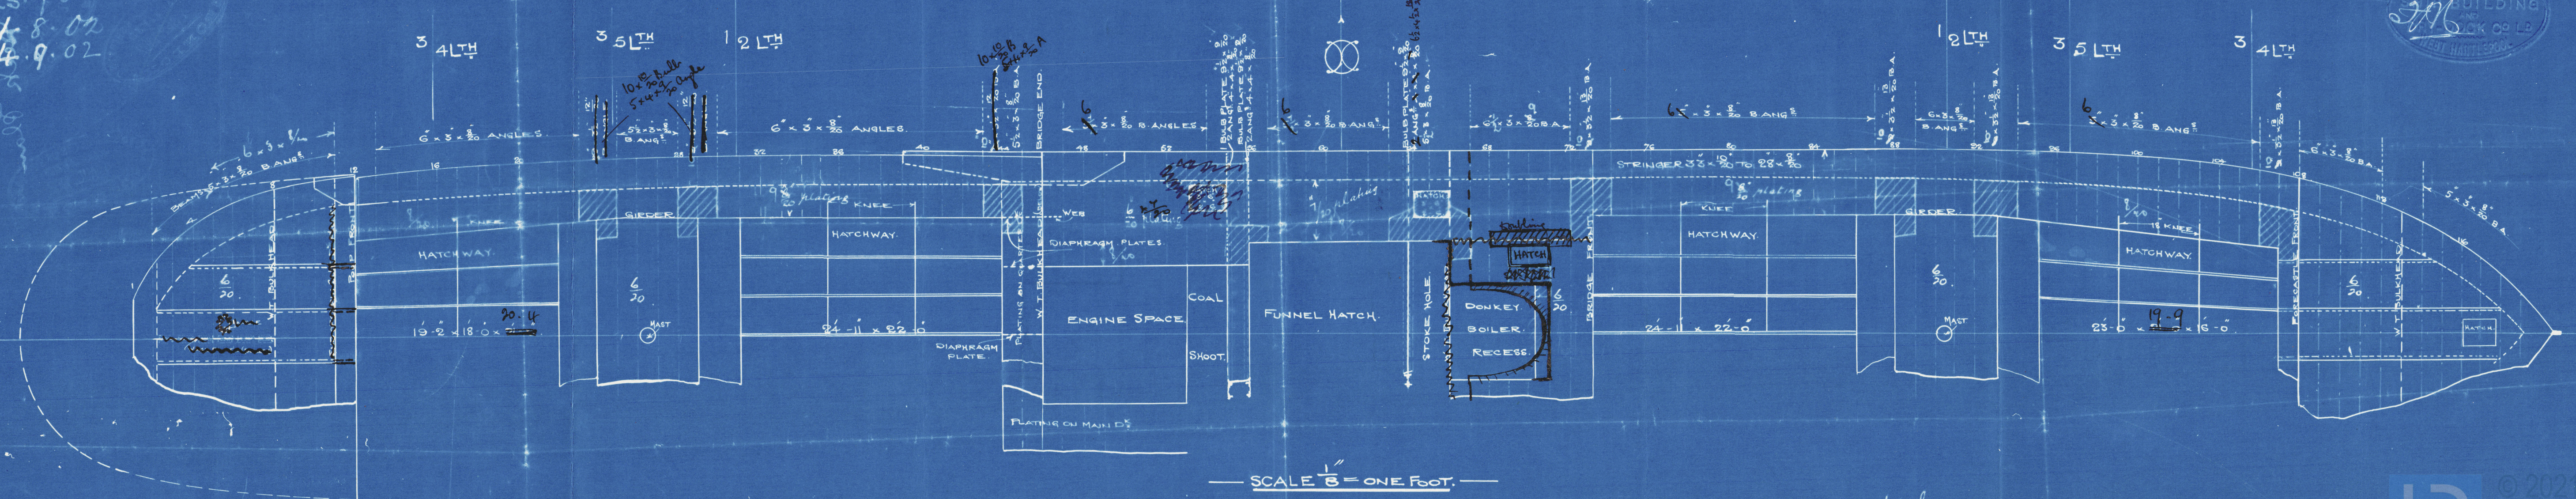

Irvine's 8B. & Cofa

No 128

Main & Quarter Deck Plan

"Sirius"

Hpl. Report to 12064

RETAIN

W1525-0181



© 2021

Lloyd's Register  
Foundation